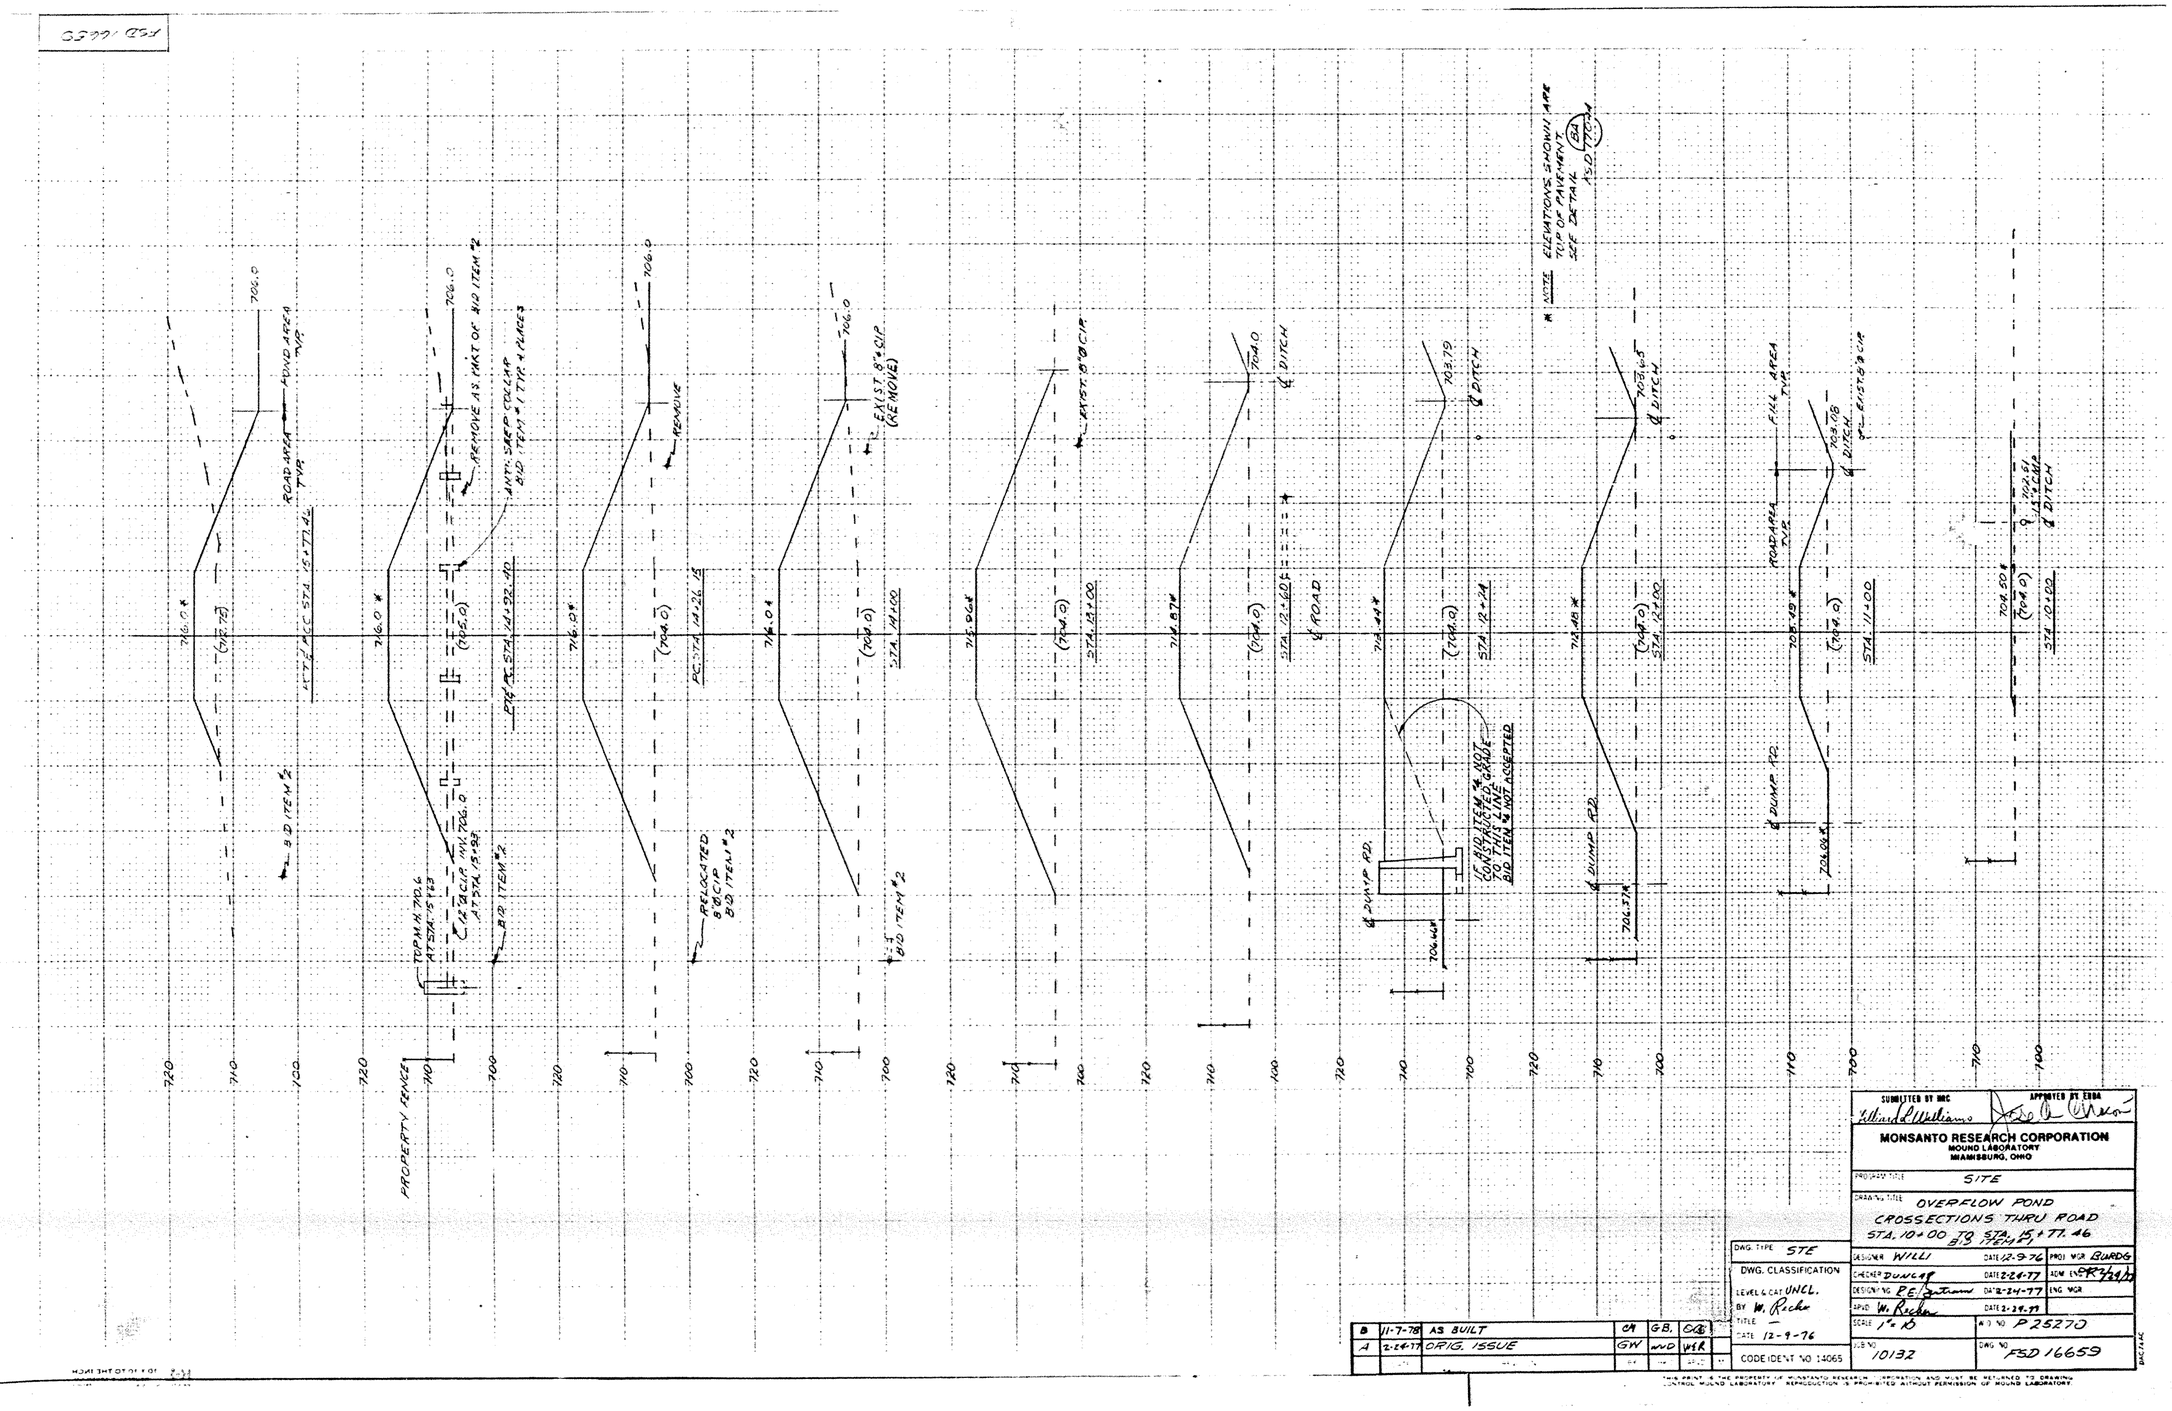

B	11-7-78	AS BUILT	CA	GB.	GB
A	2-24-77	ORIG. ISSUE	GW	WND	WER

SUBMITTED BY MRC: Willard L. Williams
APPROVED BY ERDA: [signature]

MONSANTO RESEARCH CORPORATION
MOUND LABORATORY
MIAMISBURG, OHIO

PROGRAM TITLE: SITE

DRAWING TITLE: OVERFLOW POND CROSSECTIONS THRU ROAD STA. 10+00 TO STA. 15+77.46 BID ITEM #1

DWG. TYPE: STE
DWG. CLASSIFICATION
LEVEL & CAT: UNCL.
BY: W. Recker
TITLE: —
DATE: 12-9-76
CODE IDENT NO 14065

DESIGNER: WILLI	DATE: 12-9-76	PROJ MGR: BURDG	
CHECKER: DUNCAN	DATE: 2-24-77	ADM ENGR: [signature] 2/24/77	
DESIGNING: R.E. Bertram	DATE: 2-24-77	ENG MGR	
APVD: W. Recker	DATE: 2-24-77		
SCALE: 1" = 10'	W.O. NO: P 25270		
JOB NO: 10132	DWG NO: FSD 16659		

THIS PRINT IS THE PROPERTY OF MONSANTO RESEARCH CORPORATION AND MUST BE RETURNED TO DRAWING CONTROL MOUND LABORATORY. REPRODUCTION IS PROHIBITED WITHOUT PERMISSION OF MOUND LABORATORY.