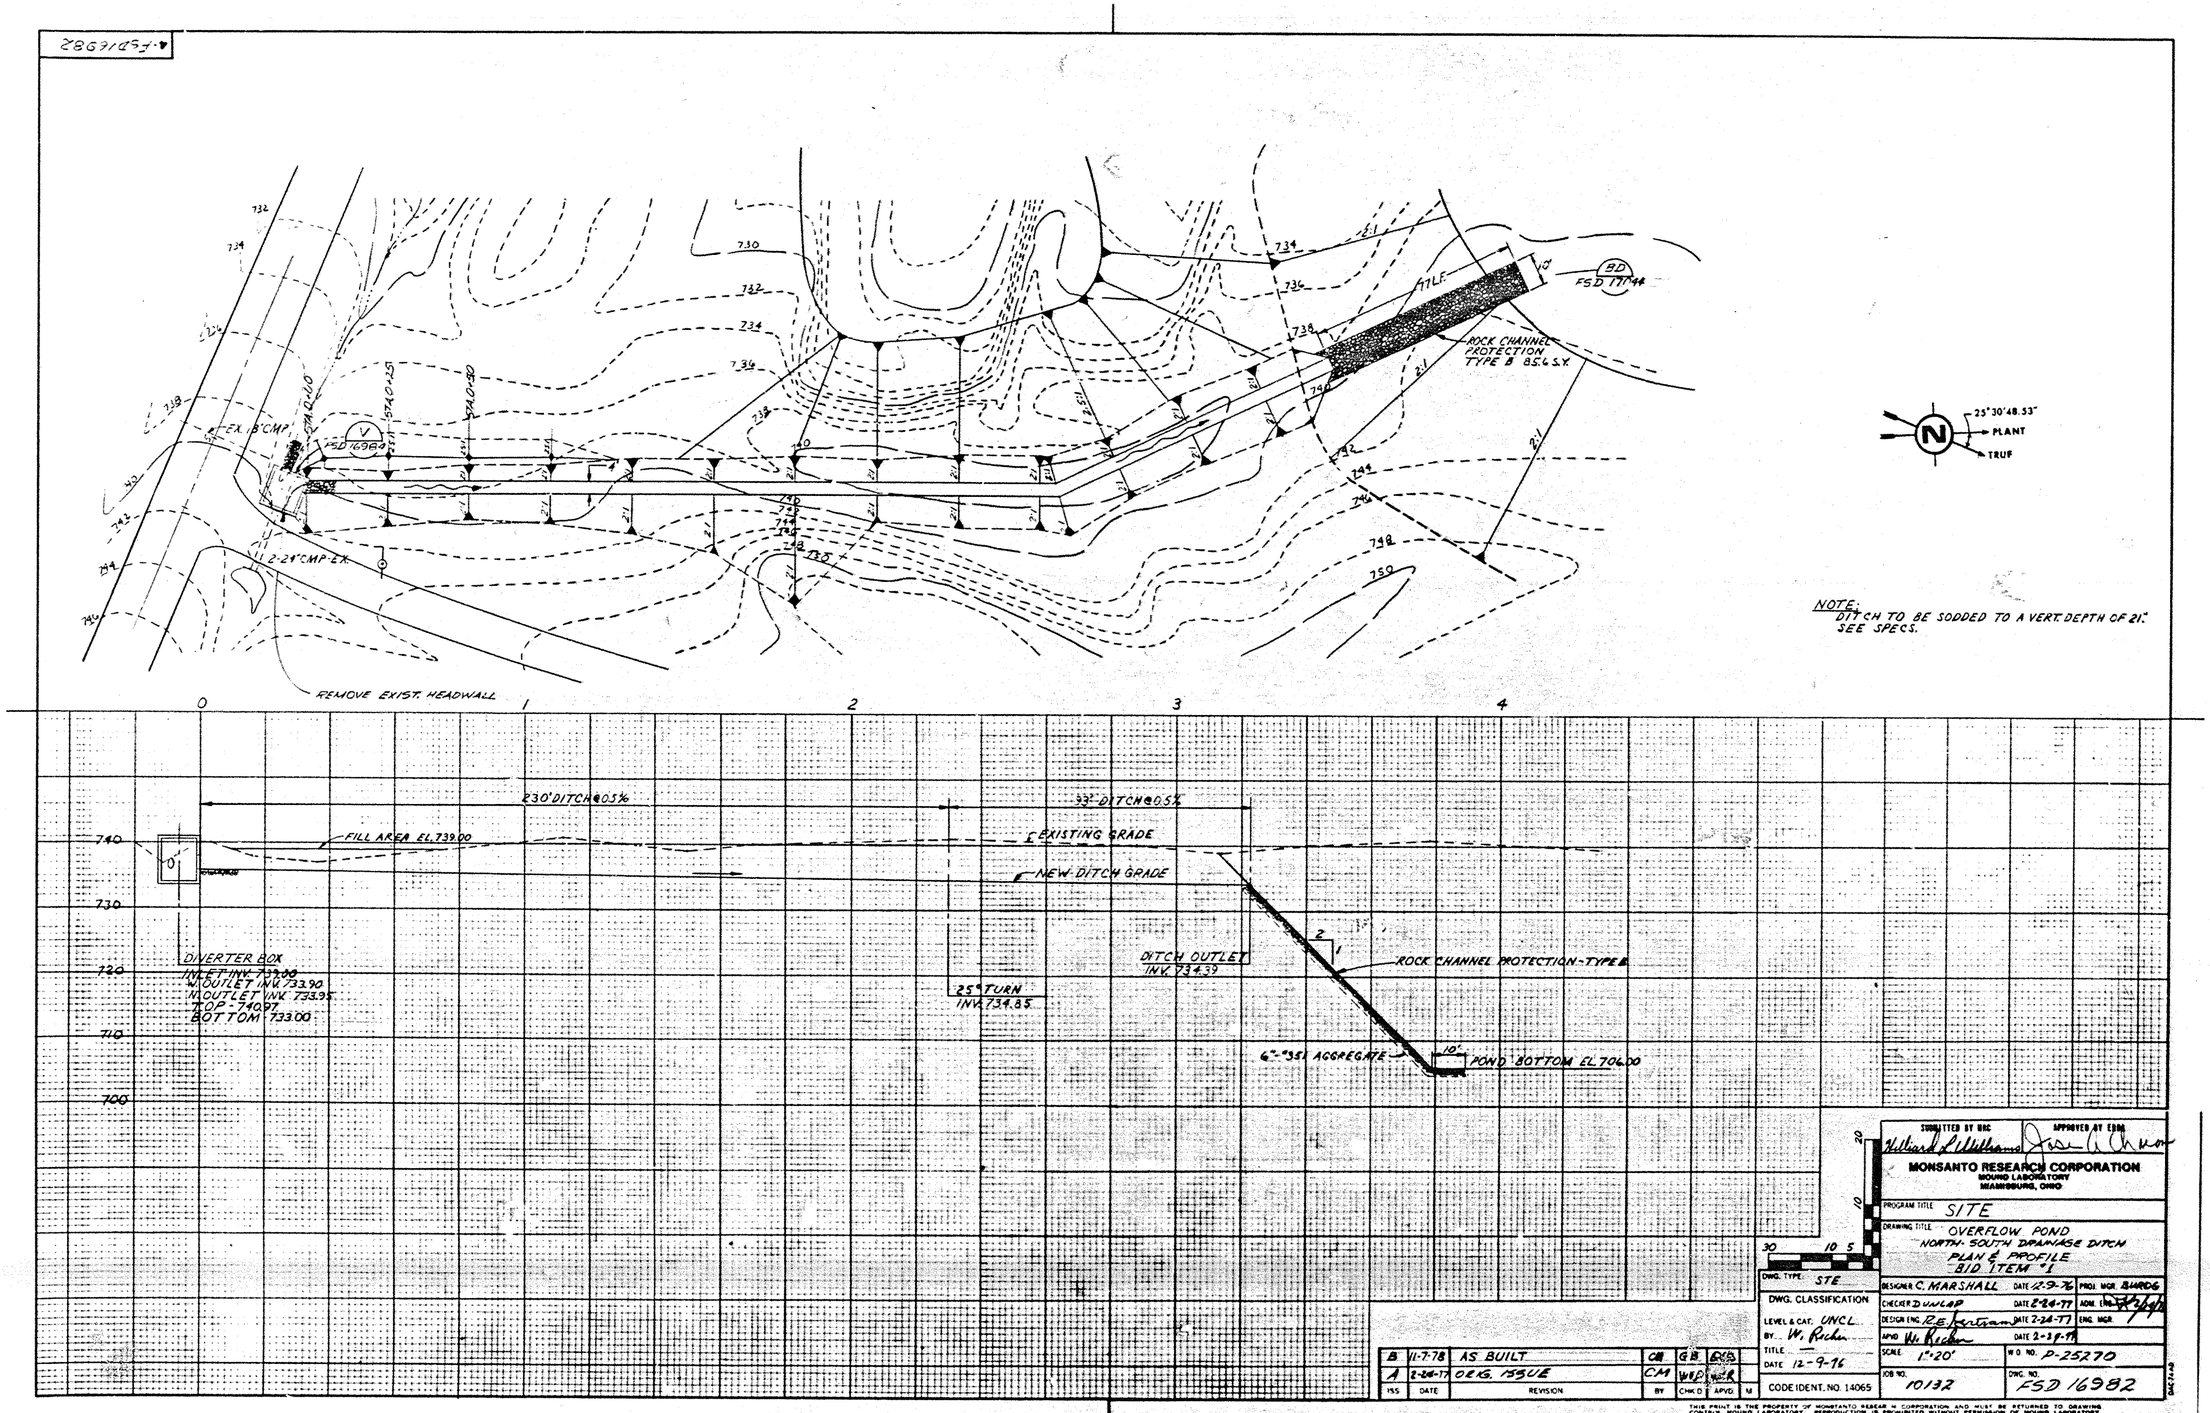

ISS	DATE	REVISION	BY	CHK'D	APV'D	M
B	11-7-78	AS BUILT	CM	GB	GB	
A	2-24-77	ORIG. ISSUE	CM	WEP	WER	

SUBMITTED BY MRC: Hilliard L. Williams
APPROVED BY EDRA: Jose A. Chacon

MONSANTO RESEARCH CORPORATION
MOUND LABORATORY
MIAMISBURG, OHIO

PROGRAM TITLE: SITE

DRAWING TITLE: OVERFLOW POND NORTH-SOUTH DRAINAGE DITCH PLAN & PROFILE BID ITEM #1

DWG. TYPE: STE

DWG. CLASSIFICATION
LEVEL & CAT.: UNCL.
BY: W. Richer
TITLE: —
DATE: 12-9-76
CODE IDENT. NO. 14065

DESIGNER C. MARSHALL	DATE 12-9-76	PROJ. MGR. BURDG	
CHECKER D. UNLAP	DATE 2-24-77	ADM. ENG.	
DESIGN ENG. R.E. Bertram	DATE 2-24-77	ENG. MGR.	
APVD W. Richer	DATE 2-29-77		
SCALE 1"=20'		W.O. NO. P-25270	
JOB NO. 10132		DWG. NO. FSD 16982	

THIS PRINT IS THE PROPERTY OF MONSANTO RESEARCH CORPORATION AND MUST BE RETURNED TO DRAWING CONTROL MOUND LABORATORY. REPRODUCTION IS PROHIBITED WITHOUT PERMISSION OF MOUND LABORATORY