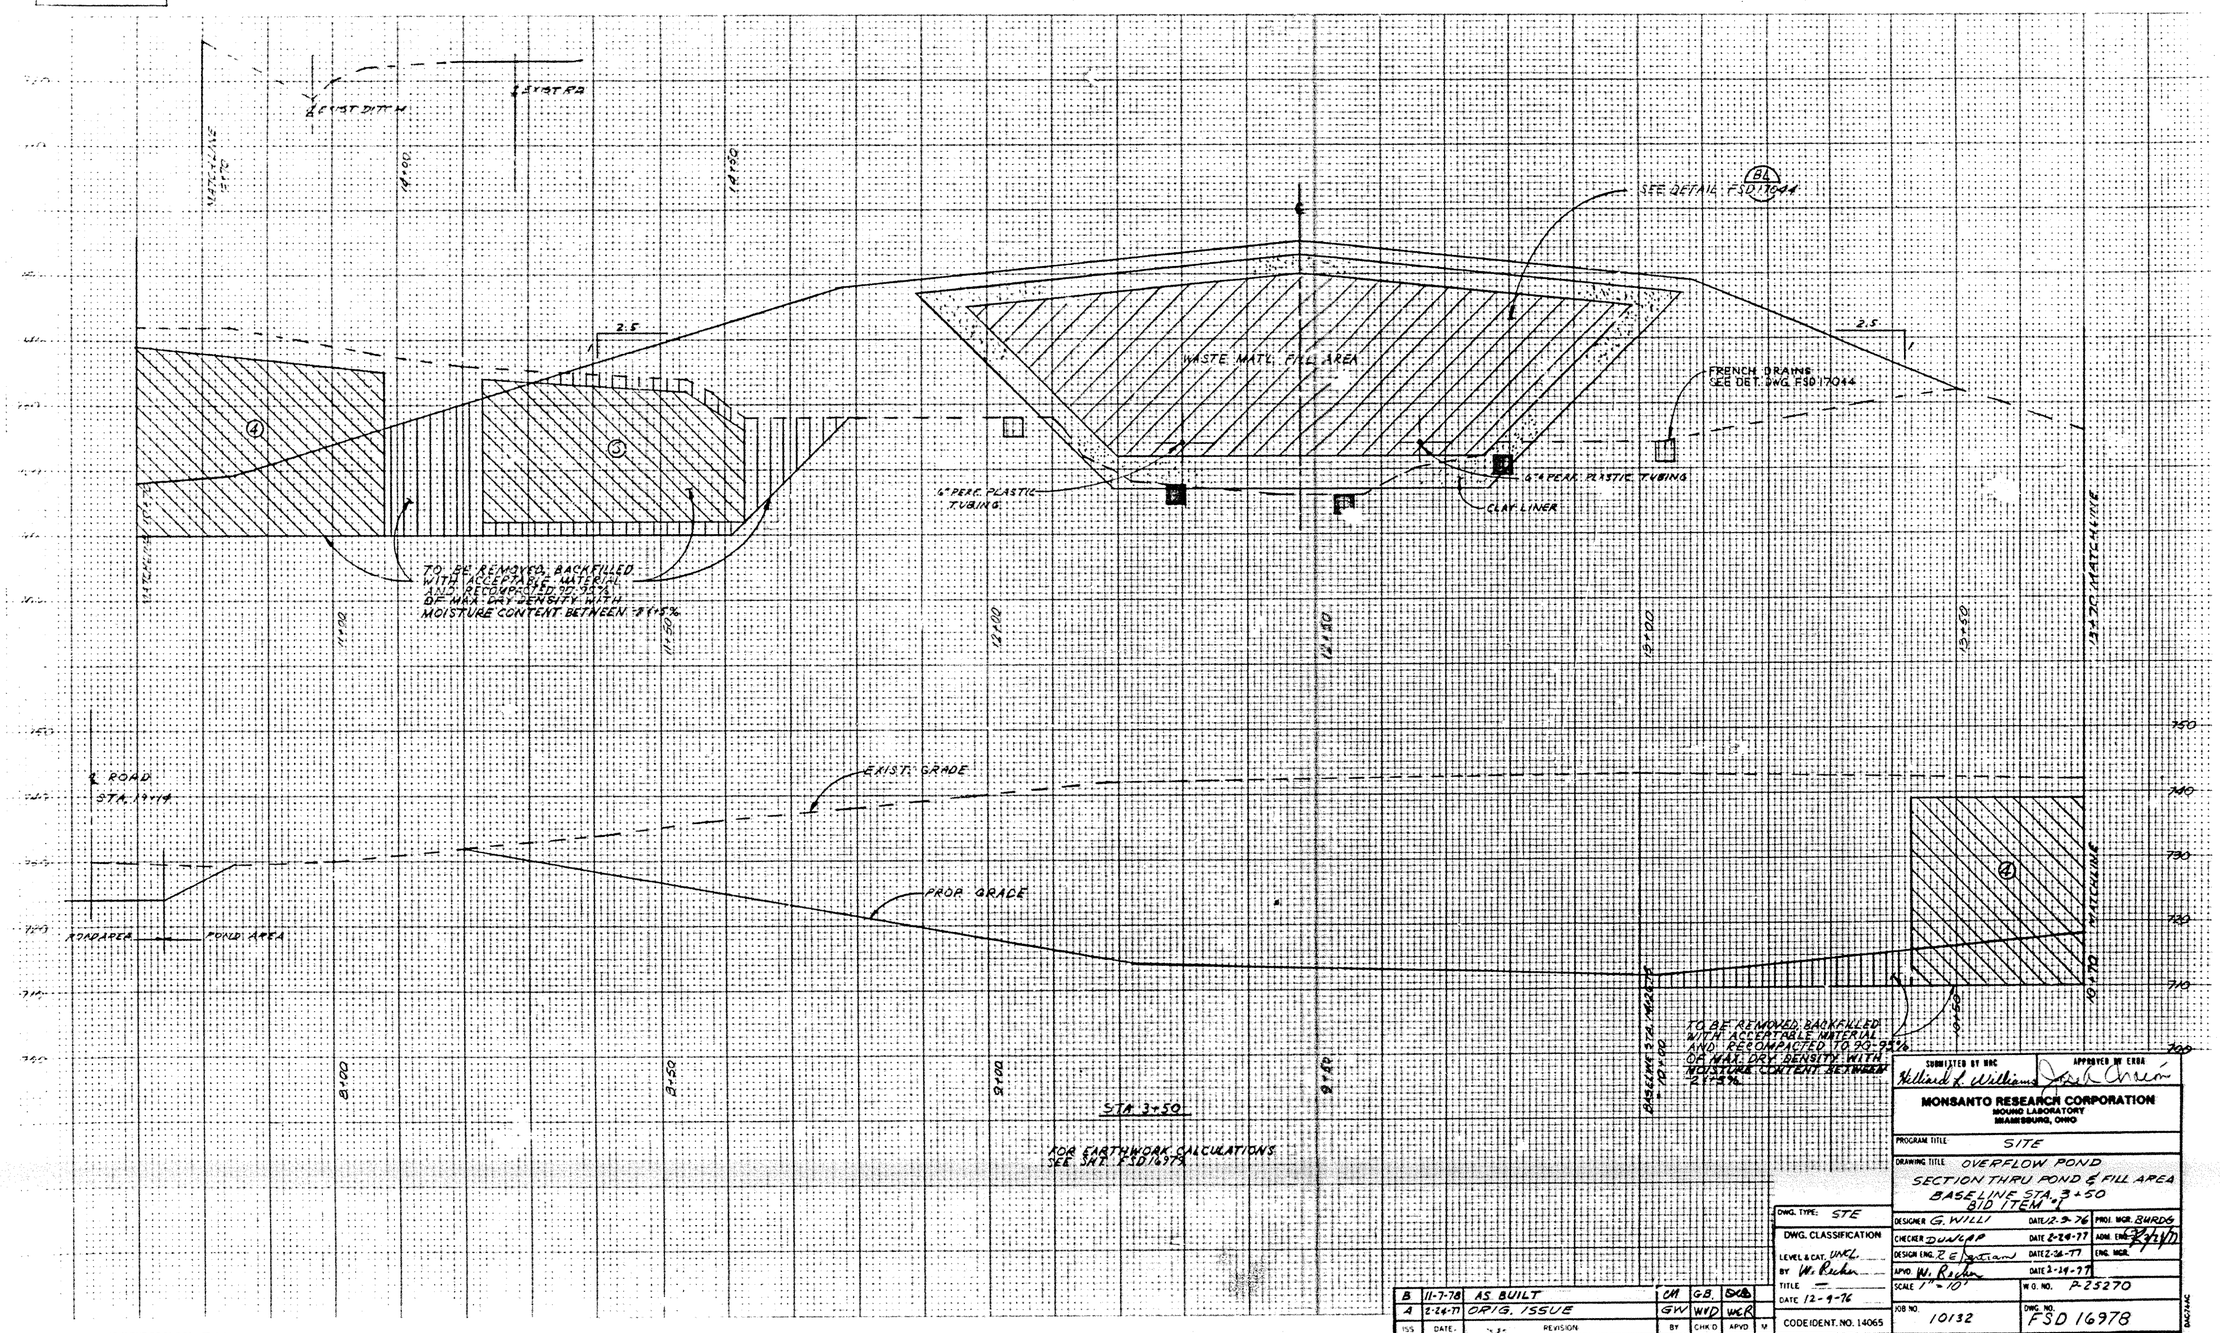

ISS	DATE	REVISION	BY	CHK'D	APVD	M
B	11-7-78	AS BUILT	CM	GB	SKB	
A	2-24-77	ORIG. ISSUE	GW	WVD	WCR	

DWG. TYPE: STE

DWG. CLASSIFICATION

LEVEL & CAT. UNCL.

BY W. Recher

TITLE —

DATE 12-9-76

CODEIDENT. NO. 14065

SUBMITTED BY MRC: Hilliard L. Williams

APPROVED BY ERDA: [signature]

MONSANTO RESEARCH CORPORATION
MOUND LABORATORY
MIAMISBURG, OHIO

PROGRAM TITLE: SITE

DRAWING TITLE: OVERFLOW POND
SECTION THRU POND & FILL AREA
BASELINE STA. 3+50
BID ITEM #1

DESIGNER G. WILLI	DATE 12-9-76	PROJ. MGR. BURDG	
CHECKER DUNLAP	DATE 2-24-77	ADM. ENG. [signature]	
DESIGN ENG. R. E. Jordan	DATE 2-24-77	ENG. MGR.	
APVD. W. Recher	DATE 2-24-77		
SCALE 1" = 10'	W.O. NO. P-25270		
JOB NO. 10132	DWG. NO. FSD 16978		

THIS PRINT IS THE PROPERTY OF MONSANTO RESEARCH CORPORATION AND MUST BE RETURNED TO DRAWING CONTROL MOUND LABORATORY. REPRODUCTION IS PROHIBITED WITHOUT PERMISSION OF MOUND LABORATORY.