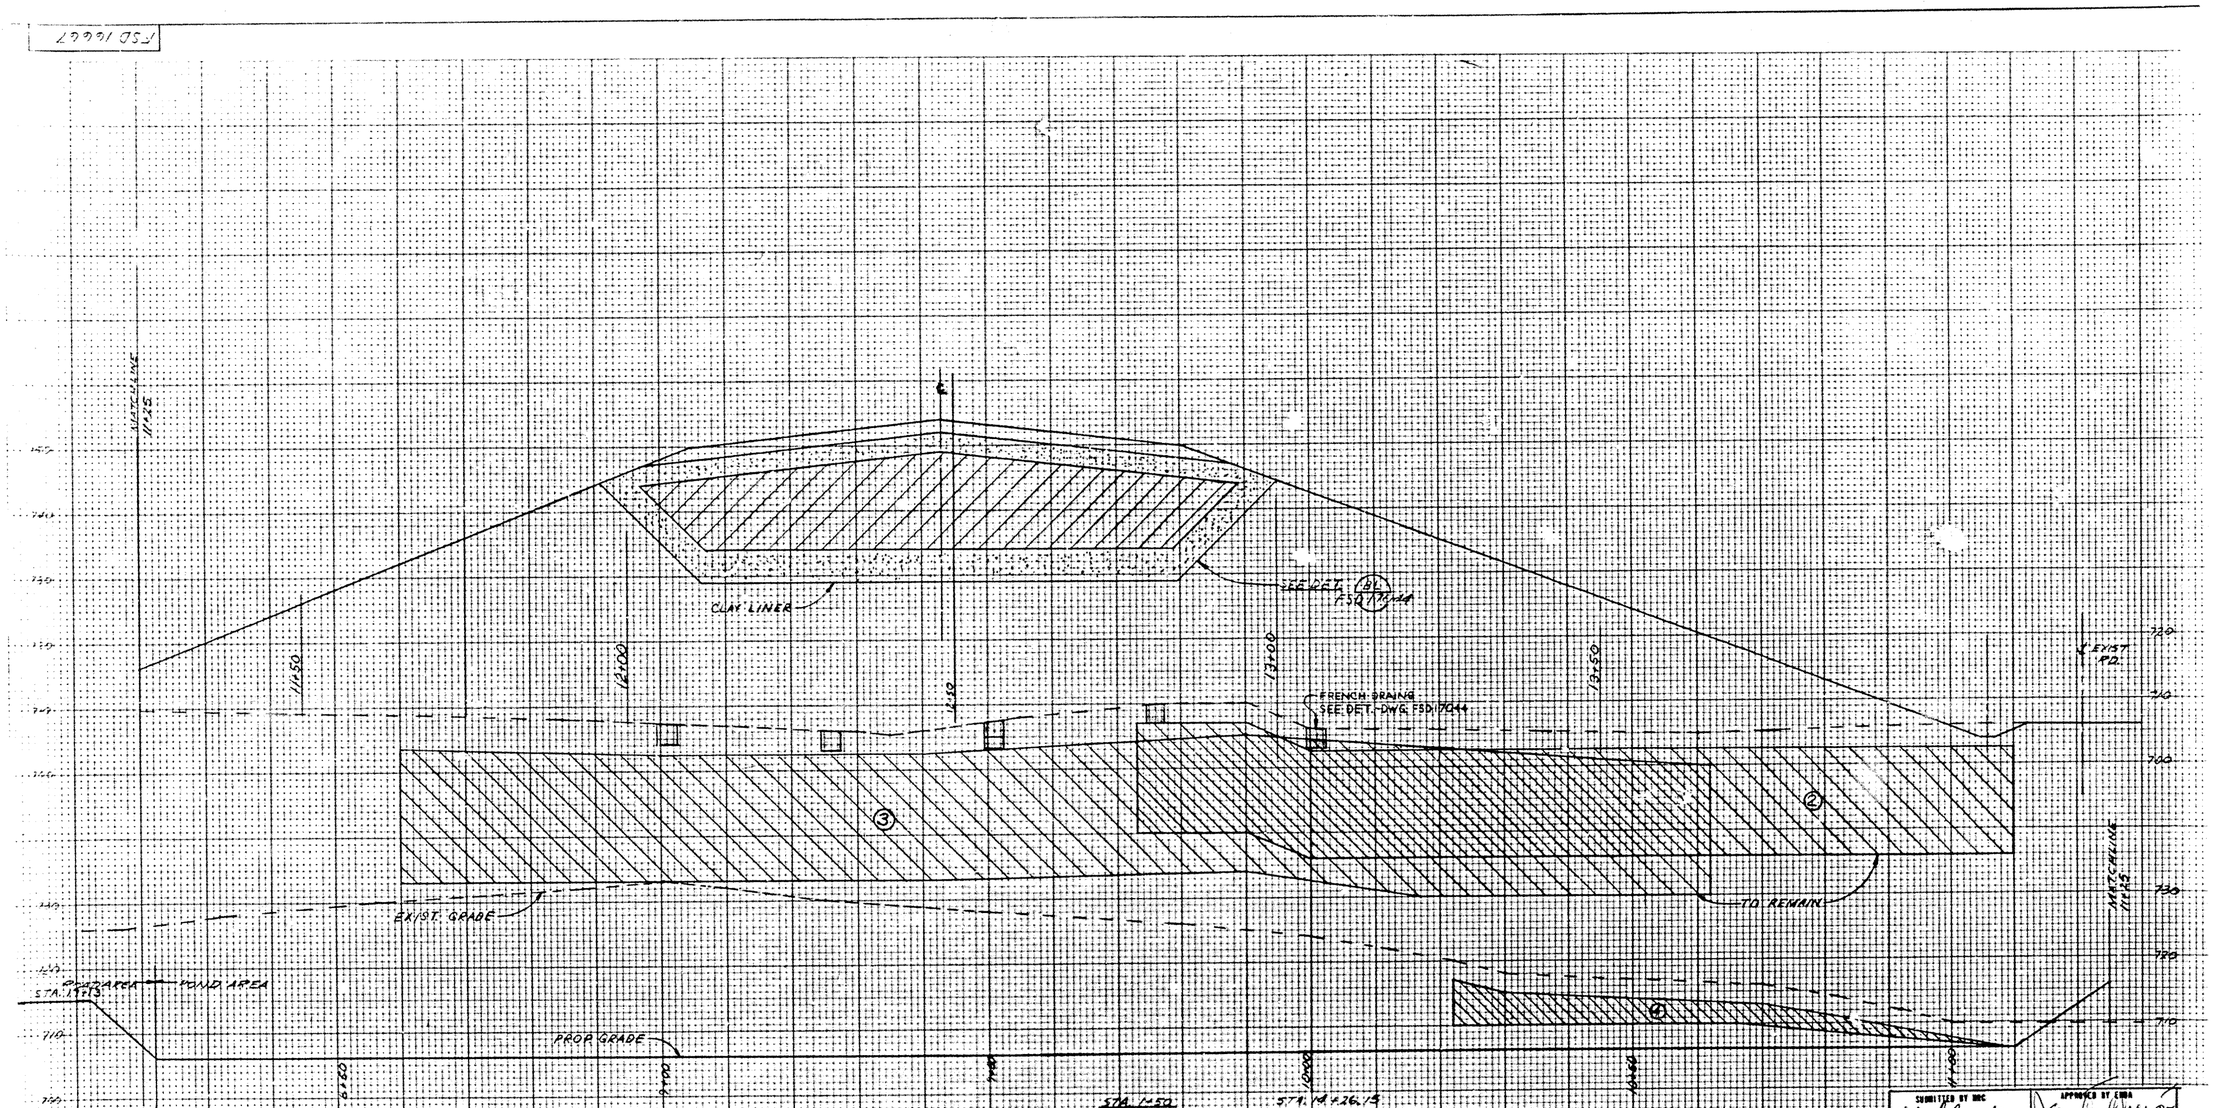

ISS	DATE	REVISION	BY	CHK'D	APV'D	M
B	11-7-78	AS BUILT	CM	G.B.	DB	
A	2-24-77	ORIG. ISSUE	G.W.	WVD	WSR	

DWG. TYPE: STE

DWG. CLASSIFICATION

LEVEL & CAT. UNCL.

BY W. Recker

TITLE —

DATE 12-9-76

CODE IDENT. NO. 14065

SUBMITTED BY MRC: Hilliard L. Williams

APPROVED BY EMBA: Jose L. Chacon

MONSANTO RESEARCH CORPORATION
MOUND LABORATORY
MIAMISBURG, OHIO

PROGRAM TITLE: SITE

DRAWING TITLE: OVERFLOW POND SECTION THRU POND & FILL AREA BASELINE STA. 1+50 BID ITEM #1

DESIGNER GWILLI	DATE 12-9-76	PROJ. MGR. BURDG	
CHECKER DUNCAN	DATE 2-24-77	ADM. ENG.	2/24/77
DESIGN ENG. R. C. Bertram	DATE 2-24-77	ENG. MGR.	
APVD. W. Recker	DATE 2-24-77		
SCALE 1" = 10'		W.O. NO. P-25270	
JOB NO. 10132		DWG. NO. FSD 16667	

THIS PRINT IS THE PROPERTY OF MONSANTO RESEARCH CORPORATION AND MUST BE RETURNED TO DRAWING CONTROL MOUND LABORATORY. REPRODUCTION IS PROHIBITED WITHOUT PERMISSION OF MOUND LABORATORY.