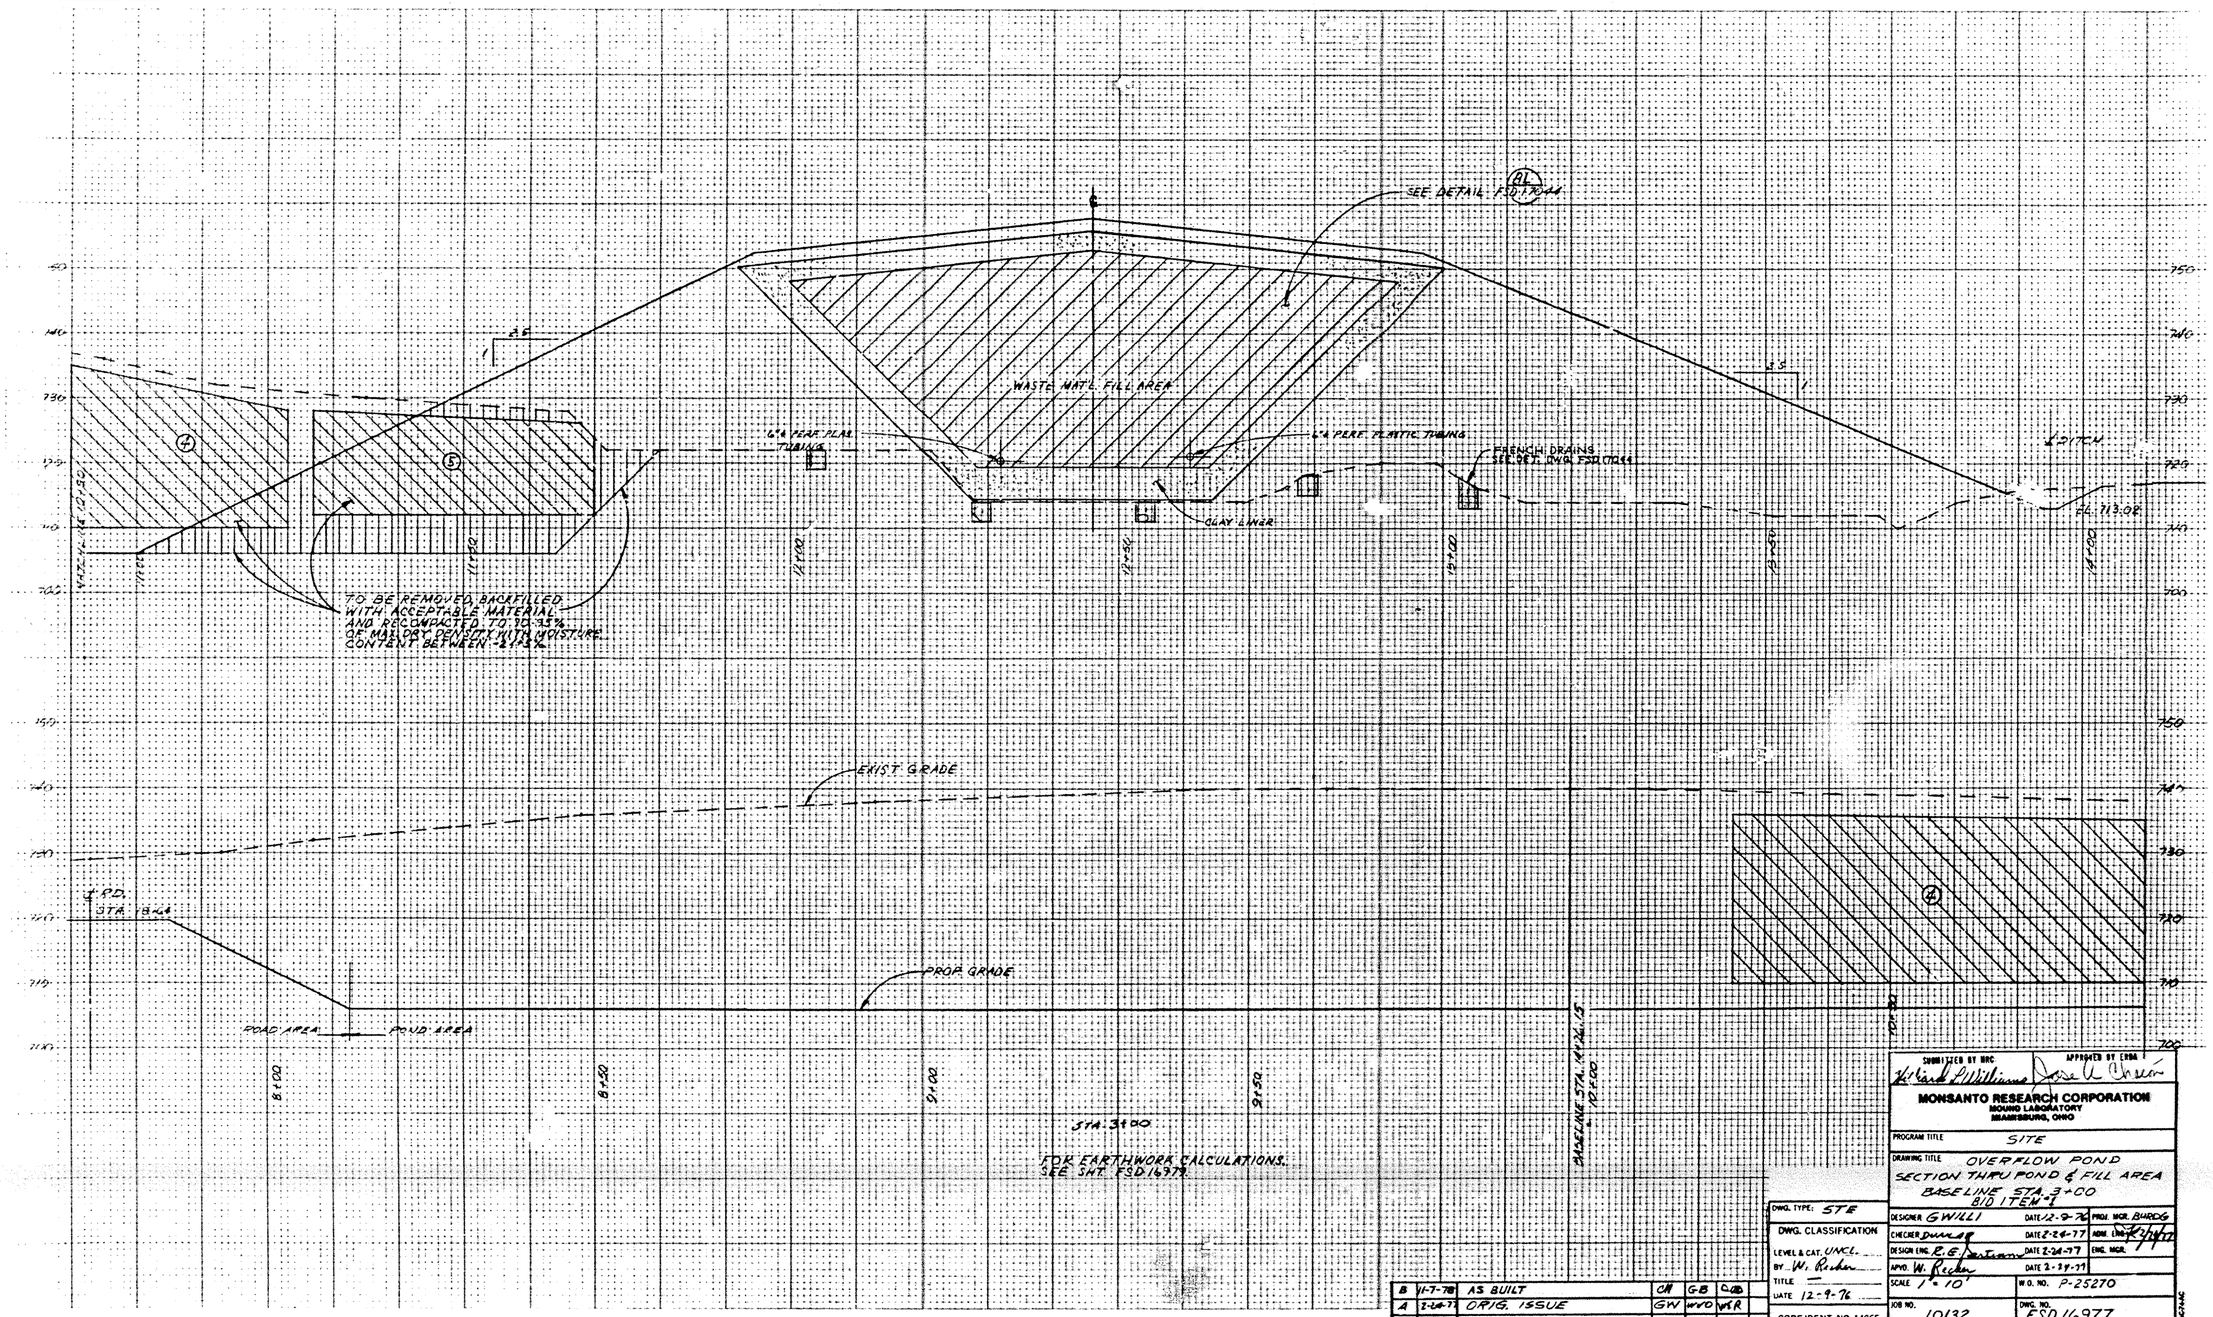

ISS	DATE	REVISION	BY	CHK'D	APVD	M
B	11-7-78	AS BUILT	CH	GB	CAB	
A	2-24-77	ORIG. ISSUE	GW	WVD	WSR	

DWG. TYPE: STE

DWG. CLASSIFICATION
LEVEL & CAT. UNCL.
BY W. Recher
TITLE —
DATE 12-9-76

CODE IDENT. NO. 14065

SUBMITTED BY MRC: Richard L. Williams
APPROVED BY ERDA: Jose A. Chacón

MONSANTO RESEARCH CORPORATION
MOUND LABORATORY
MIAMISBURG, OHIO

PROGRAM TITLE: SITE

DRAWING TITLE: OVERFLOW POND SECTION THRU POND & FILL AREA BASELINE STA. 3+00 BID ITEM #1

DESIGNER GWILLI	DATE 12-9-76	PROJ. MGR. BURDG	
CHECKER Duncan	DATE 2-24-77	ADM. ENG.	2/24/77
DESIGN ENG. R.E. Bertram	DATE 2-24-77	ENG. MGR.	
APVD. W. Recher	DATE 2-24-77		
SCALE 1" = 10'	W.O. NO. P-25270		
JOB NO. 10132	DWG. NO. FSD 16977		

THIS PRINT IS THE PROPERTY OF MONSANTO RESEARCH CORPORATION AND MUST BE RETURNED TO DRAWING CONTROL MOUND LABORATORY. REPRODUCTION IS PROHIBITED WITHOUT PERMISSION OF MOUND LABORATORY.