FSD16669

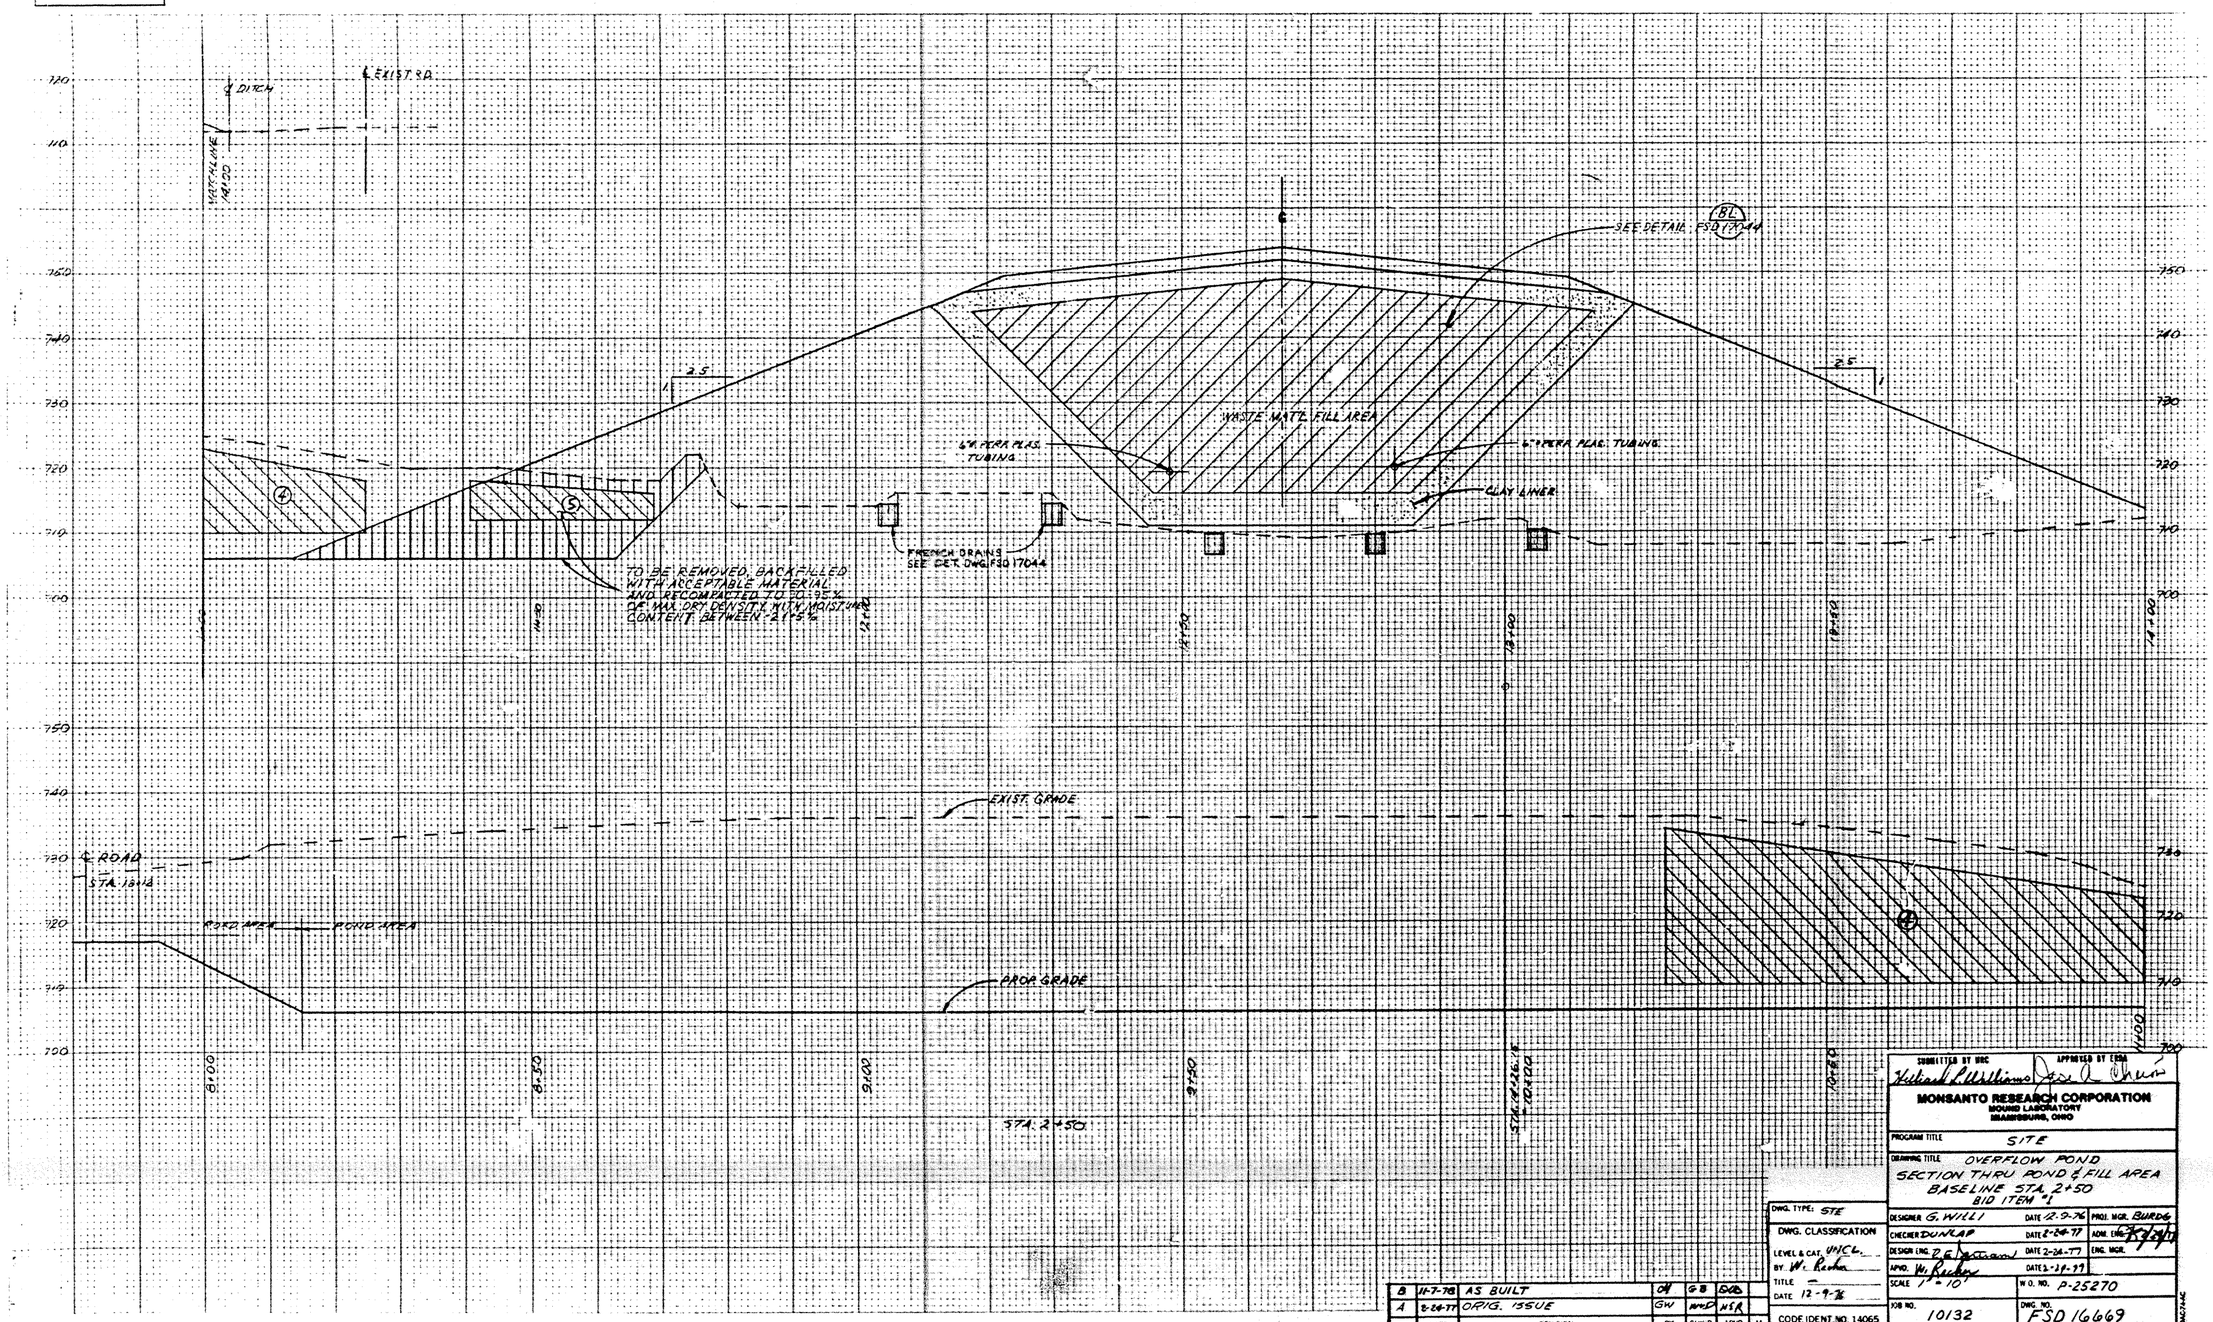

B	11-7-78	AS BUILT	CH	GB	DWD	
A	2-24-77	ORIG. ISSUE	GW	WWD	MSR	
ISS	DATE	REVISION	BY	CHK'D	APV'D	M

THIS PRINT IS THE PROPERTY OF MONSANTO RESEARCH CORPORATION AND MUST BE RETURNED TO DRAWING CONTROL, MOUND LABORATORY. REPRODUCTION IS PROHIBITED WITHOUT PERMISSION OF MOUND LABORATORY.

DWG. TYPE: SITE

DWG. CLASSIFICATION

LEVEL & CAT. UNCL.

BY W. Rocha

TITLE —

DATE 12-9-76

CODE IDENT. NO. 14065

SUBMITTED BY MRC: Richard L. Williams

APPROVED BY EGRA: Jack A. Shum

MONSANTO RESEARCH CORPORATION
MOUND LABORATORY
MIAMISBURG, OHIO

PROGRAM TITLE: SITE

DRAWING TITLE: OVERFLOW POND
SECTION THRU POND & FILL AREA
BASELINE STA. 2+50
BID ITEM #1

DESIGNER G. WILLI	DATE 12-9-76	PROJ. MGR. BURDG	
CHECKER DUNLAP	DATE 2-24-77	ADM. ENG.	2/24/77
DESIGN ENG. D. E. Jackson	DATE 2-24-77	ENG. MGR.	
APVD. W. Rocha	DATE 2-24-77		
SCALE 1" = 10'		W.O. NO. P-25270	
JOB NO. 10132		DWG. NO. FSD 16669	

BM2784C