VERIFY ALL DOCUMENTS FOR CURRENT REVISION AND PENDING CHANGES PRIOR TO EACH USE.
INIT_____ DATE_____

DRAWING NUMBER 02-202-1

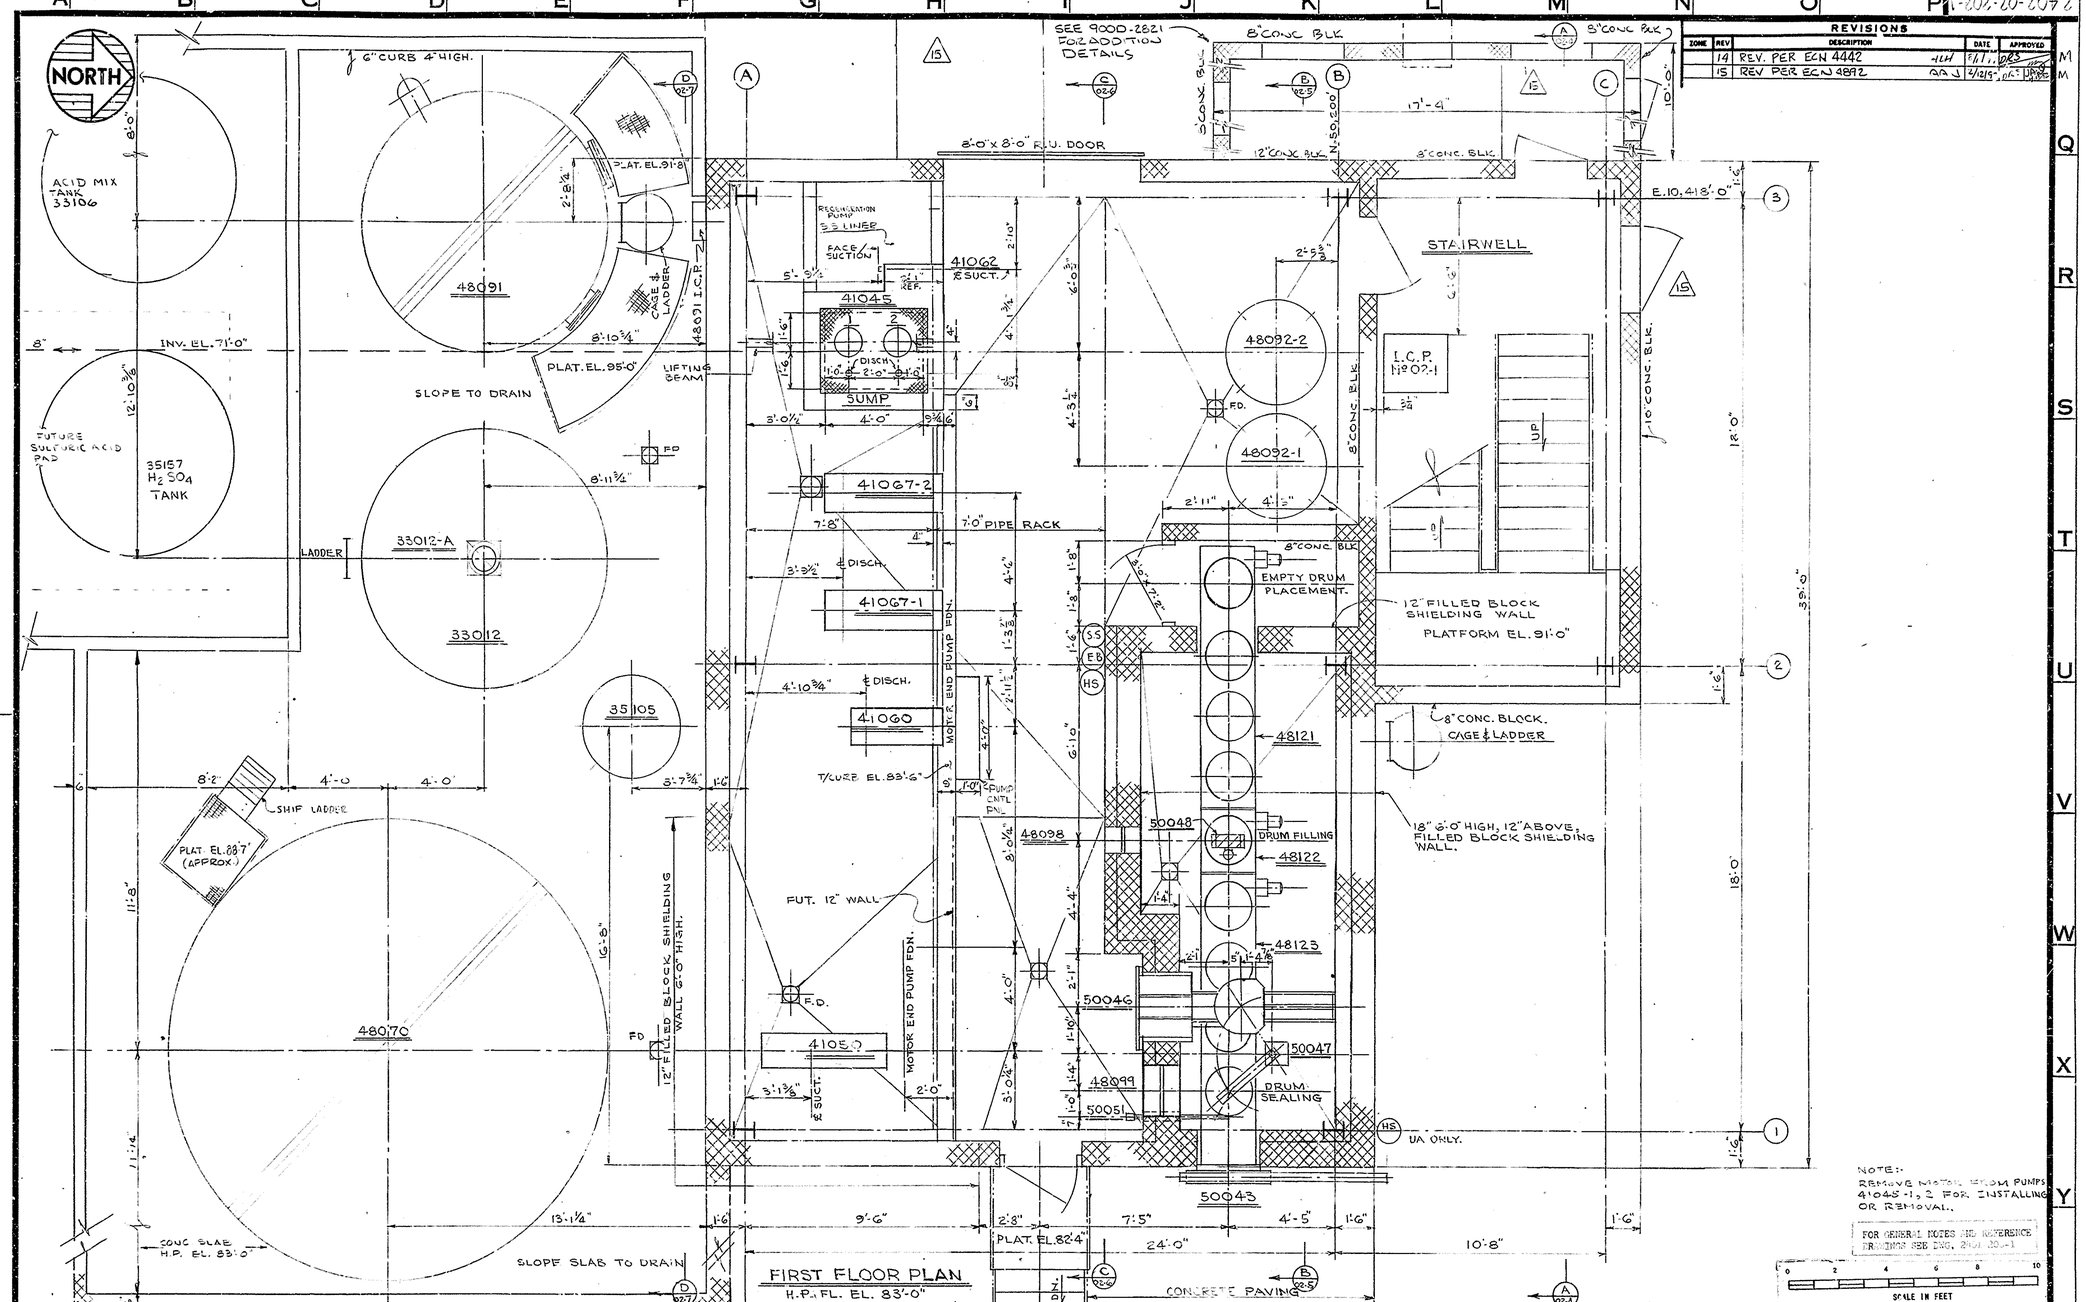

FIRST FLOOR PLAN

H.P. FL. EL. 83'-0"

NOTE:
REMOVE MOTOR FROM PUMPS 4104S-1, 2 FOR INSTALLING OR REMOVAL.

FOR GENERAL NOTES AND REFERENCE DRAWINGS SEE DWG. 2401-20-1

SCALE IN FEET

REVISIONS				
ZONE	REV	DESCRIPTION	DATE	APPROVED
M	14	REV. PER ECN 4442	7/1/70	
M	15	REV PER ECN 4892	2/12/71	

REV. NO.	DESCRIPTION	MADE BY	CHKD BY	DATE CHKD	REV. NO.	DESCRIPTION	MADE BY	CHKD BY	DATE CHKD	REV. NO.	DESCRIPTION	MADE BY	CHKD BY	DATE CHKD
4	RELOCATED 48097, S&G 42, ADDED ACID PROOF PAINT. 48097 REDRAWN	JE		10-26	8	ADDED DRUM FILLING RM. MECH. EQUIP. H.S. @ NE COR BLDG	JE		1-7	13	REVISED PER ECN 5244	CC	DKS	4/5/71
3	REMOVED PUMP PIT	J.E.		10-15	7	RELOCATED 41060	JE		12-22	12	REVISED	JH	GMJ	4-15-71
2	ADDED 48097, 98, 99 & E&W. DIM.	JE		10-1	6	4106 7-1, 2 GENERAL	JE		12-12	11	AS BUILT ISSUE	GFM		4-15-71
1	REDRAWN.	J.E.		9-18	5	REVISED WALL DIM.	JE		11-11	10	ITEM 02-202-1 ADDED	TFL	J.E	2-10
										9	RELOCATED 50046 50047	J.E		2-4

NO.	DATE	B-K CO.	B-K CO.	N.F.S. INC.
11	9-15-71	F. Meeker	W. Bangham	
2	10-1-70	F. Eberly	W. Bangham	

APPROVED FOR CONSTRUCTION

NO.	REV.	RELEASED FOR	APP.	DATE
2	2	CONSTRUCTION	JE	10-1
1	0	ENGINEERING	JE	7-21

	BY	DATE
APPR. CUSTOMER		7-21-70
APPR. W.L.B.		7-21-70
APPR.		
APPR.		
DRAWN	J. EBERLY	7-20-70
TRCD.		
CHKD.		
SCALE	3/8" = 1'-0"	

UNIT TITLE
LOW LEVEL WASTE TREATMENT LAYOUT
FIRST FLOOR PLAN EL. 83'-0"
FOR N.F.S. INC. W. VALLEY, N.Y.

BLAW-KNOX COMPANY
CHEMICAL PLANTS DIVISION
PITTSBURGH, PENNSYLVANIA

DRAWING NUMBER 2401-02-202-1
REV. E

FORM NO. E-355-REV. 6-68 "D"

COLOR WARNING: PRINTS OF THIS DRAWING ON PINK PAPER ARE "PRELIMINARY" AND SHALL NOT BE USED FOR MANUFACTURING OR CONSTRUCTION PURPOSES.

THIS DRAWING AND THE INFORMATION IT CONTAINS ARE THE PROPERTY OF THE BLAW-KNOX COMPANY. IT IS NOT TO BE COPIED OR TRACED, NOR IS THE INFORMATION TO BE MISUSED IN ANY WAY.