VERIFY ALL DOCUMENTS FOR CURRENT REVISION AND PENDING CHANGES PRIOR TO EACH USE.
INIT_____ DATE_____

DRAWING NUMBER 02-202-5

DRAWING NO. 2401-02-202-5

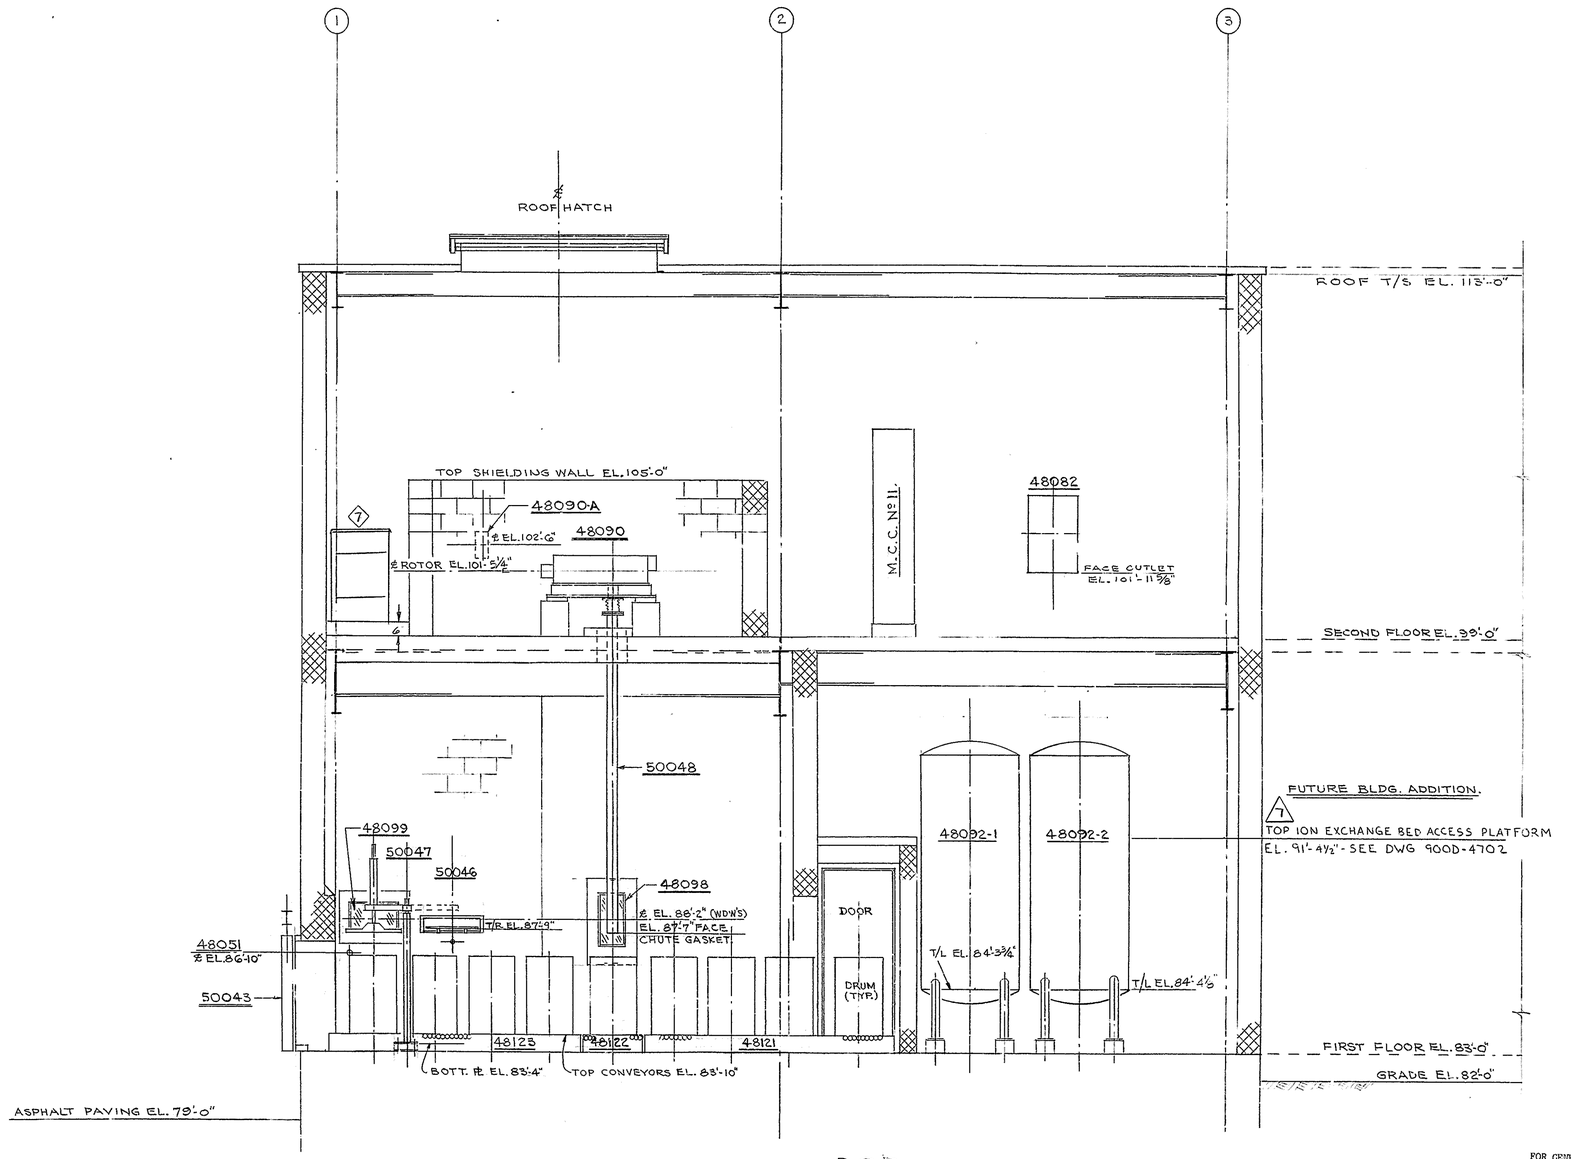

ELEVATION (B) 92-1 (B) 92-2 (B) 92-3

FOR GENERAL NOTES AND REFERENCE DRAWINGS SEE DWG. 2401-200-1

SCALE IN FEET (0, 2, 4, 6, 8, 10)

REV. NO.	DESCRIPTION	MADE BY	CHKD BY	DATE CHKD
4	REVISED E. LV. OF 48092-1 & 2 ADDED EQUIP.	JE		12-15
3		JE		11-21
2	CUSTOMER APPR. FOR CONST.	JE		10-1
1	REDRAWN	J.E.		9-21

REV. NO.	DESCRIPTION	MADE BY	CHKD BY	DATE CHKD	APV'D
8	REV PER ECN 5069	LPK	HAB		
7	ADDED TANKS & C FLOOR	JH	GWM	10-16-72	
6	AS BUILT ISSUE	GFM		9-17-71	
5	ADDED 48090A, 48098, 48082, 48092, 50046, 50047, 50048, 50051	JE		1-8	

NO.	DATE	B-K CO.	B-K CO.	N.F.S. INC.
6	9-17-71	J. Makes	W. Baugh	Harrel
2	10-1-70	J. Eberly	W. Baugh	W. Wall

APPROVED FOR CONSTRUCTION

NO.	REV.	RELEASED FOR	APP.	DATE
2	2	CONSTRUCTION.	JE	10-1
1	0	ENGINEERING	J.E.	7-21

	BY	DATE		BY	DATE
APPR.	COSTUMER	7-21-70	DRAWN	J. EBERLY	7-21-70
APPR.	W.L.B.	7-21-70	TRCD.		
APPH.			CHKD.		
APPR.					

SCALE 3/8" = 1'-0"

UNIT
TITLE LOW LEVEL WASTE TREATMENT LAYOUT ELEVATION (B)
FOR N.F.S. INC. W. VALLEY, N.Y.

BLAW-KNOX COMPANY
CHEMICAL PLANTS DIVISION
PITTSBURGH, PENNSYLVANIA

DRAWING NUMBER 2401-02-202-5 REV. 7

FORM NO. E-355-REV. 6-69 "D"

COLOR WARNING: PRINTS OF THIS DRAWING ON PINK PAPER ARE "PRELIMINARY" AND SHALL NOT BE USED FOR MANUFACTURING OR CONSTRUCTION PURPOSES.

THIS DRAWING AND THE INFORMATION IT CONTAINS ARE THE PROPERTY OF THE BLAW-KNOX COMPANY. IT IS NOT TO BE COPIED OR TRACED, NOR IS THE INFORMATION TO BE MISUSED IN ANY WAY.