VERIFY ALL DOCUMENTS FOR CURRENT REVISION AND PENDING CHANGES PRIOR TO EACH USE.
INIT_____ DATE_____

DRAWING NUMBER

DRAWING NUMBER

DRAWING NUMBER

DRAWING NUMBER 02-202-7

DRAWING NUMBER

DRAWING NUMBER

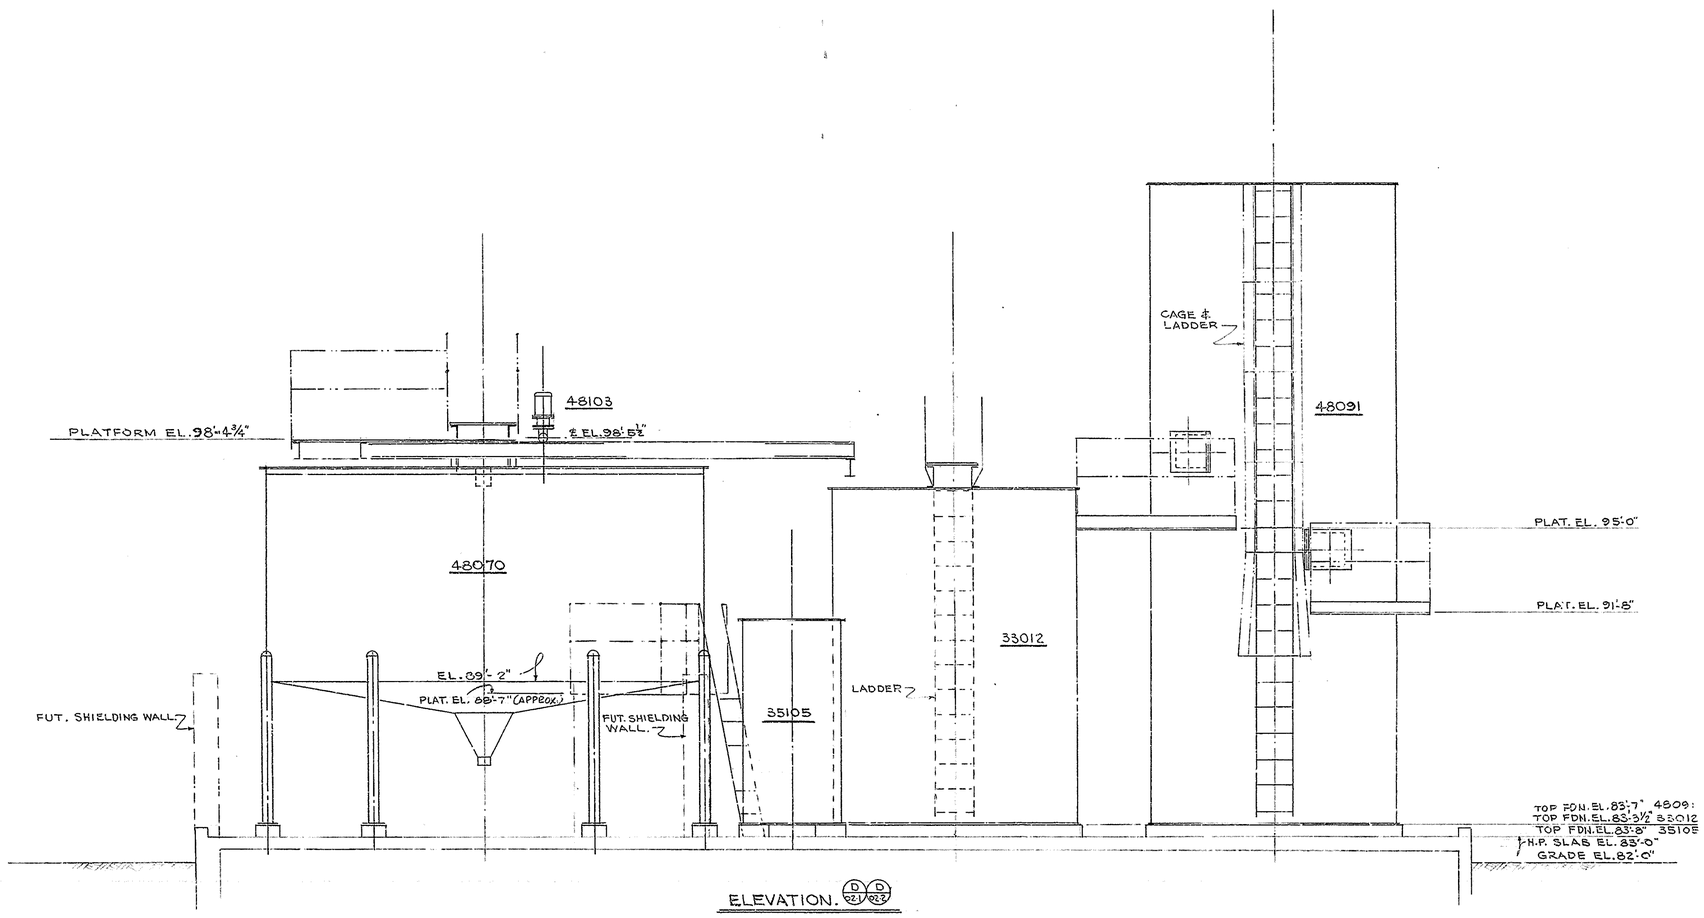

ELEVATION. D/02-1 D/02-2

FOR GENERAL NOTES AND REFERENCE DRAWINGS SEE DWG. 2401-200-1

0 2 4 6 8 10
SCALE IN FEET

REV. NO.	DESCRIPTION	MADE BY	CHKD BY	DATE CHKD
2	AS BUILT ISSUE	GFM		9-17-71
1	REVISED ELEV. 35105	JE		12-15

NO.	DATE	B-K CO.	S-K CO.	N.F.S. INC.
2	9-17-71	F. Hackes	W. Bergman	[signature]
0	11-24-70	J. Eberly	W. Bergman	[signature]

APPROVED FOR CONSTRUCTION

NO.	REV.	RELEASED FOR	APP.	DATE
1	0	CONSTRUCTION	JE	11-24

	BY	DATE		BY	DATE
APPR.	W L B	11-24-70	DRAWN	J. EBERLY	11-24-70
APPR.	CUSTOMER	11-24-70	TRCD.		
APPR.			CHKD.		
APPR.					

SCALE 3/8" = 1'-0"

UNIT

TITLE LOW LEVEL WASTE TREATMENT, LAYOUT ELEVATION (D)

FOR N.F.S. INC. W. VALLEY, N.Y.

BLAW-KNOX COMPANY
CHEMICAL PLANTS DIVISION
PITTSBURGH, PENNSYLVANIA

DRAWING NUMBER 2401-02-202-7 REV. (2)

FORM NO. E-355-REV. 6-68 "D"

COLOR WARNING: PRINTS OF THIS DRAWING ON PINK PAPER ARE "PRELIMINARY" AND SHALL NOT BE USED FOR MANUFACTURING OR CONSTRUCTION PURPOSES.

THIS DRAWING AND THE INFORMATION IT CONTAINS ARE THE PROPERTY OF THE BLAW-KNOX COMPANY. IT IS NOT TO BE COPIED OR TRACED, NOR IS THE INFORMATION TO BE MISUSED IN ANY WAY.