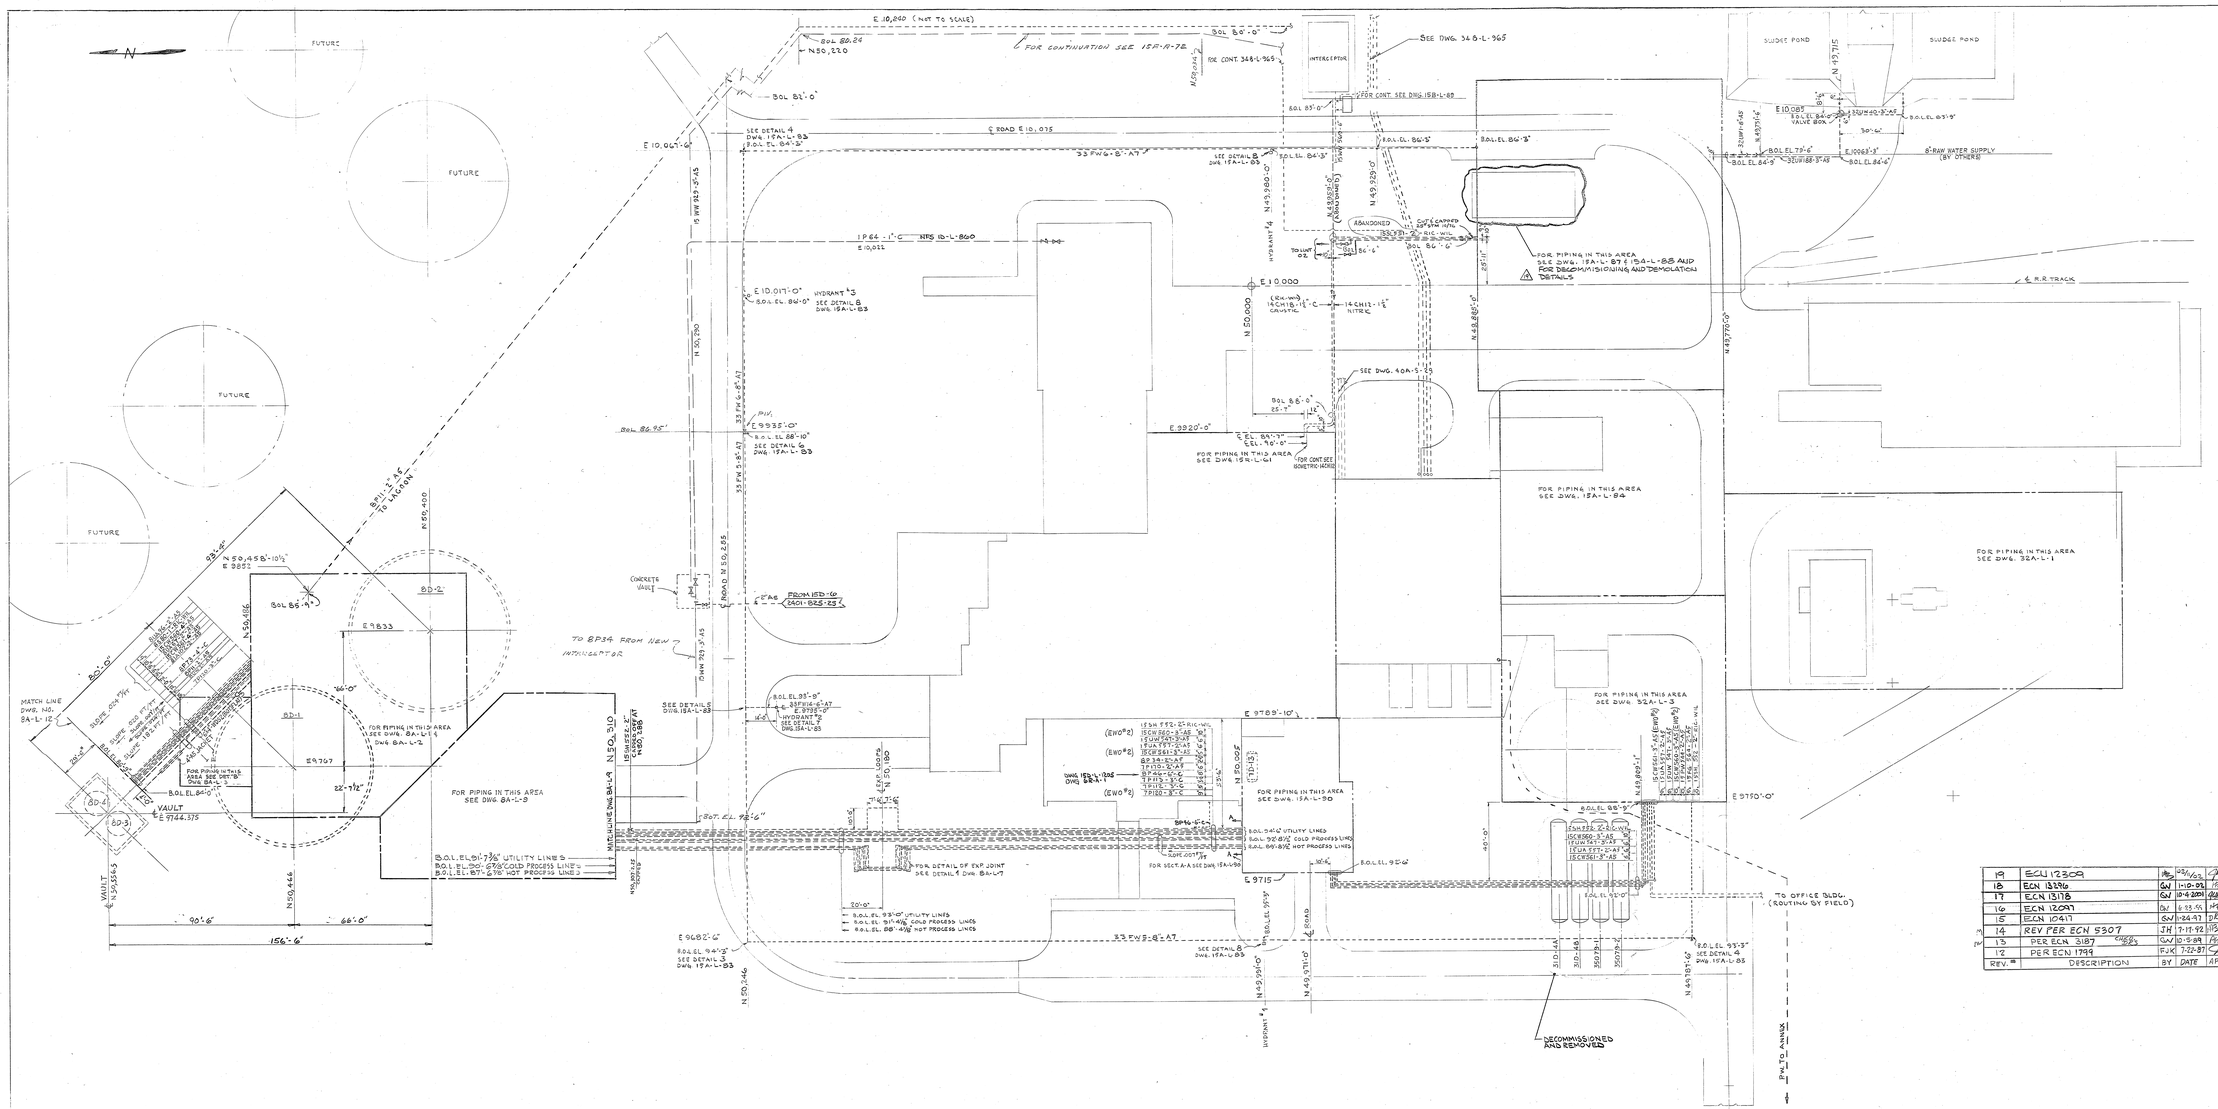

NOTES

ALL YARD PIPING IS FIELD FABRICATED UNLESS NOTED OTHERWISE

MATERIAL SHEETS FOR THIS DWG ARE NUMBERED FROM No. 1 To No. 23

FABRICATION SYMBOLS FOR ORTHOGRAPHIC DRAWINGS

DESIGNATES FIELD FABRICATION — F | S — DESIGNATES SHOP FABRICATION

32UW80-1-A

DESIGNATES SPOOL NUMBER TO BE MARKED ON SPOOL PER SPEC. 4413-L-2 SEC. B

REFERENCE DRAWINGS

8A-L-1	WASTE STORAGE TANKS 8D-1&2, PROCESS PIPING
8A-L-2	WASTE STORAGE TANKS 8D-1&2, UTILITY PIPING
8A-L-3	WASTE STORAGE TANKS 8D-3&4, PLAN & SECTIONS
8A-L-7	WASTE STORAGE TANKS 8D-1&2, SECTIONS & DETAILS
8A-L-9	WASTE TANK FARM EQUIP. SHELTER & CONDENSERS
15R-L-61	UNDERGROUND LINES - PROCESS BUILDING
15A-L-83	FIRE WATER LINE - DETAILS
15A-L-84	CLARIFIER & DEMINERALIZED WATER TANKS
15A-L-87	NITRIC ACID, CAUSTIC & FUEL OIL TANKS
15B-L-89	INTERCEPTOR PIPING
15A-L-90	LAUNDRY & ANALYTICAL DRAIN TANK
32A-L-1	COOLING TOWER
32A-L-3	FILTERED WATER TANK & FIRE WATER PUMPS
40A-S-29	PAVING GRADING & SEWER LINES

REV. No.	DESCRIPTION	BY	DATE	APPRD.
19	ECN 12309	MS	3/1/93	
18	ECN 13296	GW	11-10-92	
17	ECN 13178	GW	10-6-2000	
16	ECN 12097	DL	6-23-92	
15	ECN 10417	GW	3-24-91	
14	REV PER ECN 5307	JH	7-11-92	
13	PER ECN 3187	GW	10-5-89	
12	PER ECN 1799	FJK	7-22-87	

REV. No.	DESCRIPTION	BY	DATE	APPRD.
11	11/14/88 SCHEDULE 80 ADDED TO WASTE STORAGE TANKS	JRB		JRB
10	7/14/88 BLINDVALVE - CAPPED LINE	JRB		JRB
9	5/11/88 AS BUILT	MS		
8	2/8/88 ADDED NEW PIPING AREA, NORTH & TANK	JRB		
7	12/8/86 REVISED MATCH LINE & ELEVATIONS & SLOPES AT ON-GRADE TANKS	MS		
6	4/1/85 UNDER REVISION - FIRE & COOLING WATER LINES ADDED LINE 8UW6-2"-AS, ADDED NOTE: REDOC PIPING AT BD-3 & BD-4	DW		
5	3/11/85 REVISED TO REDOC SECTION PIPING SLOPE ALL LINES AT ON-GRD TANKS	RY	MS	
4	12/11/84 ADDED EWO'S PIPING	RG	MS	
3	10/22/84 DELETED BD-1 & BD-2 ADDED BD-3 & BD-4 ADDED 3" & 4" FIRE WATER LINES	RG	MS	
2	8/24/84 REVISED FABRICATION & SPOOLS	V.G.		
1	6/14/84 REFERENCE DRAWING CHANGED	V.G.		
0	1/10/84 DELETED BDW-1 REVISED BD-1 & BD-2 ADDED ANCHOR REVISED LINES 14UW, 15UW	RG	DW	
	10/1/83 ISSUED FOR CONSTRUCTION	HEL		

1" = 20'-0"

HEL

PIPING ARRANGEMENT
INTERCONNECTING LINES
PLAN

4413 15R-L-81 | 19

15R-L-81