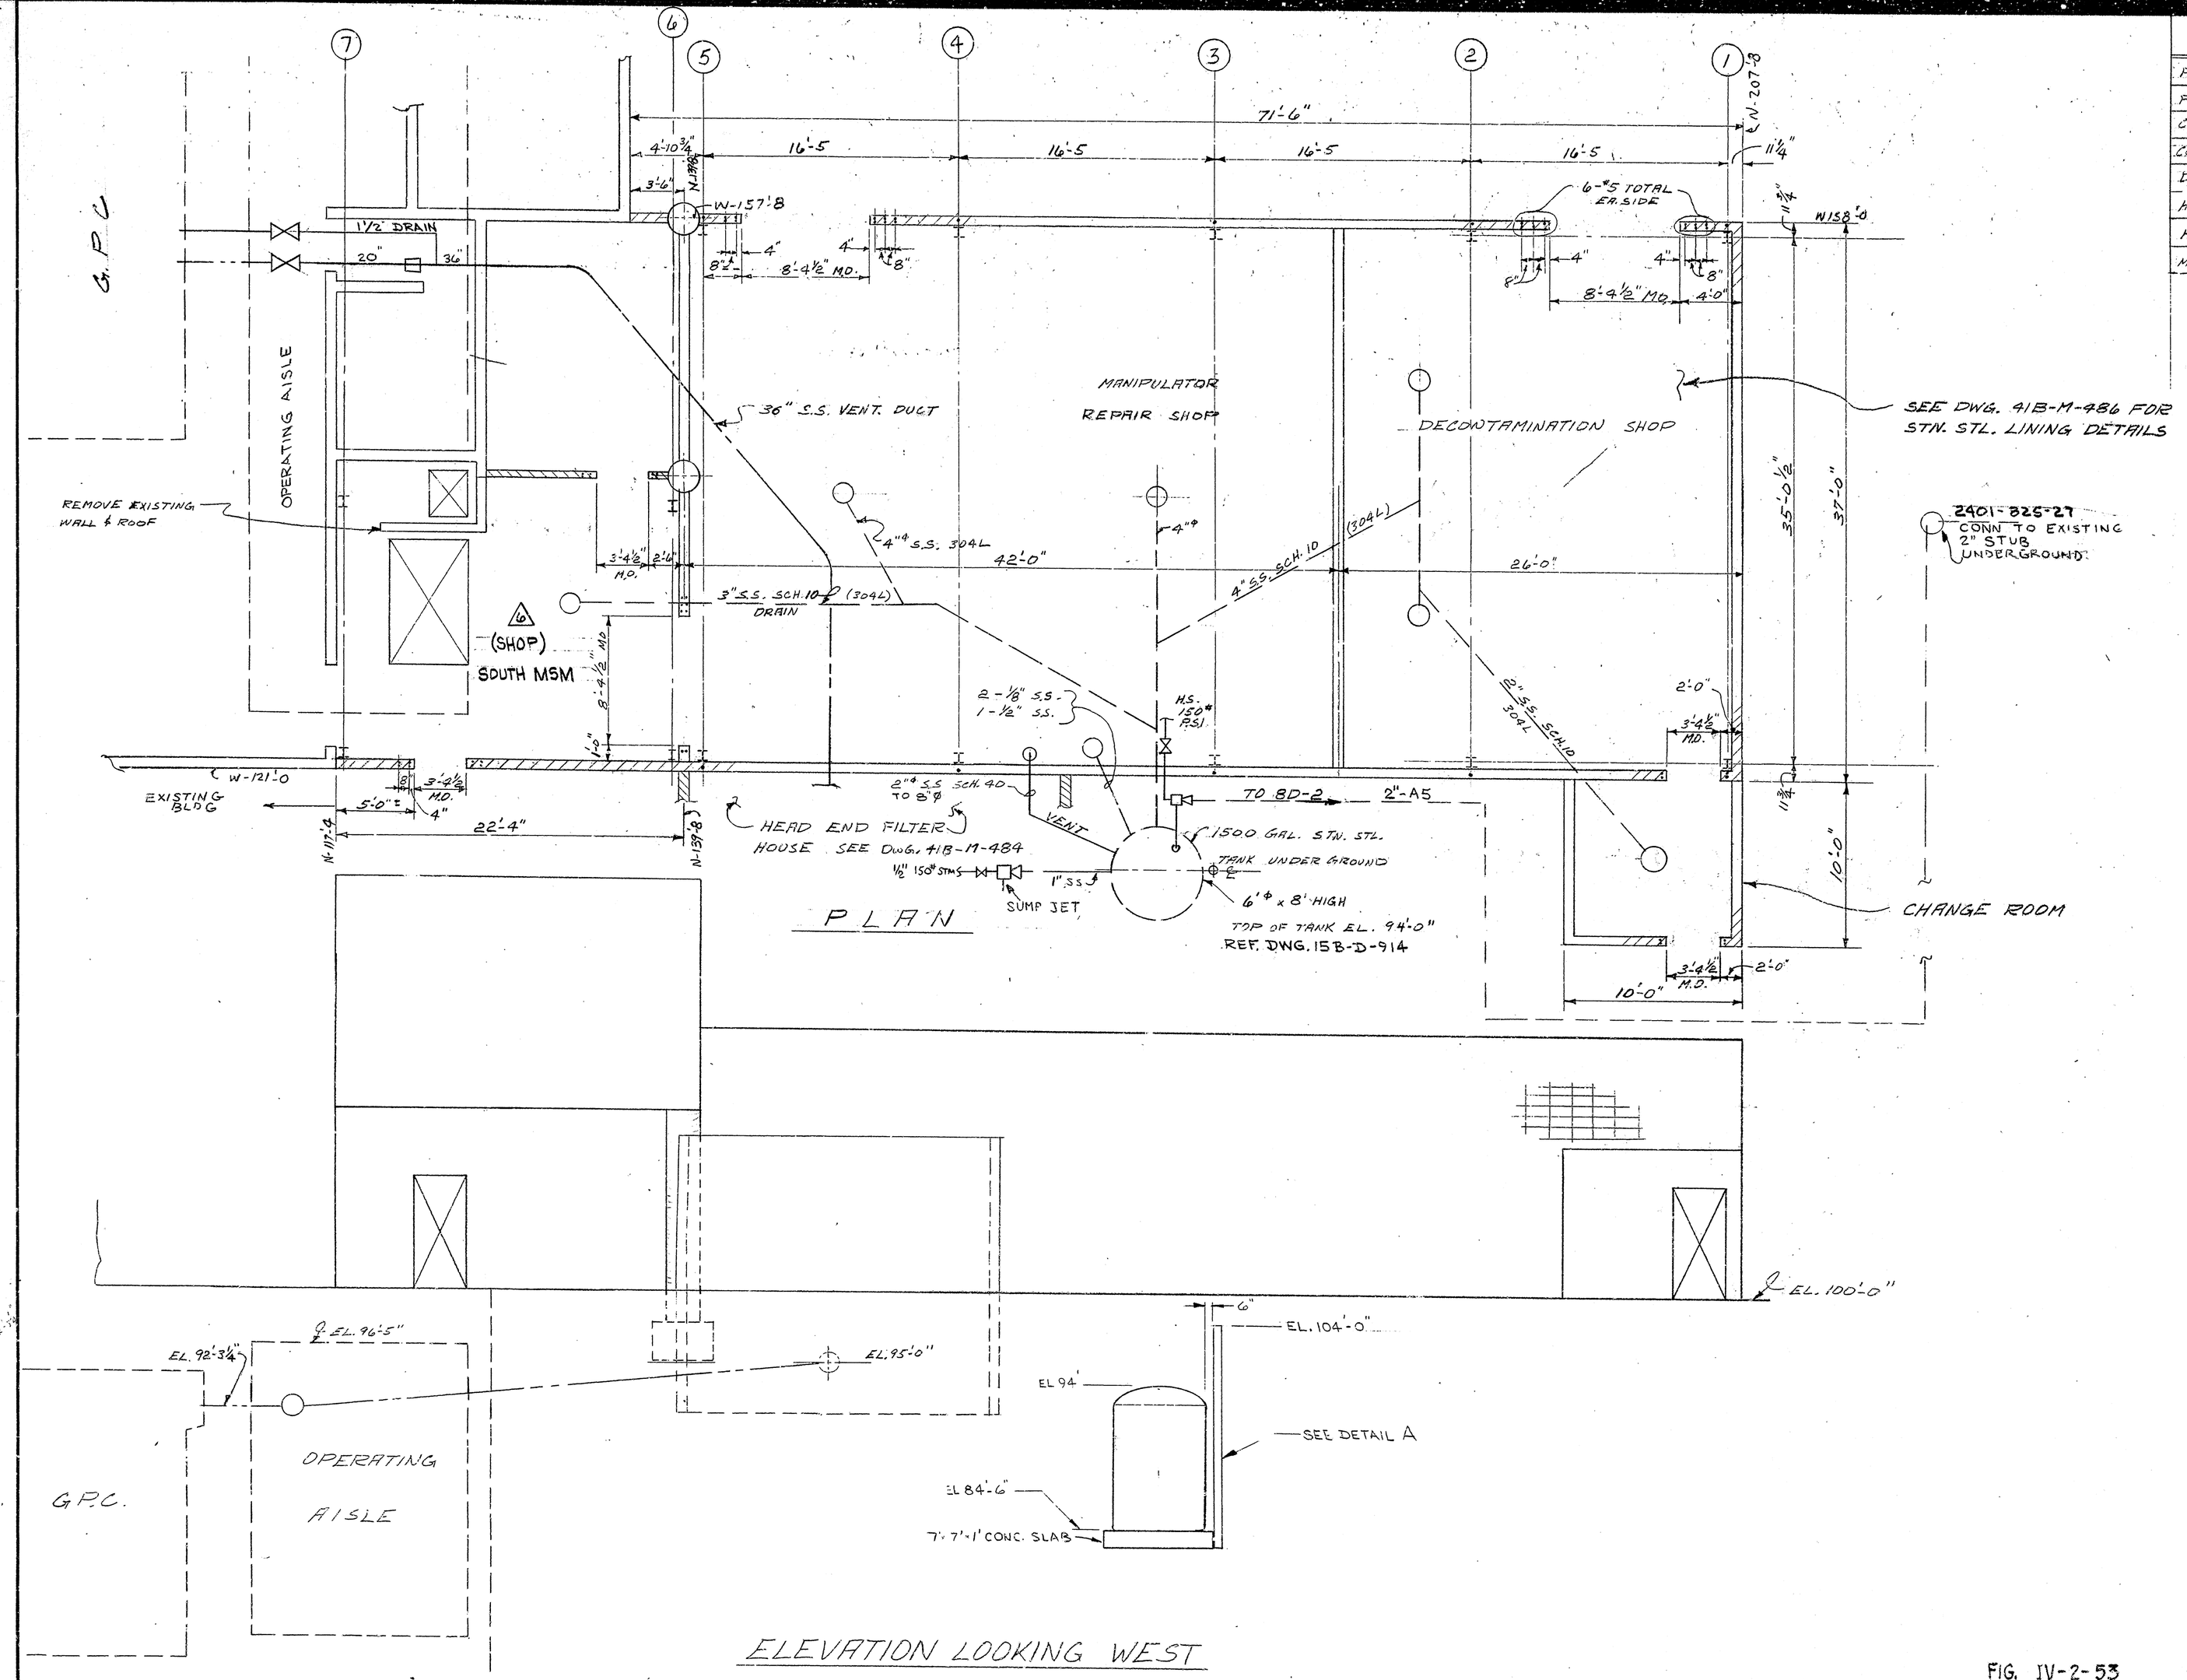

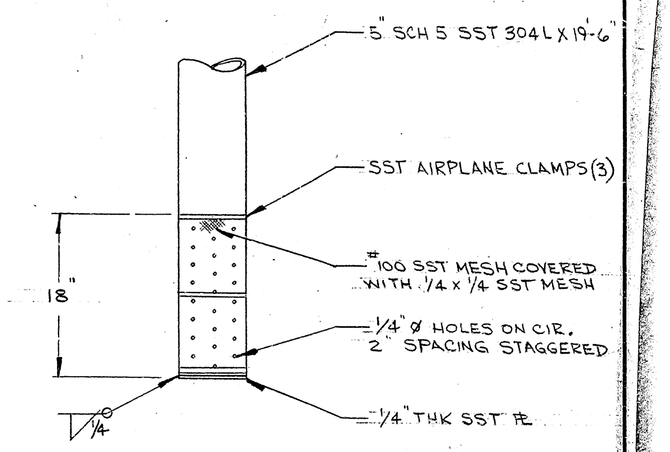

DETAIL A
SURVEILLANCE WELL

REFERENCE DRAWINGS

FOUNDATION PLAN & DETAILS	41B-Q-470
FRAMING PLAN & DETAILS	41B-M-471
CONCRETE BLOCK ELEVATIONS	41B-M-472
CONCRETE BLOCK ELEVATIONS & ROOF PLAN	41B-M-473
DECON. ROOM STN. STL. LINING DETAILS	41B-M-486
HEAD END FILTER HOUSE DETAILS	41B-M-484
HEAD END FILTER HOUSE SECTIONS	41B-M-487
MSM REPAIR SHOP PIPING & VENTILATION	41B-M-493

NOTE
ALL FLOORS TO BE SLOPED 1/4"/FT. TO DRAINS

NO.	DATE	REVISIONS	BY	CH'K	APPR.	APPR.	APPR.
6	8/7/02	ECN 13472	BP	HB			
5	6/29/99	ECN 12097	GW	HB			
4	9/8/70	ADDED SURVEILLANCE WELL	JPH		PB	JPH	
3	6/22/70	AS BUILT	JPH		PB	WRD	
REV 2	11/17/67	ADDED TK. EL. ISSUED FOR CONST.			PB		
REV 1	10/30/67	ADDED CHANGE RM. & MISC. ITEMS	[illegible]		PB		
REV 0	6/16/67		[illegible]				

SCALE 3/16" = 1'-0" DESIGNED P. BURN DRAWN G. A. GERWITZ

NUCLEAR FUEL SERVICES, INC.
SUBSIDIARY OF W. R. GRACE & CO.
WEST VALLEY, NEW YORK

MSM REPAIR SHOP
PLAN & ELEVATION

PROJECT NO.	DRAWING NO.	REV. NO.
	41B-M-474	6

FIG. IV-2-53

SULLIVAN-McKEEGAN CO., INC. BUFFALO NO. 10 .38 CRYSTALENE 280-4-67