VERIFY ALL DOCUMENTS FOR CURRENT REVISION AND PENDING CHANGES PRIOR TO EACH USE.
INIT_____ DATE_____

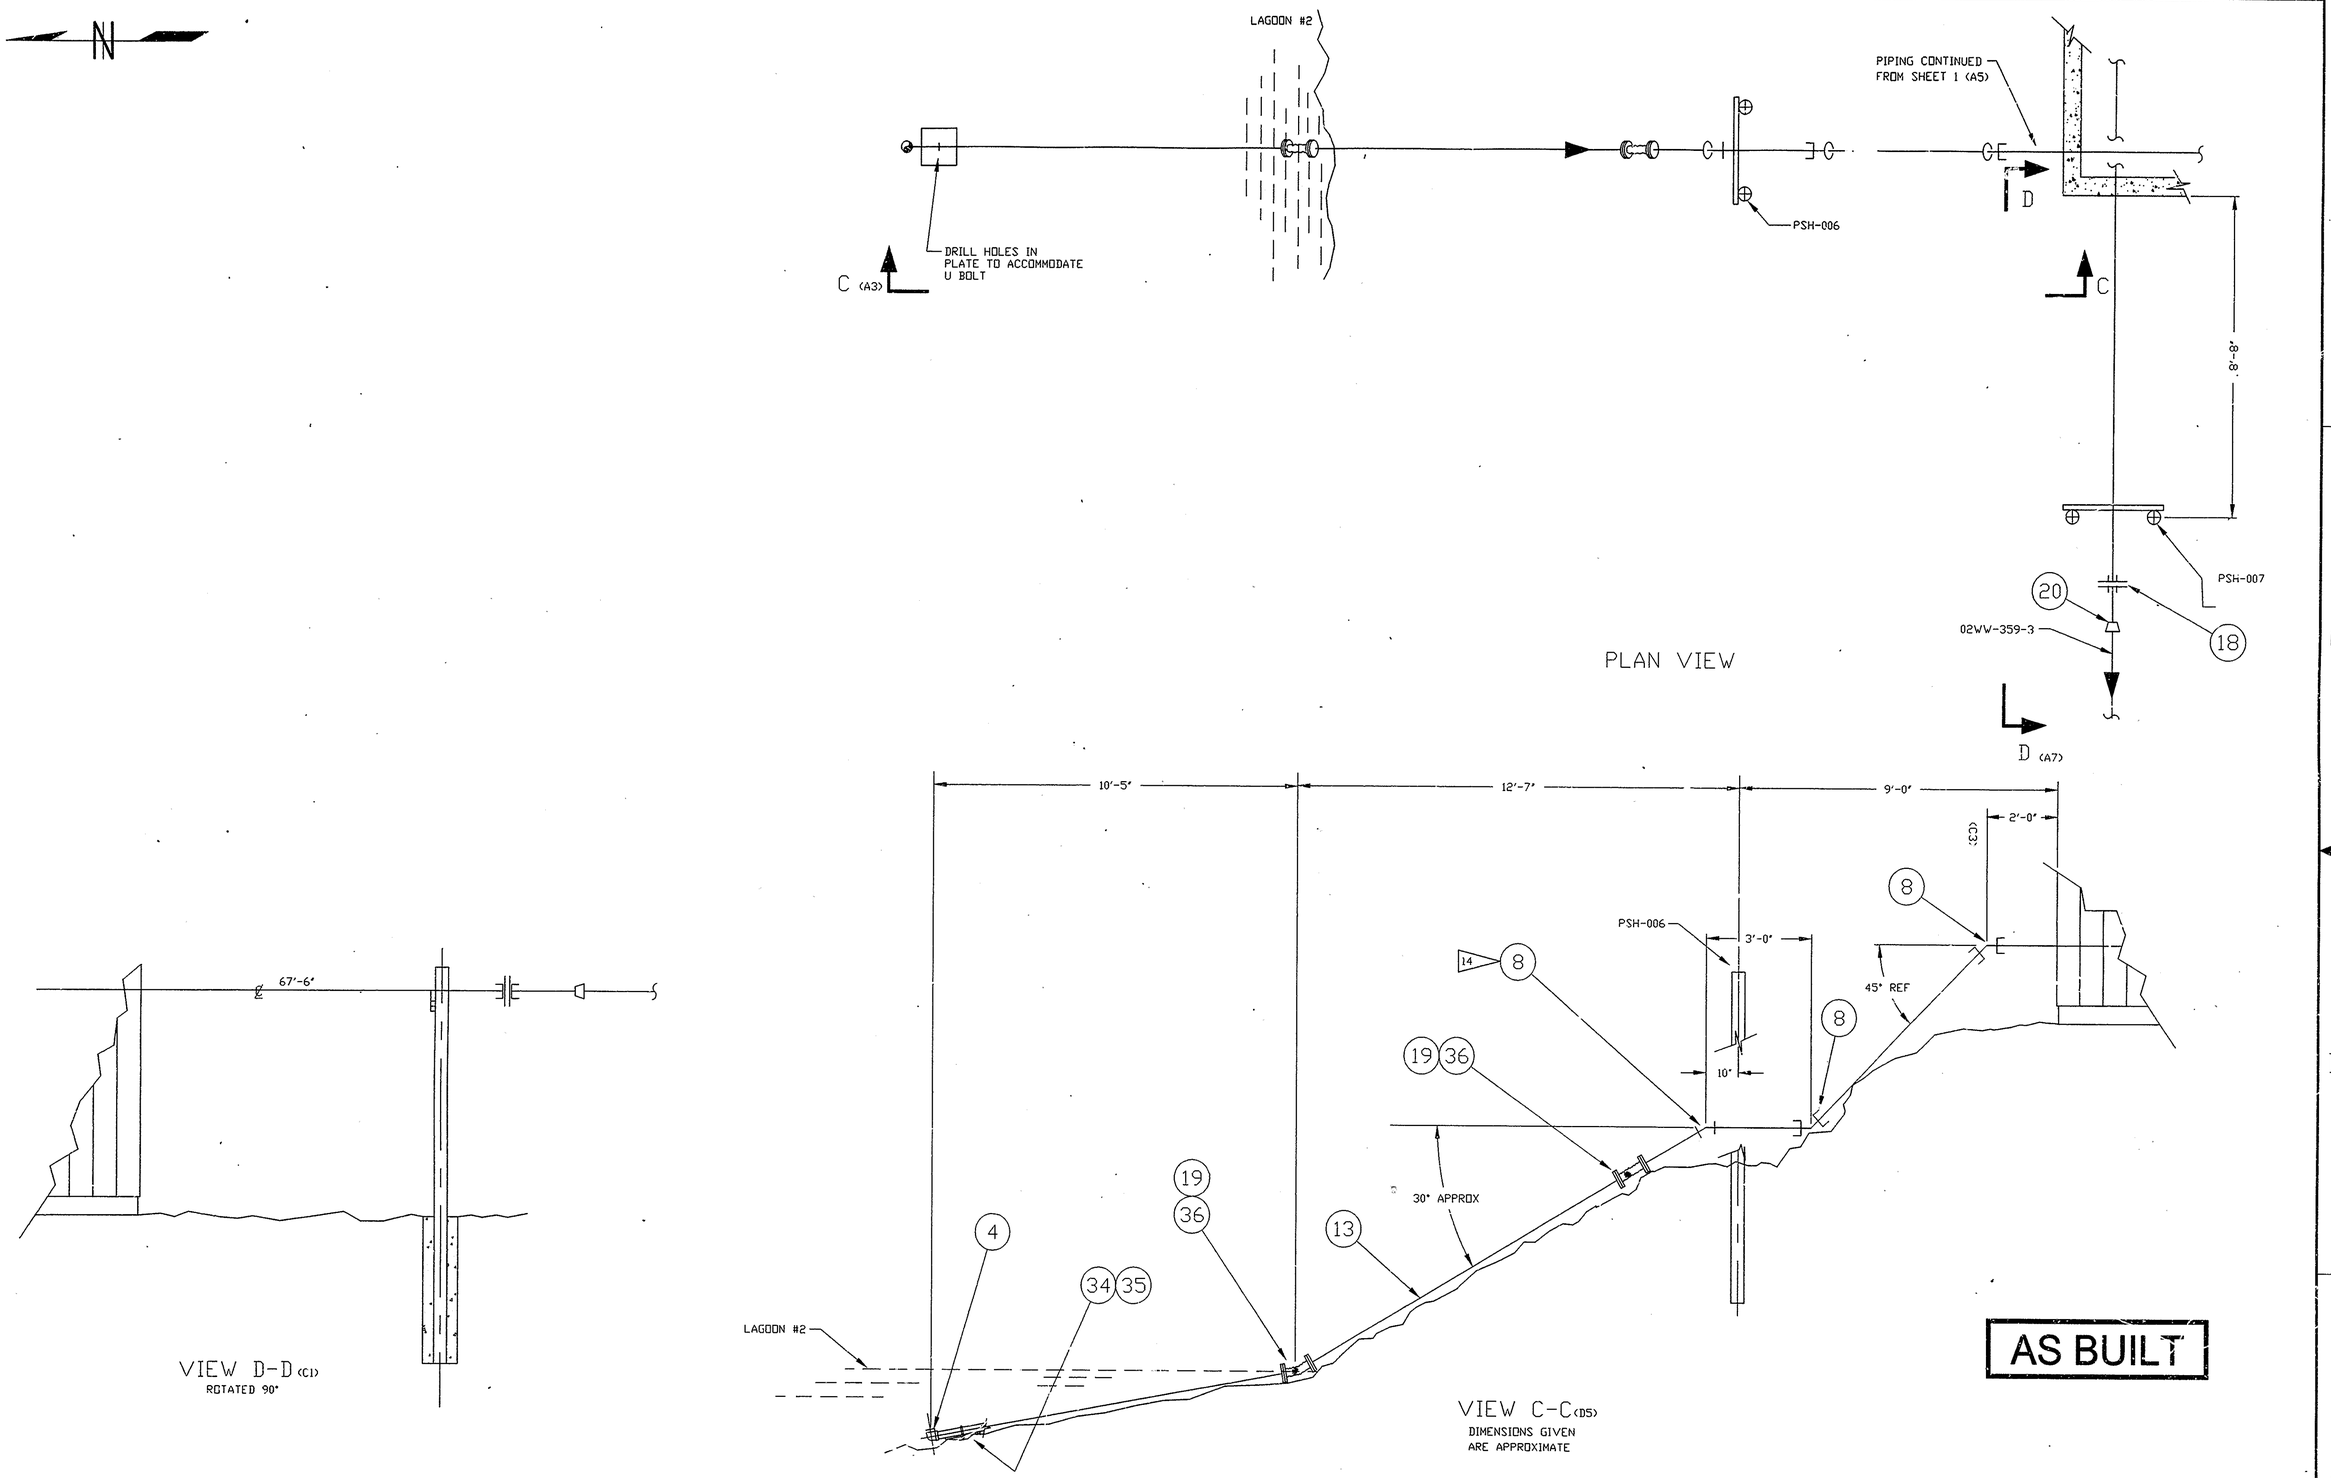

AS BUILT

REVISIONS			
REV	DESCRIPTION	APVD	
0	CREATED/ECN12170 ER4454 3/31/2000	CCG	

UNLESS OTHERWISE SPECIFIED
ALL DIM IN INCHES

FILE NAME 5016D002
PLOT SCALE 1=24.00
D SPEC # 3613
NEXT ASSEMBLY

DRAFTER M. CAPRIO	DATE 3/16/2000	Westinghouse Government Services Group
CHECKER H. BARKER	DATE 3/31/2000	WEST VALLEY NUCLEAR SERVICES CO. WEST VALLEY N.Y.
ENGINEER S. AKINBAMI	DATE 3/31/2000	

LAGOON #2/LLWTF
TRANSFER PUMP SHED
EQUIPMENT/PIPING LAYOUT

DATABASE LINKED DRAWING.
SEE ENGINEERING RELEASE FORM (ER) FOR DRAWING APPROVAL SIGNATURES.

DWG SIZE D
SCALE 1/2"=1'-0"
WEIGHT
A/E DWG #
A/E CONTRACT #
DWG # 900D-5016
REV 0
SHEET 2 OF
CODE IDENT #

CAD DRAWING-DO NOT REVISE THIS ORIGINAL

Mon Apr 03 11:10:19 2000 HAB