VERIFY ALL DOCUMENTS FOR CURRENT REVISION AND PENDING CHANGES PRIOR TO EACH USE.
INIT_____ DATE_____

906-D-014
ANHYDROUS AMMONIA
NFPA IDENTIFICATION SYSTEM

HEALTH HAZARD	3
FIRE HAZARD	1
REACTIVITY	0
SPECIFIC HAZARD	N/A

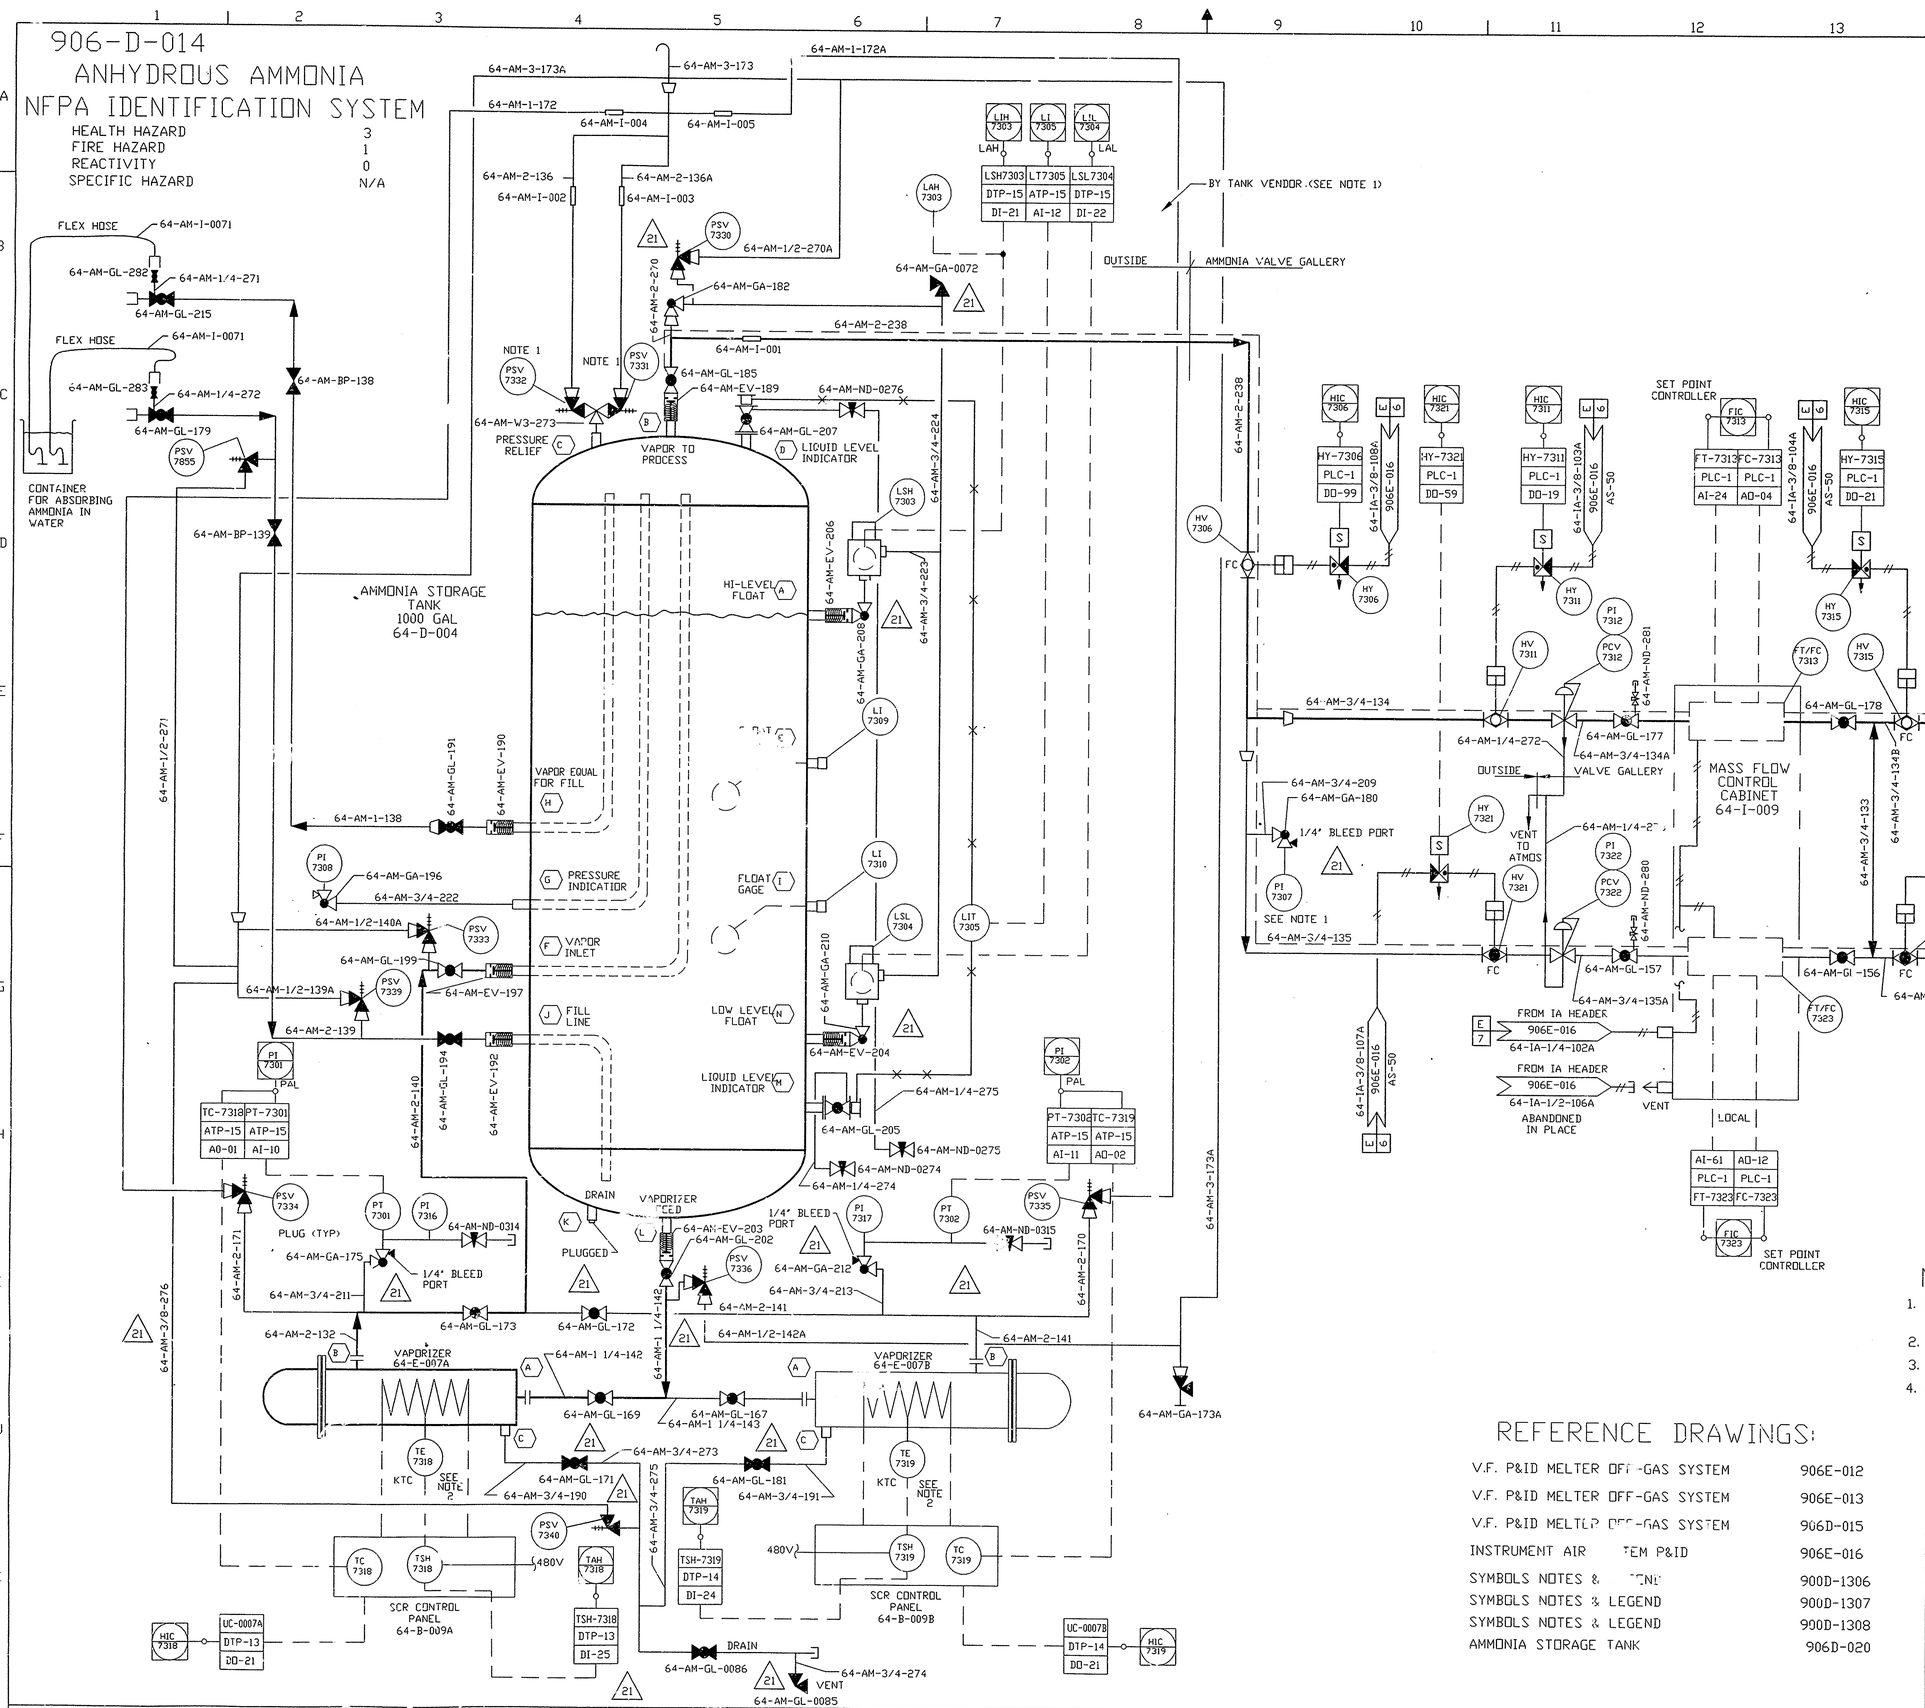

NO.	DATE	REVISION	DR	CH	APPROVED
~~B~~	~~09-18-90~~	~~GENERAL REVISION~~	~~YP~~	~~JK~~	~~RJL~~ ~~JK~~ RM ~~FJES~~
~~C~~	~~12-04-90~~	~~GENERAL REVISION~~	~~YP~~	~~JK~~	~~RJL~~ ~~JK~~ ~~FJES~~
0	9/24/91	ER 2193			JRH
16	06/26/96	REV PER ECN 10077	SAB	HAB	
17	10/18/96	ECN 10290	BP	HAB	
18	11/5/96	ECN 10349	JHS	HAB	
19	1/5/98	ECN 10840	DAK	JLH	
20	4/30/98	ECN 10768	DLL	HAB	
21	12/15/98	ECN 11726	JHS		
[illegible]	2/6/95	REV PER ECN 9397 & 9452	WCK	HAB	

NOTES:

1. PSV 7331 AND PSV 7332 ARE INCLUDED IN 64-AM-W3-273.
2. THERMOCOUPLE MOUNTED ON VAPORIZER.
3. ═══ HEAT TRACED PIPES.
4. ALL INSTRUMENT NUMBERS PREFIXED BY SYSTEM NO '64'

REFERENCE DRAWINGS:

V.F. P&ID MELTER OFF-GAS SYSTEM	906E-012
V.F. P&ID MELTER OFF-GAS SYSTEM	906E-013
V.F. P&ID MELTER OFF-GAS SYSTEM	906D-015
INSTRUMENT AIR SYSTEM P&ID	906E-016
SYMBOLS NOTES & LEGEND	900D-1306
SYMBOLS NOTES & LEGEND	900D-1307
SYMBOLS NOTES & LEGEND	900D-1308
AMMONIA STORAGE TANK	906D-020

FOR DRAWING INDEX SEE DRAWING NO._____

APPRVD WVNS CO		EBASCO SERVICES INCORPORATED A/E D.F.S. NO.2388 TASK ORDER 025
PROJECT MGR F J E STOREY	07-16-90	FOR WEST VALLEY NUCLEAR SERVICES COMPANY,INC WEST VALLEY,NEW YORK
ENGINEER SUPV F TULIPANO	07-16-90	
LEAD DISC ENGR F TULIPANO	07-16-90	WEST VALLEY DEMONSTRATION PROJECT
DESIGN R J LEWKO	07-16-90	VITRIFICATION FACILITY P&ID MELTER EX-CELL OFF-GAS SYSTEM
CHECKED P PANASCI	07-16-90	
DRAWN Y PATEL	DATE 07-16-90	

DE-AC07-81NE44139 PROJECT NO.	SIZE D	INDEX CODE NUMBER AREA / DR.TYP / CL / ORIG	DRAWING NO. 906D-014	REV. 21	
19-CWV-02275 SUBCONTRACT NO.					
ISSUED FOR CONSTRUCTION	SCALE NONE	SPEC. CODES	A/E SHEET NO. 906-D-014 C		

FILE NAME:F014D001 PLOT REQ NO. YP UIC(037,144) DATE:12-03-90

CAD DRAWING - DO NOT REVISE THIS ORIGINAL

F014D001 1=1.00

Tue Dec 15 10:26:18 1998 JLH