VERIFY ALL DOCUMENTS FOR CURRENT REVISION AND PENDING CHANGES PRIOR TO EACH USE.
INIT_____ DATE_____

AR # 344F

05/B

REV. NO.	DATE	REVISION	BY
A	2-5-90	NOTCH GRTS. G8 & G9	
B	9/5/90	PER AR 443B	CJS

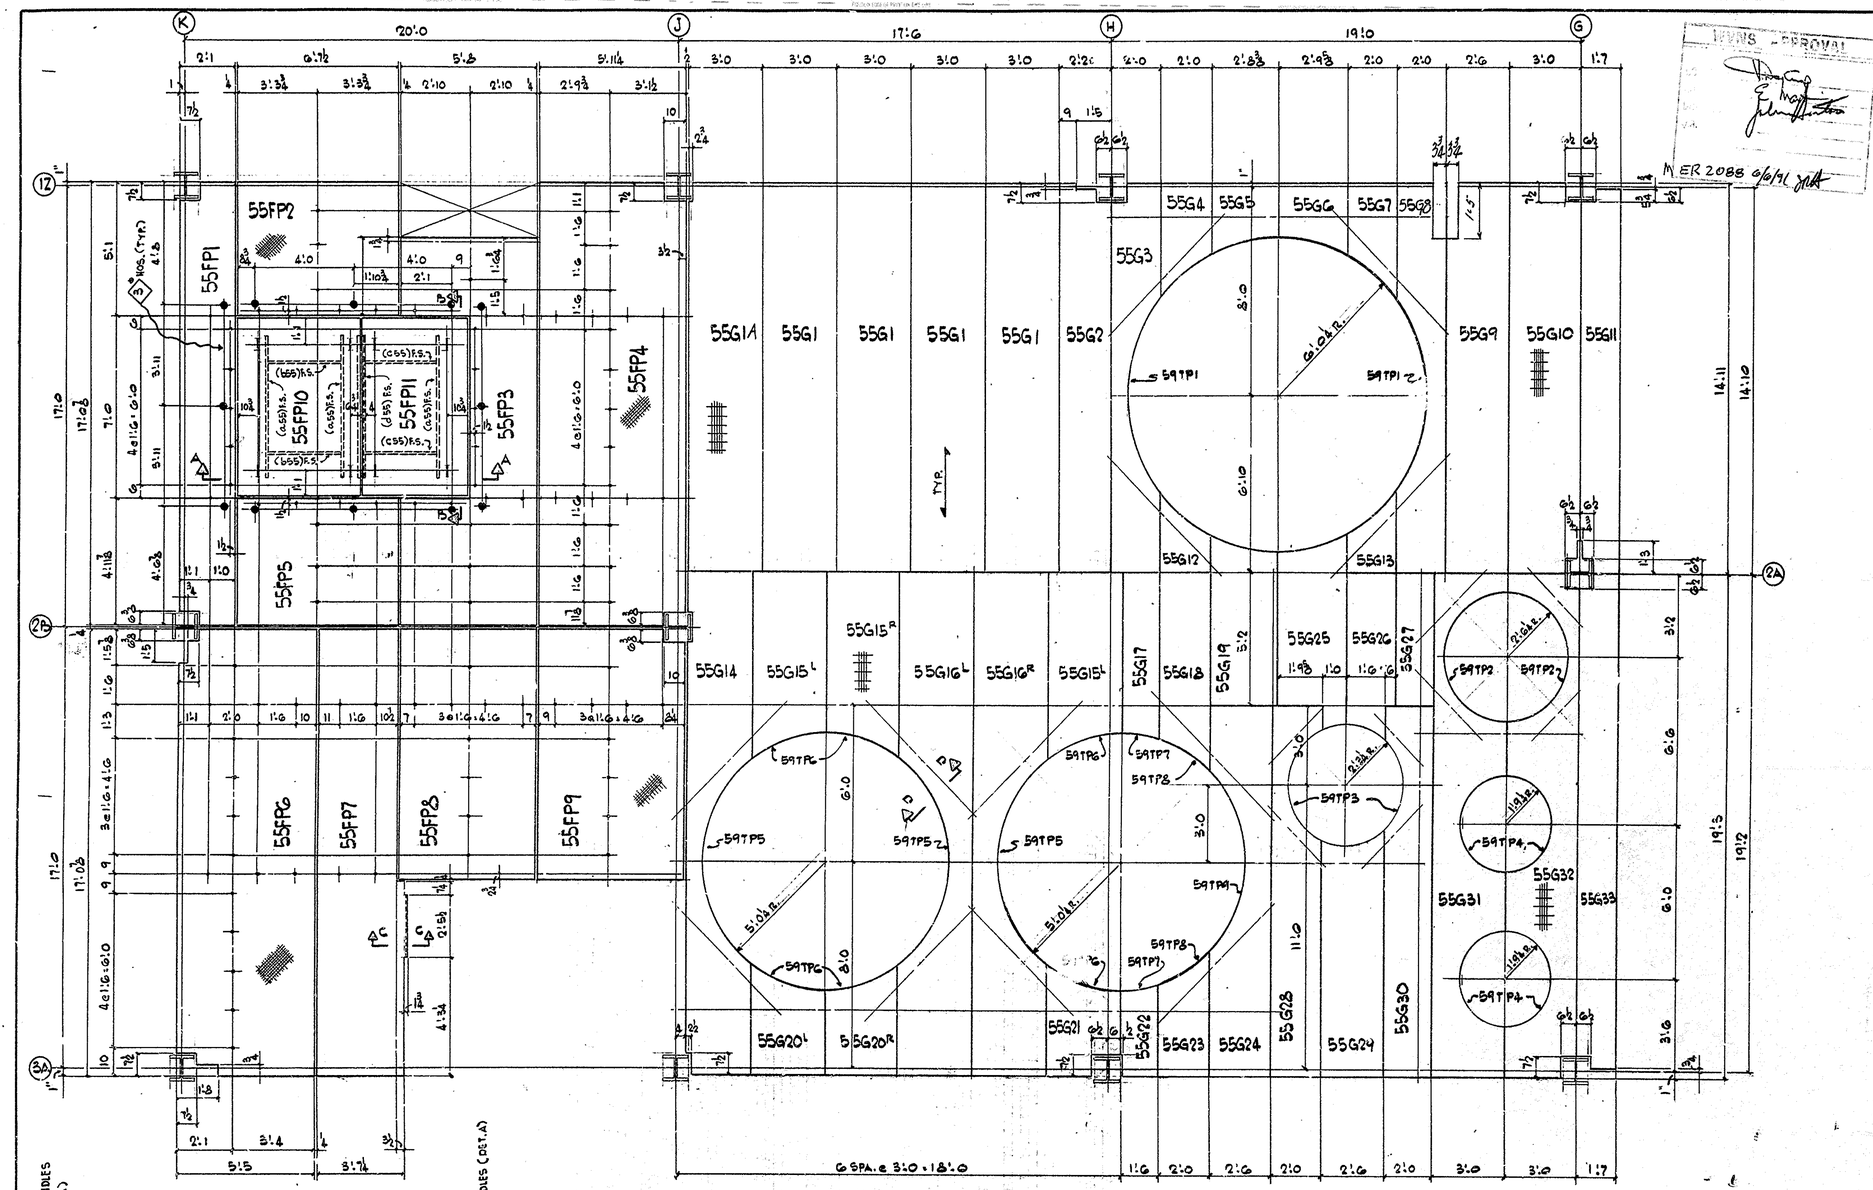

ONE - CHK'D. PL ½×25×17'-0⅜	55FP1	
ONE - ½×61×6'-7½	55FP2	
ONE - ½×68×14'-11⅜	55FP3	
ONE - ½×71¼×17'-0⅜	55FP4	
ONE - ½×59⅞×6'-7½	55FP5	
ONE - ½×65×17'-0⅜	55FP6	
ONE - ½×46⅞×17'-0⅜	55FP7	
ONE - ½×68×9'-8½	55FP8	
ONE - ½×71¼×9'-8½	55FP9	
ONE - ½×61½×6'-11½	55FP10	REMOVABLE
ONE - ½×51¾×6'-11½	55FP11	REMOVABLE

5 - GRATING AREAS - 55G1

ONE -	- 55G2
ONE -	- 55G3
ONE -	- 55G4
ONE -	- 55G5
ONE -	- 55G6
ONE -	- 55G7
ONE -	- 55G8
ONE -	- 55G9
ONE -	- 55G10
ONE -	- 55G11
ONE -	- 55G12
ONE -	- 55G13
ONE -	- 55G14
ONE -	- 55G15R
2 -	- 55G15L
ONE -	- 55G16R
ONE -	- 55G16L
ONE -	- 55G17
ONE -	- 55G18
ONE -	- 55G19
ONE -	- 55G20R
ONE -	- 55G20L
ONE -	- 55G21
ONE -	- 55G22
ONE -	- 55G23
ONE -	- 55G24
ONE -	- 55G25
ONE -	- 55G26
ONE -	- 55G27
ONE -	- 55G28
ONE -	- 55G29
ONE -	- 55G30
ONE -	- 55G31
ONE -	- 55G32
ONE -	- 55G33

REMOVABLE

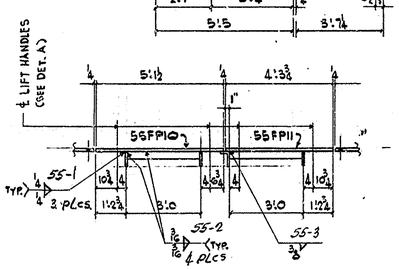

SECTION A-A

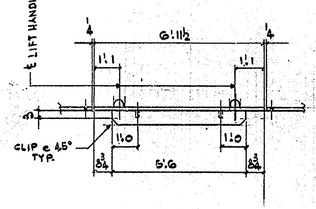

SECTION B-B

PLAN EL. 115'-0
SCALE: ⅜" = 1'-0

NOTE:
GRATING TO BE 1½×3/16 BRG. BARS GALVANIZED
BAND ALL OPENINGS

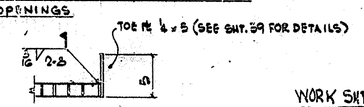

TYP. TOE PL FIELD WELDS @ OPNG'S.

WORK SHTS. 55 & 59 TOGETHER

MATERIAL LIST

3 BARS 6×½×5'-6 (a55)
2 BARS 3×½×2'-11½ (b55)
2 BARS 3×½×2'-11¾ (c55)
ONE L6×4×½×5'-6 (d55)

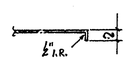

SECTION C-C

3'-8 19/32	1 15/32 = 4 6/16

SHOP INFO.

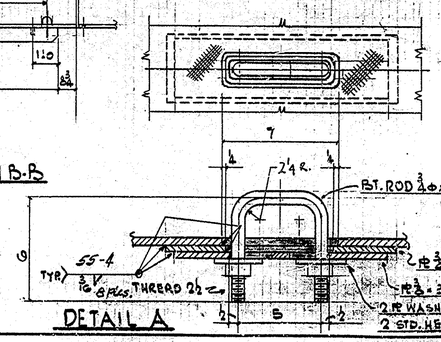

DETAIL A

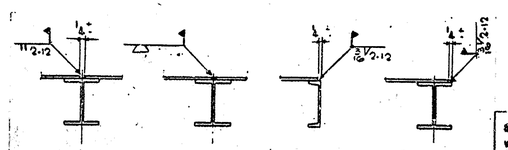

TYPICAL FIELD WELDING OF FLOOR PLATES

REF. DWG. 905-D-175 (E59)

MER 2088 6/6/91

344F

VENDOR SUBMITTAL REVIEW
DOCUMENT NO. AR 344F
APPROVED
APPROVED AS NOTED
DISAPPROVED
FOR INFORMATION ONLY
MIR 9-24-96
REVIEWER DATE

OEHLER INDUSTRIES, INC.
242 ELK STREET • BUFFALO, NEW YORK 14210

SHOP NOTES:
WELD - E70 XX
HOLES 13/16 DIA. UNLESS NOTED
PAINT -

JOB TITLE: WEST VALLEY DEMONSTRATION PROJECT
GOLD CHEMICAL BLDG.
FLOOR PL & GRATING @ EL. 115'-0

DATE 12/89	JOB NUMBER A9.222	DWG. OR SHT. NO. 55	REV. B
DRAWN BY	CHECKED BY RTG		