VERIFY ALL DOCUMENTS FOR CURRENT REVISION AND PENDING CHANGES PRIOR TO EACH USE.
INIT_____ DATE_____

905-D-179

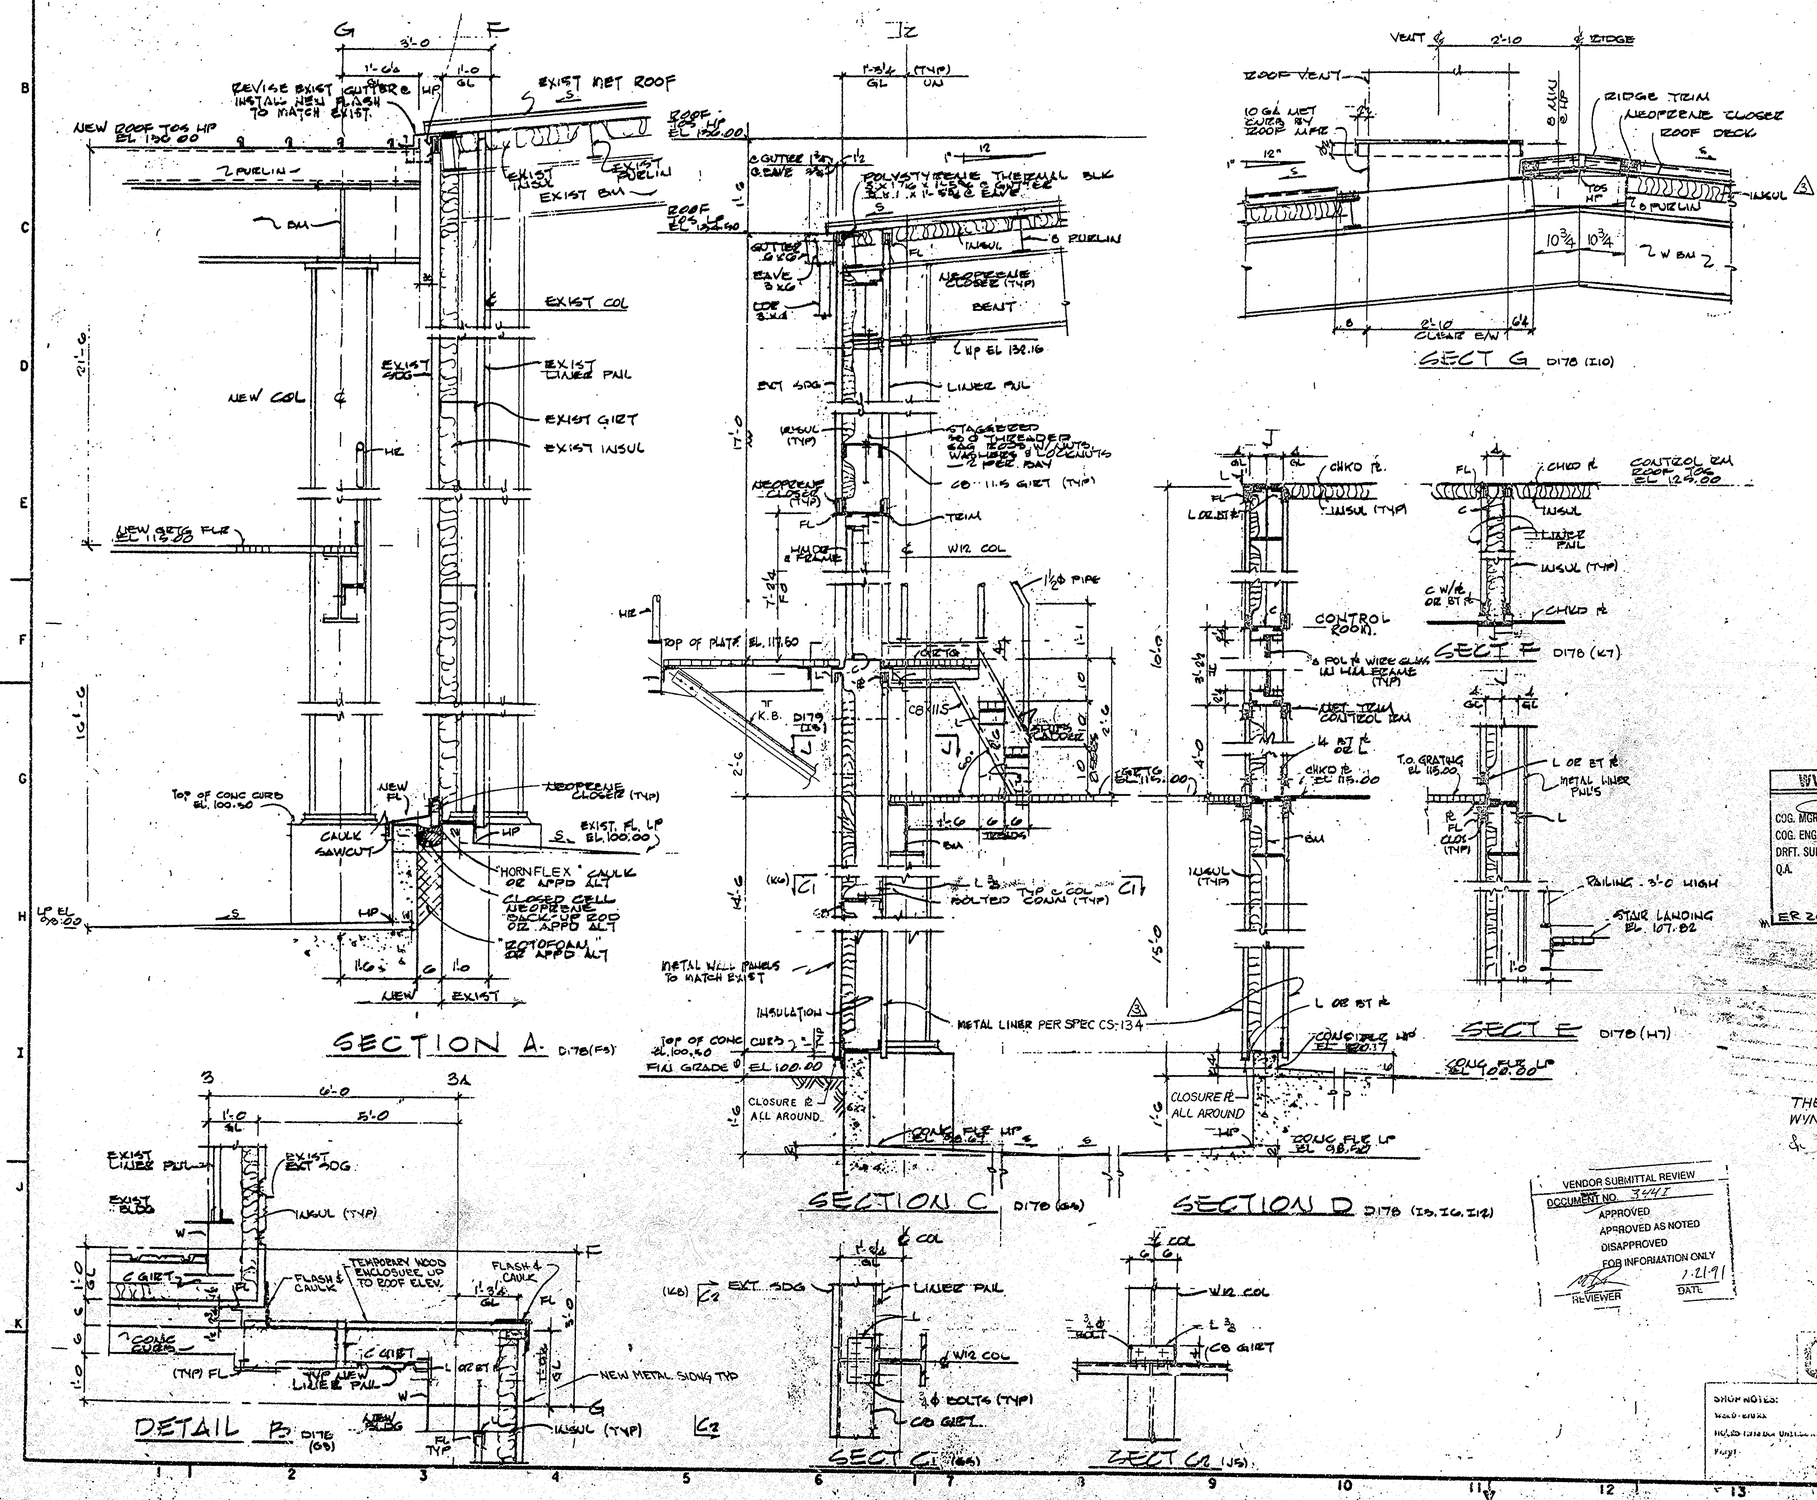

GENERAL NOTES:

1) METAL SIDING, LINER PANELS, ROOF PANELS AND INSULATION FOR THE COLD CHEM BUILDING. SEE SPEC. WVNS-CS-134, SECTION 05300

3 2) PERSONNEL DOORS, FRAMES, WINDOWS, HARDWARE AND ROLL-UP DOOR: SEE SECTIONS 08100 AND 08200 OF SPEC. WVNS-CS-134.

WVNS APPROVAL
COG. MGR.
COG. ENGR.
DRFT. SUPR.
Q.A.
ER 2088 6/6/91

PO# 33945 AR# 344I

[X] APPROVED
[ ] APPROVED WITH COMMENTS
[ ] DISAPPROVED
[ ] RECEIPT ACKNOWLEDGED
SIGNER S.R. [signature] COGNIZANT ENGINEER

THE WORK ON THIS DRAWING IS PART OF SPECIFICATION WVNS-CS-134 UNLESS NOTED. AT Zones (14) & Related Details per Ecn 3227

VENDOR SUBMITTAL REVIEW
DOCUMENT NO. 344I
APPROVED
APPROVED AS NOTED
DISAPPROVED
FOR INFORMATION ONLY
REVIEWER 1-21-91 DATE

REV NO.	DATE	REVISION	BY
A	3-24-90	AS BUILT	JCY

WVNS REF. DWG. 905-D-179

OEHLER INDUSTRIES, INC.
242 ELK STREET • BUFFALO, NEW YORK 14210

SHOP NOTES:
WELD-BLACK
HOLES FOR BOLTS UNLESS NOTED
PAINT

JOB TITLE WEST VALLEY DEMONSTRATION PROJECT
COLD CHEMICAL BLDG.
ARCH. SECTIONS

DATE 9/89 JOB NUMBER 89-222
DRAWN BY CHECKED BY

E65 A