VERIFY ALL DOCUMENTS FOR CURRENT REVISION AND PENDING CHANGES PRIOR TO EACH USE.
INIT_____ DATE_____

REV NO	DATE	REVISION	DR	CH	APPROVED
B	5-21-87	~~REV & RELOC LVR DWL~~	~~KA~~	~~AG~~	~~[illegible]~~
O	6/5/87	ER 1067			
14	5/8/95	REV/ECN TM-0288	PD		MCM
15	1/8/95	REV/ECN TM-1916	AJ	KQ	
16	7/30/96	ECN 10149	LRP	EJS	
17	7-28-99	ECN 11023	GW	VAD	
5	11-13-87	REV. PER ECN 3229 3233	GW	DRS	VAD
6	4-3-90	REV ECN. VF-1-106	GW	DRS	VAD
7	7-10-90	ECN 3744	BP	TEC	VAD
8	7-3-91	REV/ECN 4504	EMS	HAB	VAD
9	11-5-91	REV/ECN 4501	EMS	HAB	ELC
10	2-18-92	REV/ECN 4911	GW	HAB	VAD
11	10-22-92	REV/ECN 5567	GW	HAB	VAD
12	4/29/94	REV/ECN 7607	DMM	KQ	DMM
13	3/11/96	ECN 8673	[illegible]	HAB	[illegible]

THIS DWG IS PART OF CS-134-EXCEPT AS NOTED BELOW:

CS-194 ZONES (F5, E16) AND RELATED DETAILS
CS-139 ZONES (A4, C4, C6, A12, B13, E10, E12, E9, G10, G12, J10, H7, I2, H5, I14, J2, J14 AND DETAILS

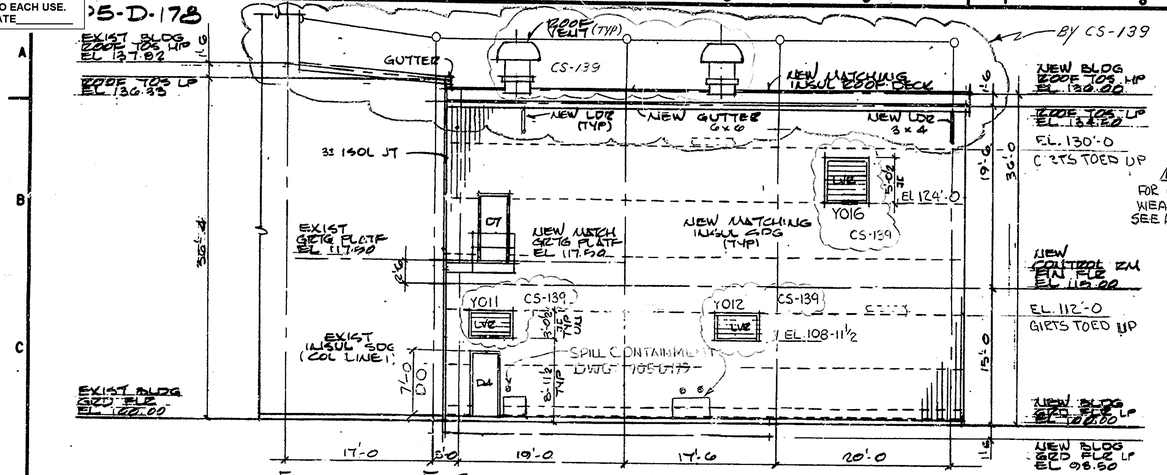

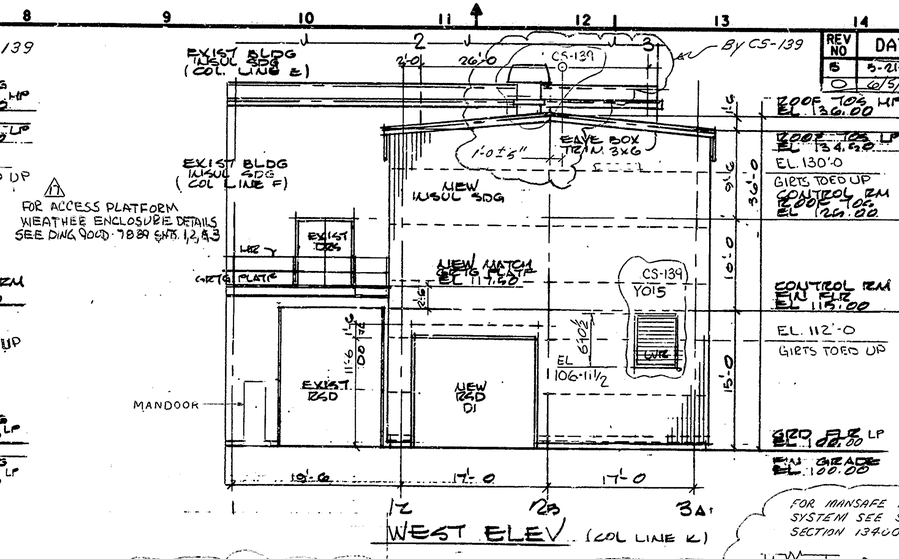

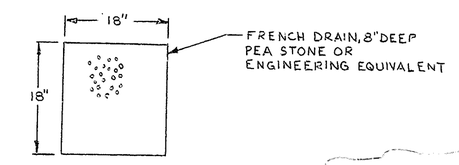

DETAIL "R" (J2, K3, H4, 905D-733 (I6)) SCALE - 1" = 1'-0"

D179 (H3)

N

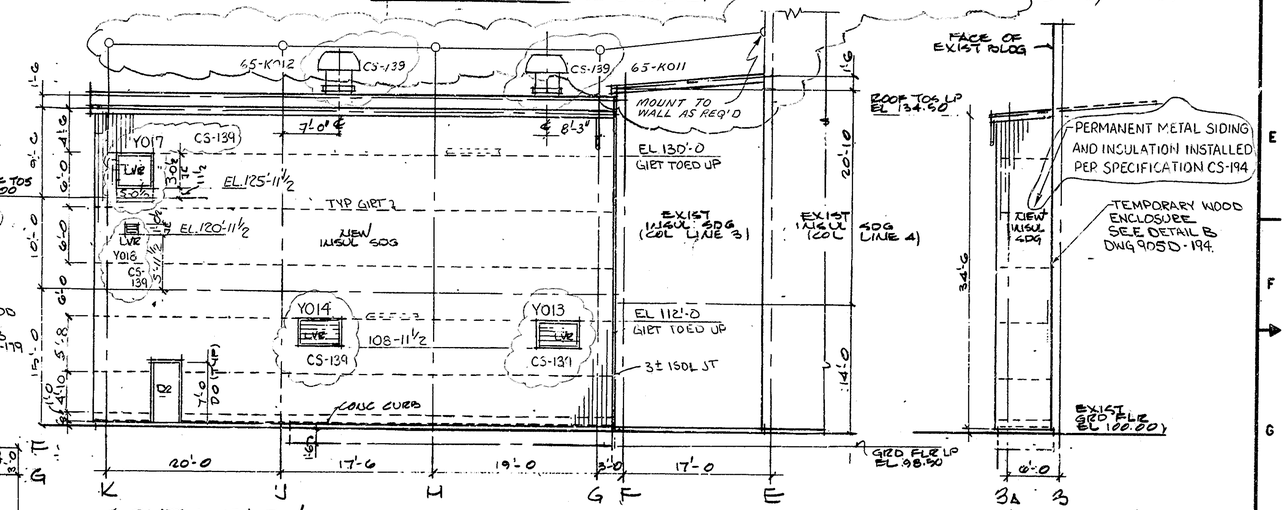

CS-194
DURING INSTALLATION OF VIT FAC SIDING (DWG 905D-731 THRU 741), REMOVE TEMPORARY WOOD ENCLOSURE AND CONTINUE SOUTH WALL TO NEW VF SIDING. UTILIZE CLOSURE DETAILS SIMILAR TO NORTH WALL. INSTALL HORN FLEX CAULK CLOSED CELL NEOPRENE BACKING BAR AND FLASHING PER SECT. A-A DWG 905D-179.

TEMPORARY WOOD ENCLOSURE CS-134 — FOR ACCESS PLATFORM WEATHER ENCLOSURE DETAILS SEE DWG. 905D-789 SHTS 1, 2, & 3

CS-134 TEMPORARY WOOD INCLOSURE SEE DETAIL B DW 905D-179

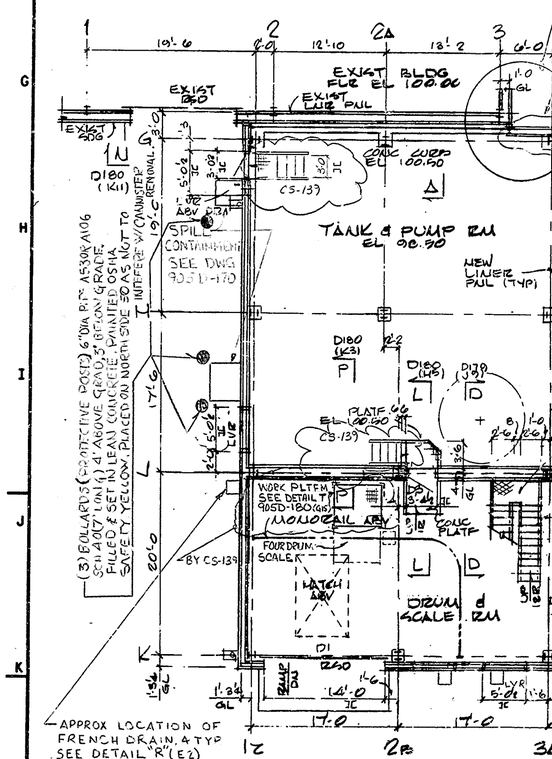

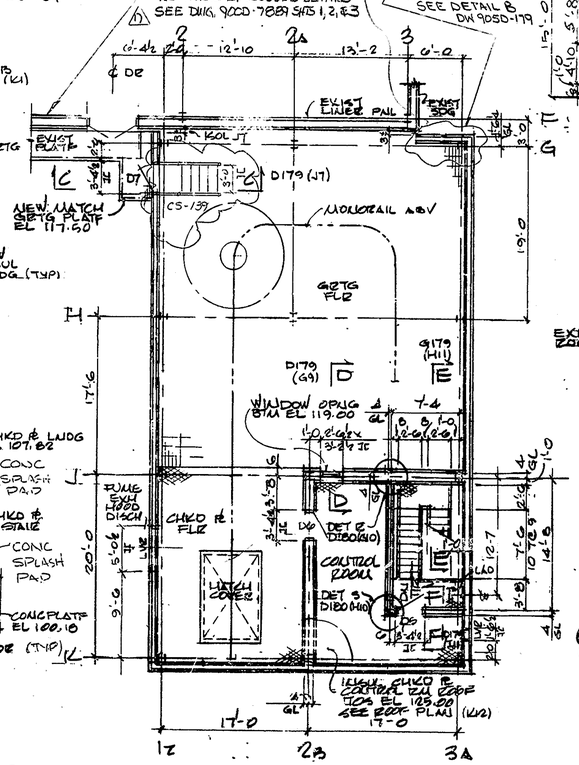

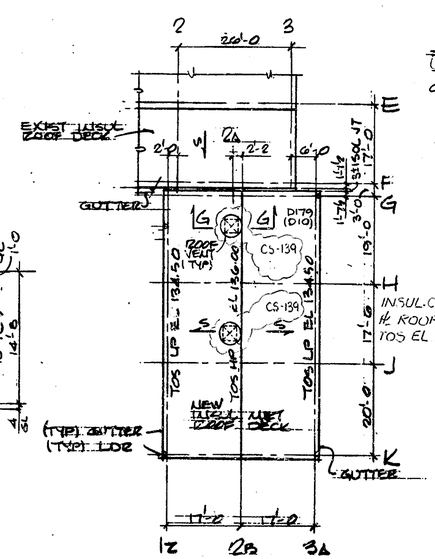

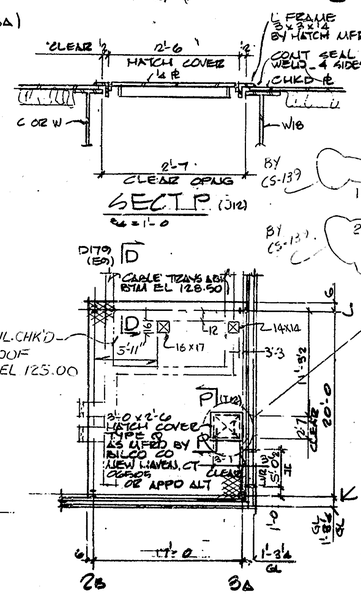

NOTES

FOR CS-134 GEN NOTES SEE DWG 905-D-178
FOR CS-139 SEE GENERAL NOTES DWG 905-D-710
1 ROOF VENTS, LOUVER DAMPERS ARE NOT PART OF SPECIFICATION WVNS-CS-134.
2 FOR ROOF VENTS, LOUVERS DAMPERS SEE SPECIFICATION WVNS-CS-139

BY CS-139

SEE DETAIL 32 905D-180 — BY CS-139

5-14-87 FOR DRAWING INDEX SEE DRAWING NO.

APPRVD WVNS CO.		6/5/87
PROJECT MGR.		5/15/87
ENGINEER SUBV.		5/15/87
LEAD DISC ENGR		5/15/87
DESIGN	BILAK	5/15/87
CHECKED		5/15/87
DRAWN	BILAK	DATE 5/12/87

EBASCO SERVICES INCORPORATED
A/E O.F.S. NO. 2388 TASK ORDER 009
FOR WEST VALLEY NUCLEAR SERVICES COMPANY, INC WEST VALLEY, NEW YORK
WEST VALLEY DEMONSTRATION PROJECT
COLD CHEM BLDG ARCH PLANS & ELEV

DE-AC07-81NE44139 PROJECT NO.
19-CWV-02275 SUBCONTRACT NO.
ISSUED FOR CONSTRUCTION

SIZE	INDEX CODE NUMBER (AREA, DR. TYP, CL, ORIG)	DRAWING NO.	REV.
D		905D-178	17

SCALE 1/8"=1'-0" SPEC. CODES A/E SHEET NO. 905-D-178B