VERIFY ALL DOCUMENTS FOR CURRENT REVISION AND PENDING CHANGES PRIOR TO EACH USE.
INIT_____ DATE_____

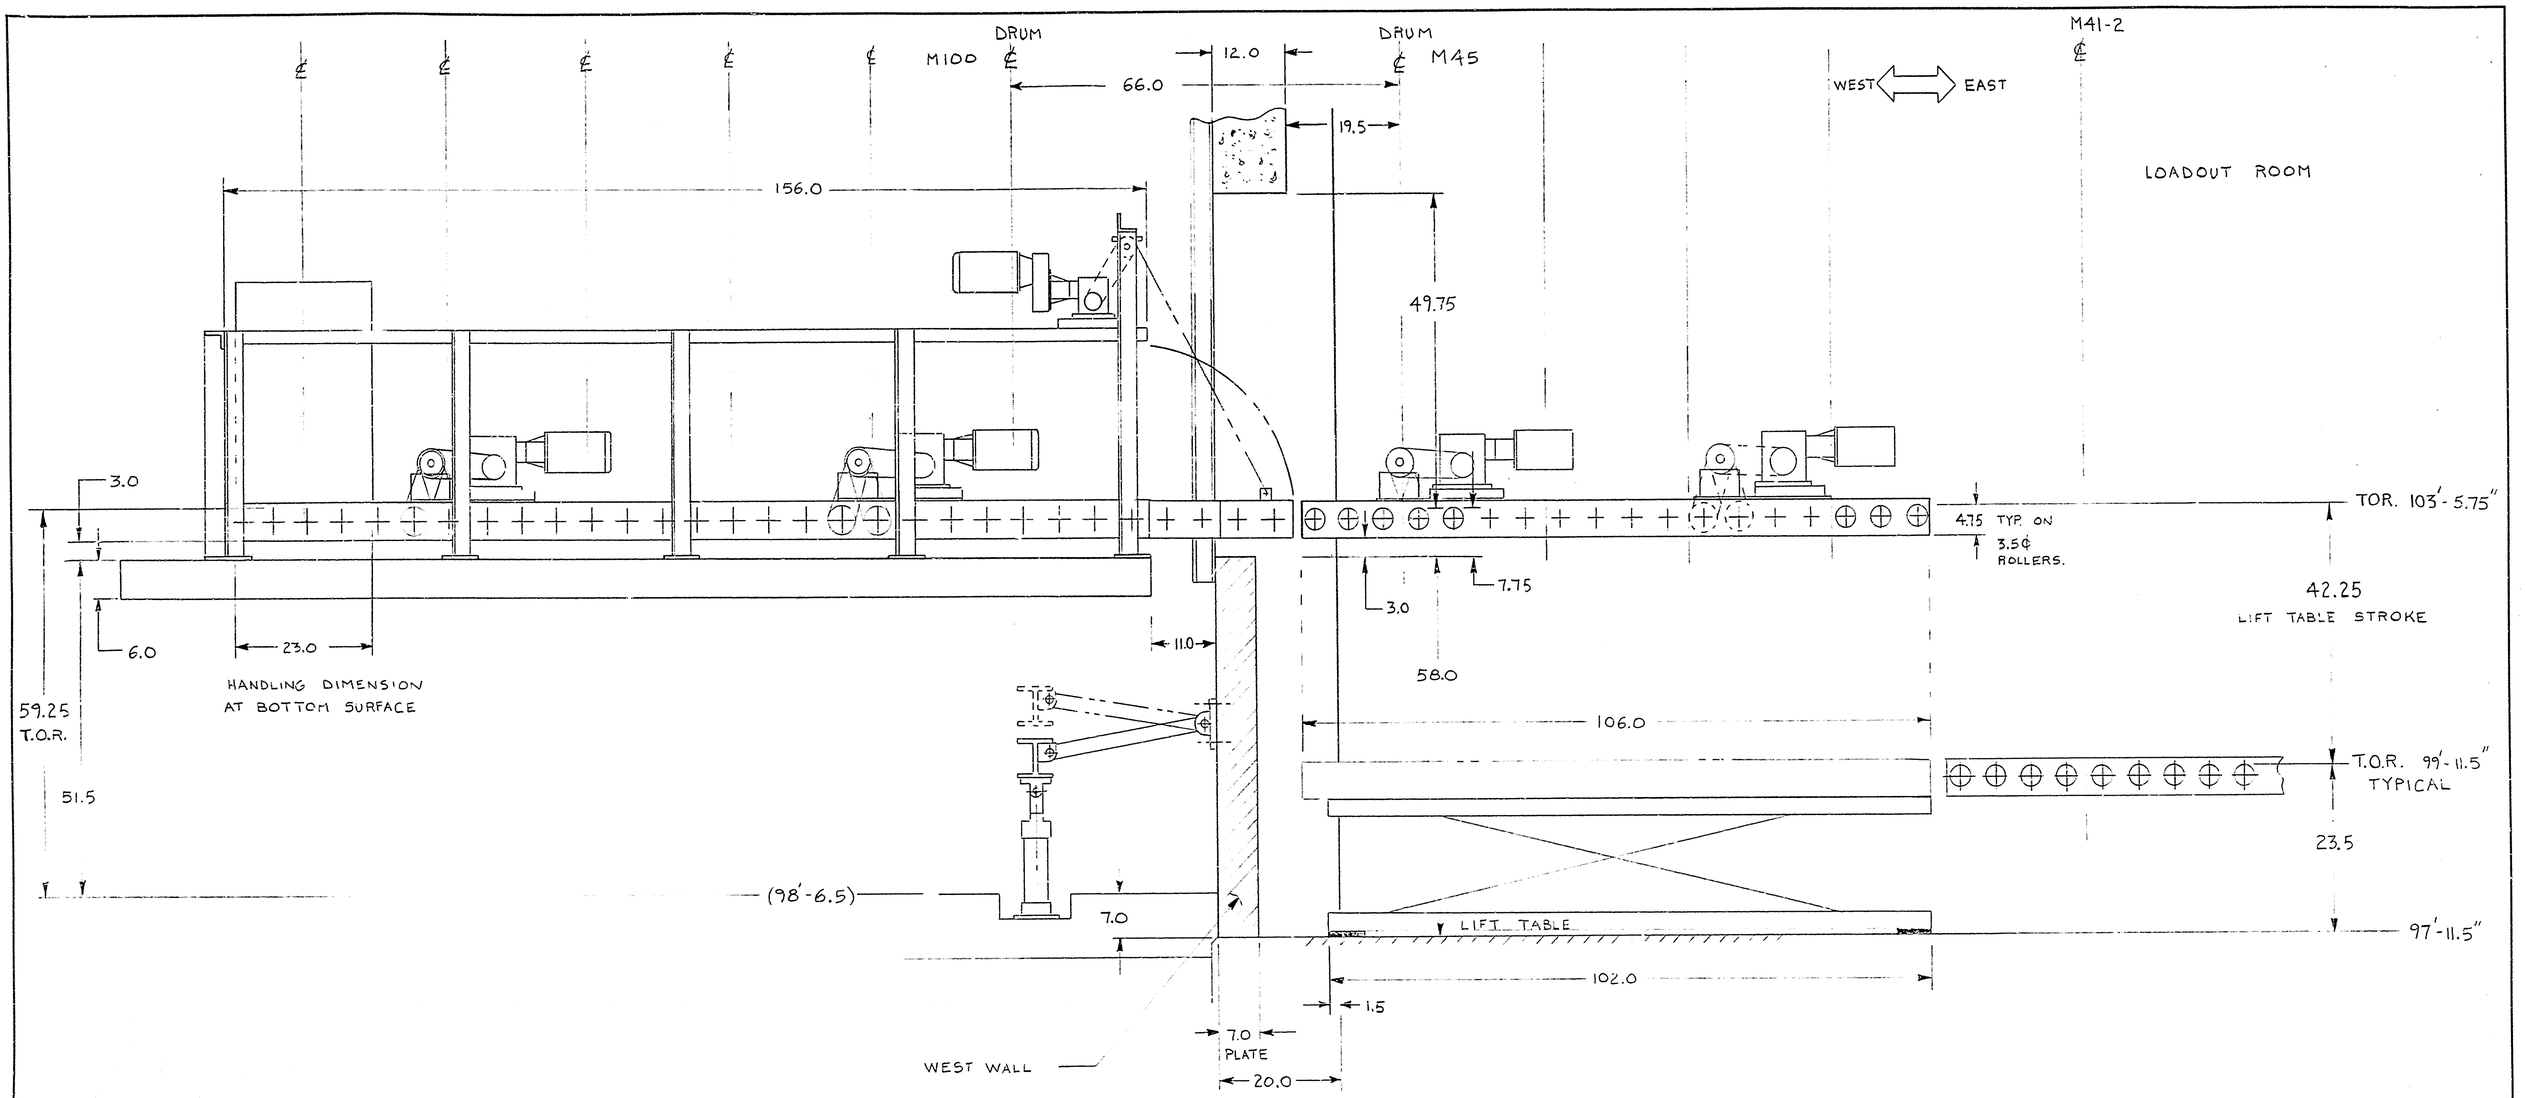

NOTE:

- T.O.R. ELEVATION OF M14 IS 100'-0".
- ELEVATION OF M45 & M100 MUST BE EQUAL AT T.O.R.
- FLOOR SLOPES DOWNWARD TO EAST FROM 98'-0" AT WEST WALL BY 3.0 INCHES IN 462.0 (38'-6").

TOLERANCE = +/- .06"
UNLESS OTHERWISE SPECIFIED

APPROVALS	
PROJECT MANAGER	9-4-86
PRODUCT MANAGER	9-4-86
CHIEF ENGINEER	4 Sept 86
DESIGN ENGINEER	9/4/86

REV	ECN	DESCRIPTION	DATE	APPR
O	—	ER1065	7/20/87	
D	047	AS BUILT CONDITION	3/24/87	
C	028	ADDED TOL. & REV. BLOCK	2/2/87	
B	010	SEE ECN 010 SH. 1-3	10/10/01	
A	008	SEE ECN 008 SH 1-3	9/27/86	

WEST VALLEY NUCLEAR SERVICES

RADWASTE TREATMENT SYSTEM

W. O. | HANDLING TECHNOLOGY, INC. FAIRPORT, N.Y. | REV. O

DRAWN McGoldrick DATE 9-4-86 | DWG. NO. 011-09-10 | SHEET 3 OF 4

SCALE 1" = 12"

SYSTEM ARRANGEMENT

THIS DWG AND THE DESIGN CONTAINED THEREIN IS THE PROPERTY OF HANDLING TECHNOLOGY, INC., FAIRPORT, N.Y. AND IS NOT TO BE COPIED WITHOUT THEIR CONSENT