VERIFY ALL DOCUMENTS FOR CURRENT REVISION AND PENDING CHANGES PRIOR TO EACH USE.
INIT_____ DATE_____

900D-371

DRAWING NO. 2401-01-801-22

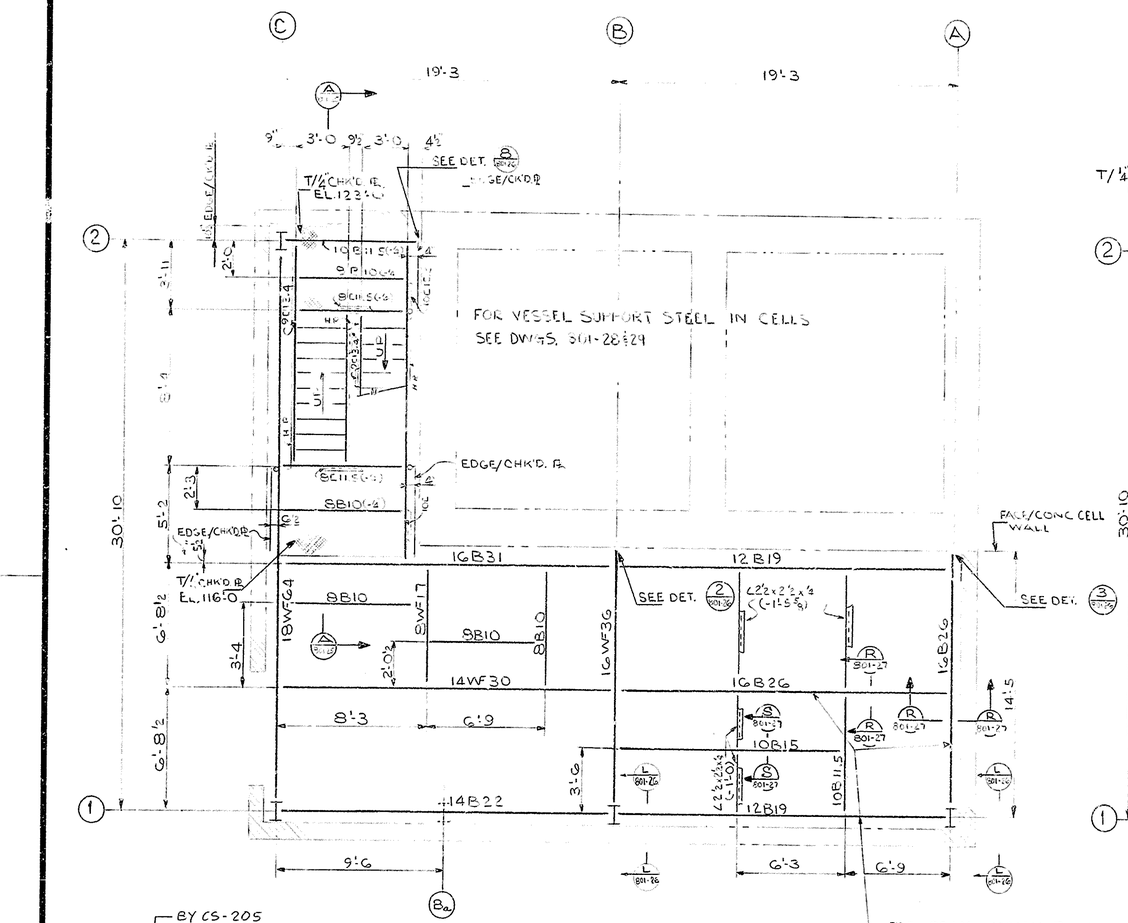

FRAMING PLAN @ EL. 116'-0
T/STEEL (-5½") (UNLESS NOTED)

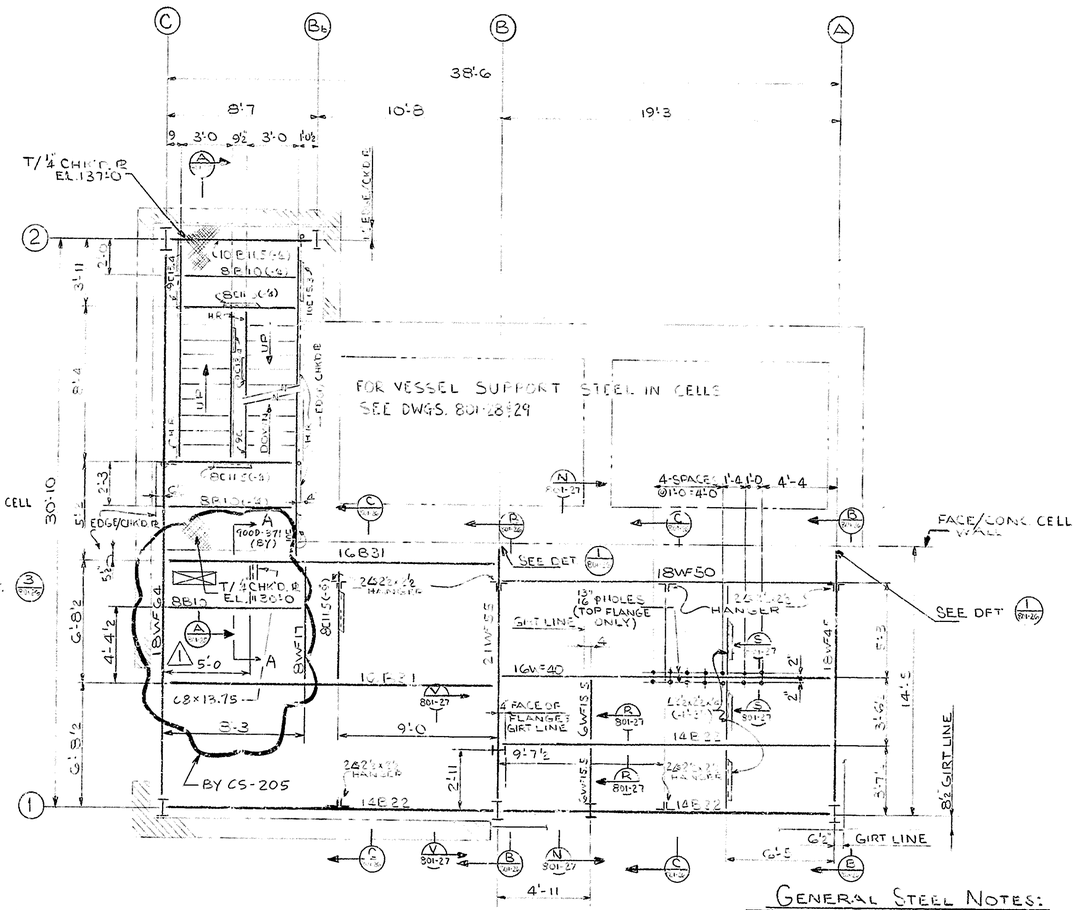

FRAMING PLAN @ EL. 130'-0
T/STEEL (-5½") (UNLESS NOTED)

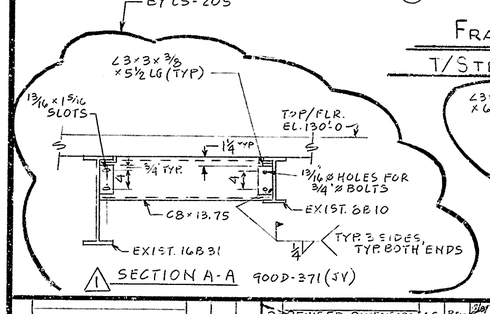

SECTION A-A 900D-371 (SY)

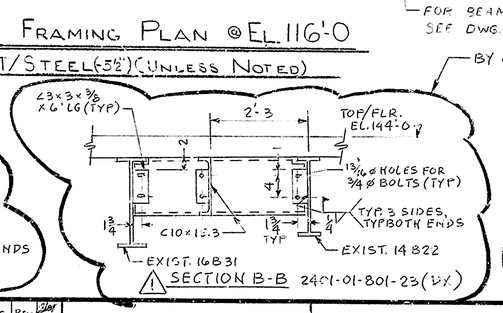

SECTION B-B 2401-01-801-23 (SY)

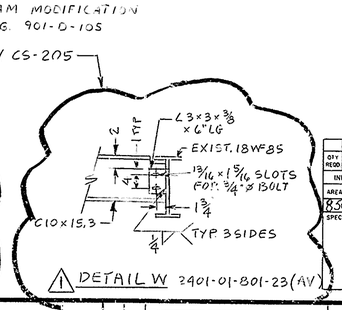

DETAIL W 2401-01-801-23 (AV)

GENERAL STEEL NOTES:

1.) ALL HANDRAIL TO BE B.K. STANDARD SS-32-1 TYPE-A.
2.) FOR STEEL LADDER DETAILS SEE B.K. STANDARDS SS 31-B & SS 31-1 TYPE A WALK THRU.
3) ALL HOLES TO BE 13/16" ø UNLESS NOTED.
4) SPECIFICATIONS:
   STRUCTURAL METALS S5.11
   MISCELLANEOUS METALS S5.12
5) FOR ADDITIONAL BLDG DETAILS SEE ARCHITECTURAL DWGS. 801-51 THRU 61
6) FOR ELEVATED CONC. SLAB DETAILS SEE DWGS (illegible)
7) FOR CHECKERED PL FASTENING DETAILS SEE DWG. 801-25.

QTY REQD	SYM	"CW" NO	NOMENCLATURE OR DESCRIPTION	CODE IDENT NO	PART OR IDENT NO	MATERIAL	SPECIFICATION	ZONE

PARTS LIST

INDEX CODE NUMBER	UNLESS OTHERWISE SPECIFIED	CONTRACT NO	DATE OF DWG 10/1/69	A/E CONTRACT NO	CODE IDENT NO
AREA 8.50/09 / DWG TYPE 70/01 / CL / DWG	TOLERANCES - DO NOT SCALE	DRAWER	DTG SUPVR	FOR West Valley Nuclear Services Co., Inc. West Valley, New York	
SPEC CODE	DPL DEC / DPL FRC / ANGLES / FRACTIONS	DESIGN	GROUP	CEMENT SOLIDIFICATION SYSTEM	
		FACILITIES		SCALE / WEIGHT / A/E DWG NO	900-D-371 / SHEET OF / REV 1

REV. NO.	DESCRIPTION	MADE BY	CHKD BY	DATE CHKD
4	REV PER FCN NOX-0381 ~~ADDED EXTRA ANGLES~~	JH / WG	DRS / RD	5-9-72 / 1-28-71
3	REVISED DIMENSION	JG	RD	3/4/70
2	REVISED FRAMING PLANS, EL. 116'-0" & EL. 130'-0"	JG	RD	11/20/70
1	REV. 1, 5, 6 DIMENSIONS & REVISED HOLDS	JG	RD	4-27-70

FORM No. E-355-REV. 6-68

NO.	REV.	RELEASED FOR	APP.	DATE

	BY	DATE		BY	DATE
AE PR.	WAO	3/3/70	DRAWN	J. GEORGE	2-16-70
APPR.	W. BELL	3/20/70	TRCD.		
APPR.			CHKD.	R. DeBROSSARD	2-16-70
APPR.					

SCALE 1/4" = 1'-0"

UNIT
TITLE
IODINE RECOVERY BLDG. AREA 8.01.14
STRUCTURAL
SECOND & THIRD FLOOR FRAMING PLANS
FOR
NUCLEAR FUEL SERVICES, INC. N.Y.

BLAW-KNOX COMPANY
CHEMICAL PLANTS DIVISION
PITTSBURGH, PENNSYLVANIA

DRAWING NUMBER ~~2401-01-801-22~~ REV. X

COLOR WARNING: PRINTS OF THIS DRAWING ON PINK PAPER ARE "PRELIMINARY" AND SHALL NOT BE USED FOR MANUFACTURING OR CONSTRUCTION PURPOSES.

THIS DRAWING AND THE INFORMATION IT CONTAINS ARE THE PROPERTY OF THE BLAW-KNOX COMPANY. IT IS NOT TO BE COPIED OR TRACED, NOR IS THE INFORMATION TO BE MISUSED IN ANY WAY.

"D"