905-D-047 S02 C

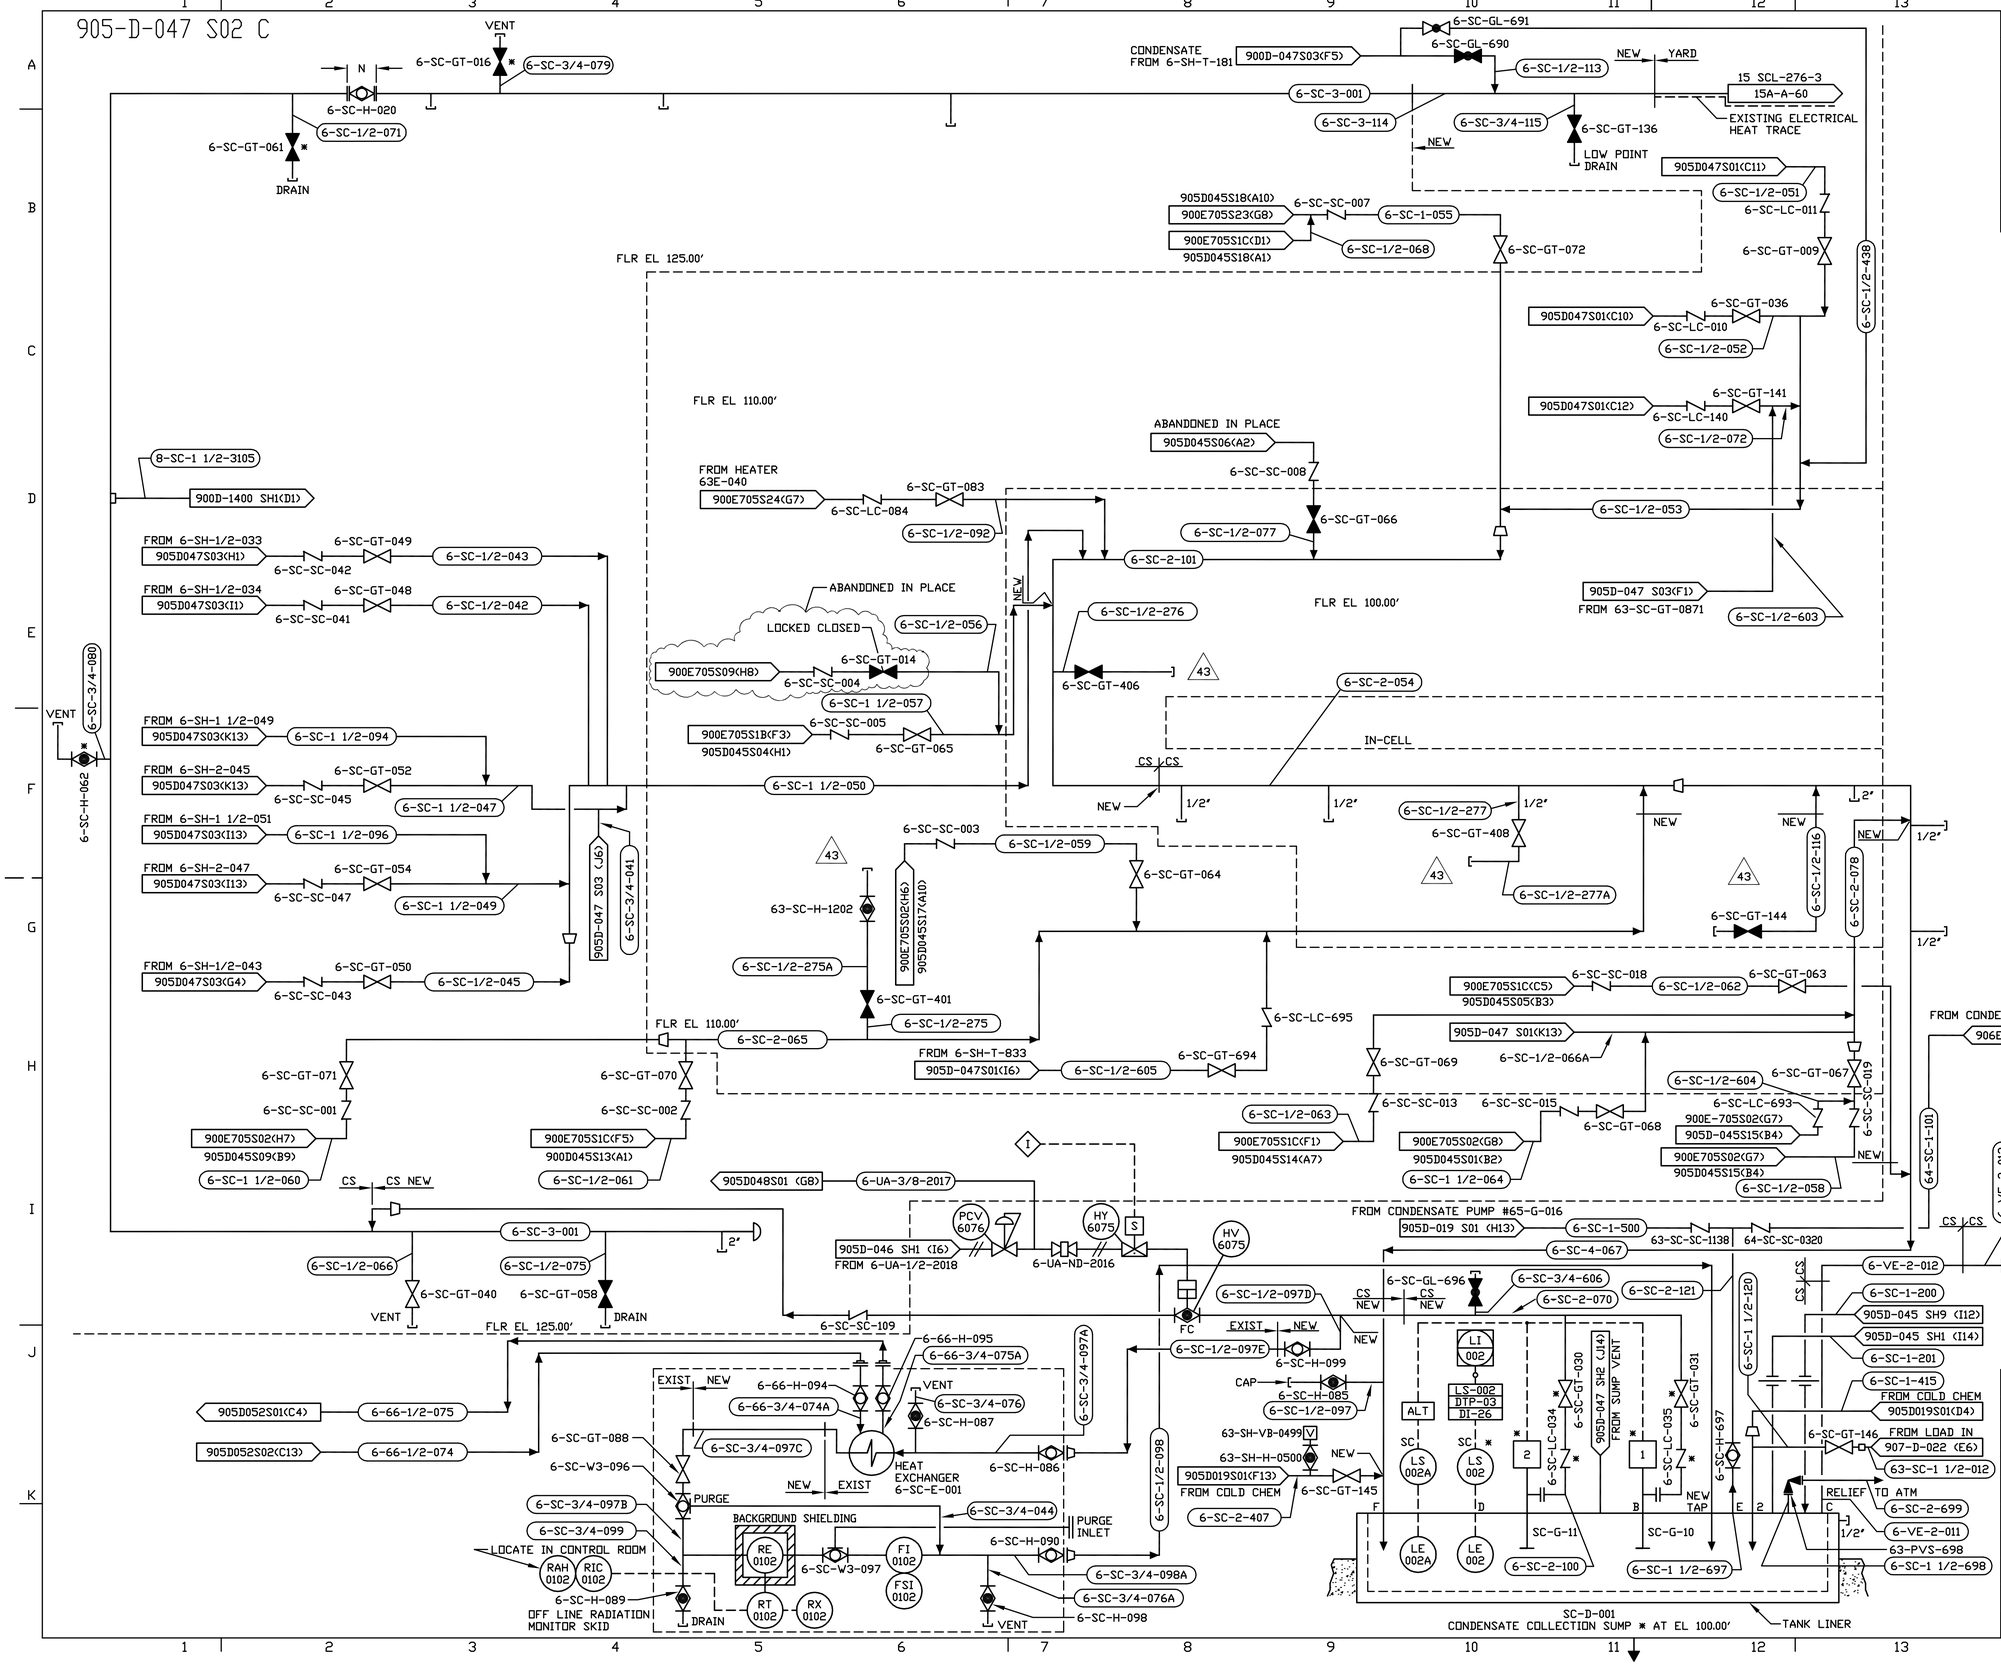

NO.	DATE	REVISION	DR	CH	APPROVED		
~~B~~	~~08-23-88~~		BFR	RJL	RJL FJE	FSK	MDW
		GENERAL REVISION					
~~C~~	~~06-28-89~~		PJS	EMR	RJL	EMR FJE	FJES
		GENERAL REVISION					
0	7/13/89	ER1646			JRH		
41	5/7/98	ECN 11416	CW	HAB			
41	12/04/98	REDRAWN/NO CHANGES	BP	DRS	CAC		
42	12/18/98	ECN 11385	CW	JLH			
43	10/11/99	ECN 12228	CAM	HAB			

REFERENCE DRAWINGS:

NOTES,SYMBOLS & LEGEND	900-D-1306
NOTES,SYMBOLS & LEGEND	900-D-1307
NOTES,SYMBOLS & LEGEND	900-D-1308

NOTES:

1. A SINGLE ASTERISK (*) INDICATES EXISTING VALVES AND EQUIPMENT TO BE RETAINED.
2. FOR COND. SUMP PUMP CWD, SEE DRAWING 905B-305 SH 136

VERIFY ALL DOCUMENTS FOR CURRENT REVISION AND PENDING CHANGES PRIOR TO EACH USE

INIT _____ DATE _____

FOR DRAWING INDEX SEE DRAWING NO.

APPRVD WVNS CO.		EBASCO SERVICES INCORPORATED A/E O.F.S. NO.2388 TASK ORDER 009
PROJECT MGR M.D.WEINGART	02-02-88	FOR WEST VALLEY NUCLEAR SERVICES COMPANY,INC WEST VALLEY,NEW YORK
ENGINEER SUPV F.S.KOWALCZYK	02-02-88	
LEAD DISC ENGR F.EMMER	02-02-88	WEST VALLEY DEMONSTRATION PROJECT
DESIGN R.J.LEWKO	02-02-88	P & ID VITRIFICATION FACILITY CONDENSATE SYSTEM
CHECKED R.J.LEWKO	02-02-88	
DRAWN T.J.KITZ	DATE 02-02-88	
DE-AC07-81NE44139 PROJECT NO.		SIZE D; INDEX CODE NUMBER: AREA, DR.TYP, CL, DRIG; DRAWING NO. 905D-047; REV. 43
19-CWV-02275 SUBCONTRACT NO.		
ISSUED FOR CONSTRUCTION		SCALE NONE; SPEC. CODES; A/E SHEET NO. 905-D-047 S02 C

E047D002 1=1.00

FILE NAME:905D47B REV.02 UIC(133,0641)
PLOT REQ NO. PJS0909 DATE:06-09-89