VERIFY ALL DOCUMENTS FOR CURRENT REVISION AND PENDING CHANGES PRIOR TO EACH USE.
INIT_____ DATE_____

905-D-152

REV NO	DATE	REVISION	DR	CH	APPROVED
~~B~~	~~5/27/87~~	~~GENERAL REVISION AS PER EBAR # 926~~	V.S.	MH	
C	5/16/88	GENERAL REVISION	DB	MH	
0	5-31-88	ER 1376		M	
6	4-6-95	ECN 8770	GW	KQ	
7	1-16-96	ECN TM-1854	GW	HB	
3	7-25-90	REV. PER ECN-194	BJK	FJK	
4	3-16-93	REV PER ECN 5764	GW	HB	
5	3-13-95	ECN NOX-T124	GW	HB	

NOTES:

1. FOR GENERAL NOTES SEE DWG 905-D-122.
2. ALL BOLTS SHALL BE A-325 7/8"ϕ WITH HEX NUT & STD. WASHER - UNLESS NOTED.
3. HANDRAILING AND POSTS SHALL BE 1½" NOMINAL STD PIPE WITH POSTS NOT MORE THAN 6 FT ON CENTERS. TURNS SHALL BE BENT AND NOT MITERED.
4. PROVIDE ABRASIVE NOSING AT HEADS OF STAIRS AND TREADS.
5. CURB PLATES SHALL BE SHOP ATTACHED TO SUPPORTING STEEL MEMBERS TOP OF CURB PLATE SHALL BE 4 INCHES ABOVE FLOOR - UNLESS OTHERWISE NOTED.
6. SET RUNWAYS RAILS TRUE, LEVEL & PARALLEL TO DIMENSIONS AND ELEVATION GIVEN WITHIN ±1/8 INCH. MAX. RATE OF CHANGE = 1/8" IN 20'. RAIL SEPERATION AT JOINTS SHALL NOT EXCEED 1/32".
7. CARBON STEEL SURFACES SHALL HAVE EPOXY PAINT IN ACCORDANCE WITH CS-134. OR CS-139 AS APPLICABLE.
8. CRANE BEAM SHIMS SHALL BE FULL BEARING ON SUPPORT.

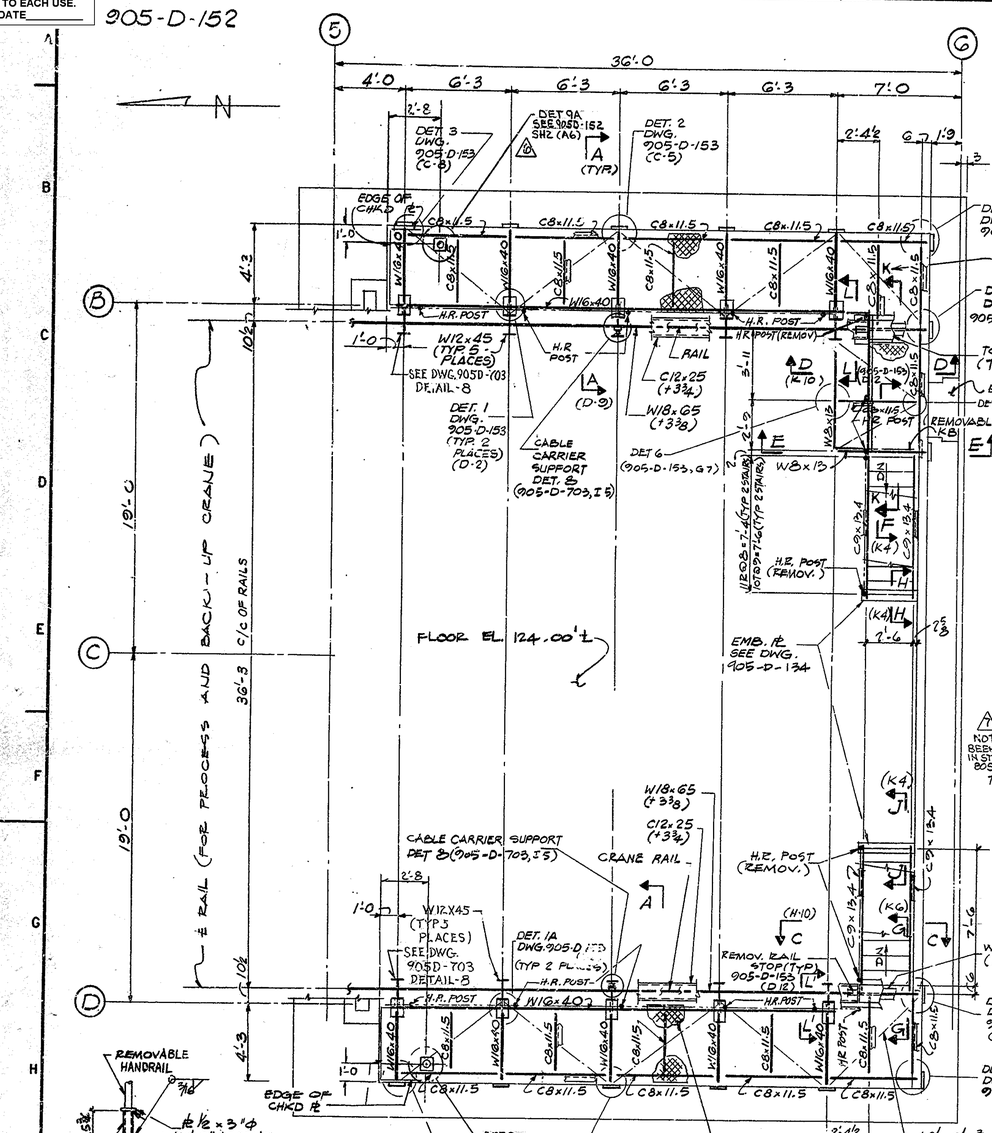

REFERENCE DRAWINGS:

V.F. SLAB AT EL 124'-0 AND WALLS M & R — 905-D-146 TO 148

V.F. WALL PENET'S FROM EL 124.00' TO EL 147.25' 905-D-160, 161, 705 FOR ADDITIONAL REFERENCE DWGS SEE DWGS 905-D-122 & 142

THIS DRAWING IS PART OF CS-139 AS NOTED AT ZONE (E13) AND RELATED DETAILS.

WORK THIS DWG WITH DWG 905-D-153

FOR DRAWING INDEX SEE DRAWING NO.

WVNS APPROVAL	
COG. MGR.	
COG. ENGR.	
DRFT. SUPR.	
Q.A. MGR.	
R&S MGR.	
PROJ. MGR.	

AF PRVD WVNS CO.		EBASCO SERVICES INCORPORATED A/E O.F.S. NO. 2388 TASK ORDER 009
PROJECT MGR	2/13/87	FOR WEST VALLEY NUCLEAR SERVICES COMPANY, INC WEST VALLEY, NEW YORK
ENGINEER	2/13/87	
LEAD DISC ENGR	2/13/87	WEST VALLEY DEMONSTRATION PROJECT
DESIGN K. VADASHURAMA	2-13-87	VITRIFICATION FACILITY
CHECKED M. HRABOWSKA	2/13/87	MISCELLANEOUS STEEL
DRAWN	DATE 2/13/87	CMR PLATF. & CRANE SUPT DETAILS SH. 1
DE-AC07-81NE44139 PROJECT NO.	SIZE D	INDEX CODE NUMBER: AREA / DR. TYP / CL / ORIG — DRAWING NO. 905D-152 — REV. 7
19-CWV-02275 SUBCONTRACT NO.		
ISSUED FOR CONSTRUCTION	SCALE: ¼"=1'-0 U.N.	SPEC. CODES — A/E SHEET NO. 1 OF 2 905-D-152 C