VERIFY ALL DOCUMENTS FOR CURRENT REVISION AND PENDING CHANGES PRIOR TO EACH USE.
INIT_____ DATE_____

905-D-714

REV NO	DATE	REVISION	DR	CH	APPROVED
B	6-30-89	REVISED AS CIRCLED AND PER EBAR # 1216			
0	7/17/89	ER 1646			
8	5-27-93	REV/ECN 6346	RMS	MEM	
9	2-14-94	REV PER ECN 7338	GW	DRS	
10	11-18-94	REV/ECN VF-28-2905	PD	CLS	MEM
11	5-5-95	REV/ECN NOX-T149 & NOX-T170	PD	CS	MEM
5	1-20-92	REV PER ECN 4787	GW		
6	1-9-92	GEN REV/ECN 4649	RMS		GWM
7	92	GEN REV/ECN 6207	PD	WB	GWM

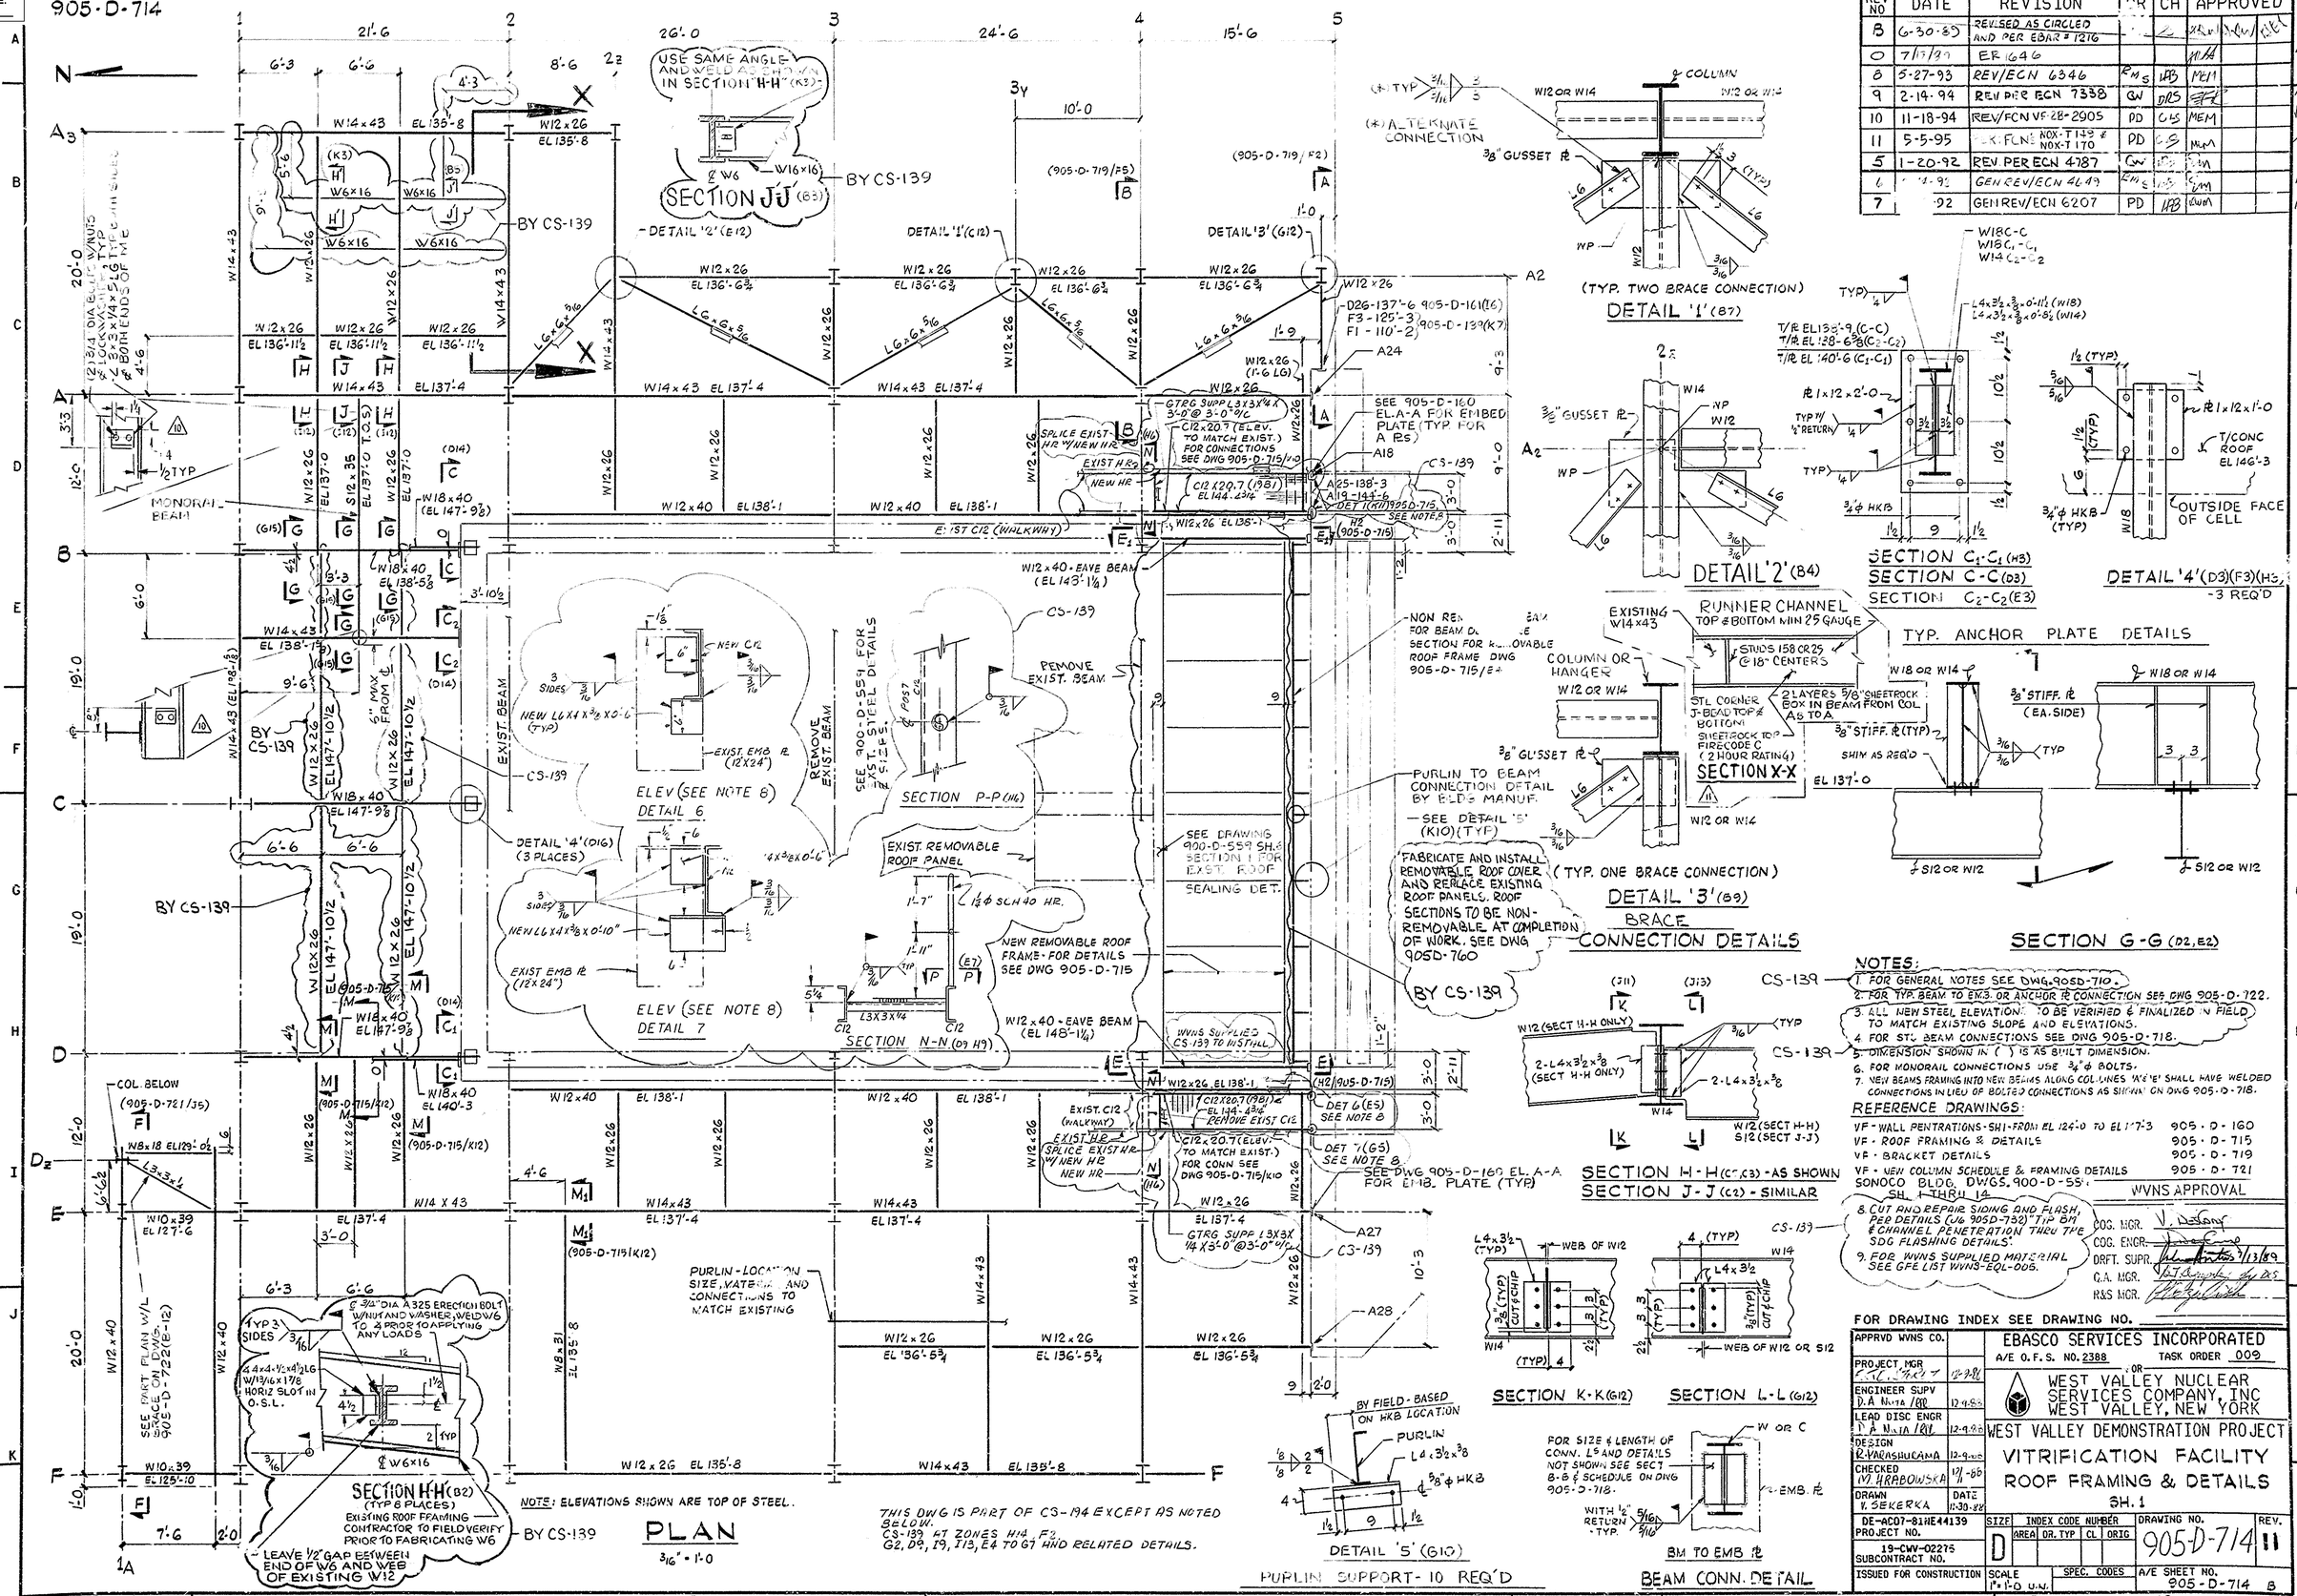

NOTES:
1. FOR GENERAL NOTES SEE DWG. 905D-710.
2. FOR TYP. BEAM TO EMB. OR ANCHOR PL CONNECTION SEE DWG 905-D-722.
3. ALL NEW STEEL ELEVATIONS TO BE VERIFIED & FINALIZED IN FIELD TO MATCH EXISTING SLOPE AND ELEVATIONS.
4. FOR STL BEAM CONNECTIONS SEE DWG 905-D-718.
5. DIMENSION SHOWN IN ( ) IS AS BUILT DIMENSION.
6. FOR MONORAIL CONNECTIONS USE 3/4" ϕ BOLTS.
7. NEW BEAMS FRAMING INTO NEW BEAMS ALONG COL LINES 'A' & 'E' SHALL HAVE WELDED CONNECTIONS IN LIEU OF BOLTED CONNECTIONS AS SHOWN ON DWG 905-D-718.
8. CUT AND REPAIR SIDING AND FLASH, PER DETAILS (W/O 905D-732) TYP BM & CHANNEL PENETRATION THRU THE SDG FLASHING DETAILS.
9. FOR WVNS SUPPLIED MATERIAL SEE GFE LIST WVNS-EQL-005.

REFERENCE DRAWINGS:

VF - WALL PENTRATIONS - SH1 - FROM EL 124'-0 TO EL 147'-3	905-D-160
VF - ROOF FRAMING & DETAILS	905-D-715
VF - BRACKET DETAILS	905-D-719
VF - NEW COLUMN SCHEDULE & FRAMING DETAILS	905-D-721
SONOCO BLDG. DWGS. 900-D-55 SH. 1 THRU 14	

WVNS APPROVAL
COG. MGR. V. DeLaney
COG. ENGR.
DRFT. SUPR. 1/13/89
Q.A. MGR.
R&S MGR.

FOR DRAWING INDEX SEE DRAWING NO.

APPRVD WVNS CO.	
PROJECT MGR	
ENGINEER SUPV D. A. Nuta	12-9-88
LEAD DISC ENGR D. A. Nuta	12-9-88
DESIGN R. Varashucama	12-9-88
CHECKED M. Hrabowska	12/9/88
DRAWN V. Sekerka	DATE 11-30-88

EBASCO SERVICES INCORPORATED
A/E O.F.S. NO. 2388 TASK ORDER 009
WEST VALLEY NUCLEAR SERVICES COMPANY, INC
WEST VALLEY, NEW YORK
WEST VALLEY DEMONSTRATION PROJECT
VITRIFICATION FACILITY
ROOF FRAMING & DETAILS
SH. 1

DE-AC07-81NE44139 PROJECT NO.	SIZE D	INDEX CODE NUMBER: AREA, DR. TYP, CL, ORIG	DRAWING NO. 905-D-714	REV. 11
19-CWV-02275 SUBCONTRACT NO.				
ISSUED FOR CONSTRUCTION	SCALE 1" = 1'-0 U.N.	SPEC. CODES	A/E SHEET NO. 905-D-714 B	