VERIFY ALL DOCUMENTS FOR CURRENT REVISION AND PENDING CHANGES PRIOR TO EACH USE.
INIT_____ DATE_____

905D-715

REV NO	DATE	REVISION	DR	CH	APPROVED
8	7-27-92	REV PER ECN 5301	HB	DRS	
B	6-30-85	REVISED AS CIRCLED AND PER EBAR #1216	V.S.		
0	7/13/87	E.R. 16046			
9	1-20-93	REV/ECN VF-2B-0628	PD		
10	4-15-93	REV/ECN 5872	RMS	KQ	MCM
11	2-15-94	REV PER ECN 7338	GN	DRS	
12	7-25-94	REV PER ECN VF-2B-2393	PD	ACA	MCM
5	5-14-91	PER ECN VF-2A-2[illegible] FCN VF-2A-279	TLH	HAB	
6	1-30-92	REV/ECN 4711	RMS	HAB	
7	2-18-92	REV/ECN 4649	RMS		

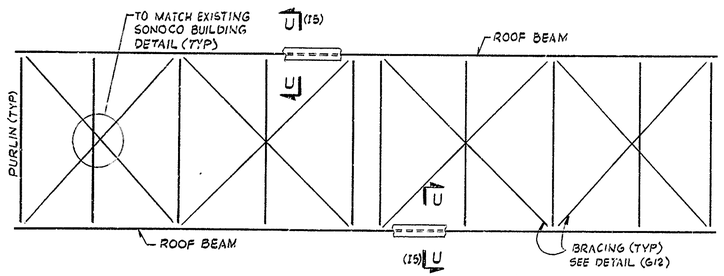

PLAN

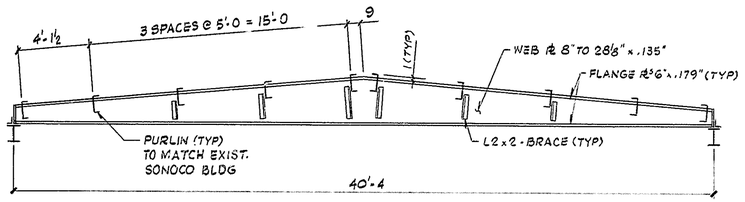

SECTION

REMOVABLE ROOF FRAME

¼" = 1'-0

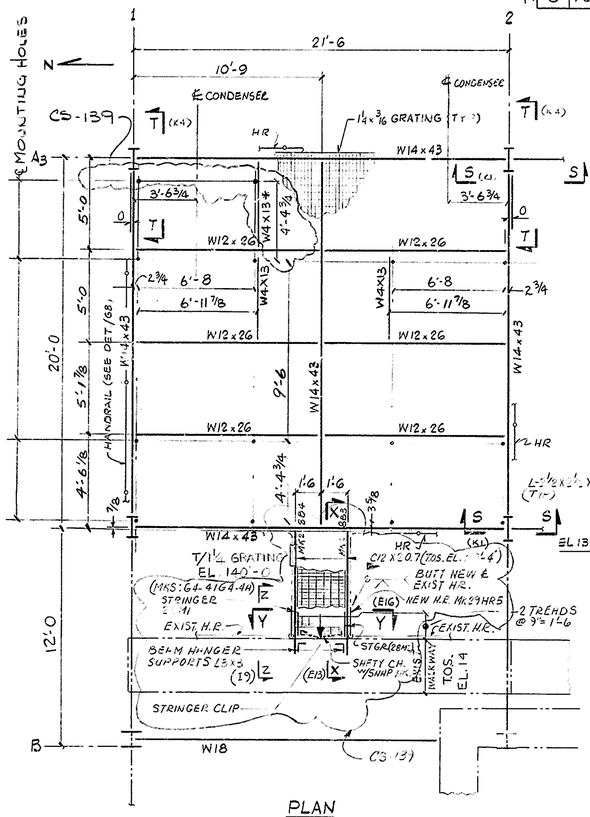

PLAN

PLATFORM AT EL 140'-0 (TOS - 1¼" U.N.)

¼" = 1'-0

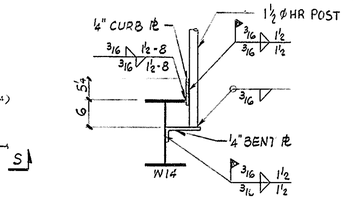

HR POST AT BEAM

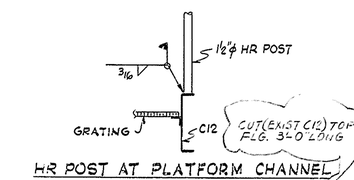

HR POST AT PLATFORM CHANNEL

HANDRAIL POST DETAILS

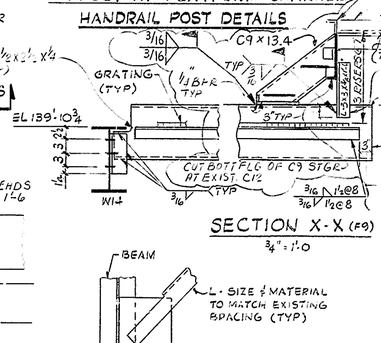

SECTION X-X (F9)

¾" = 1'-0

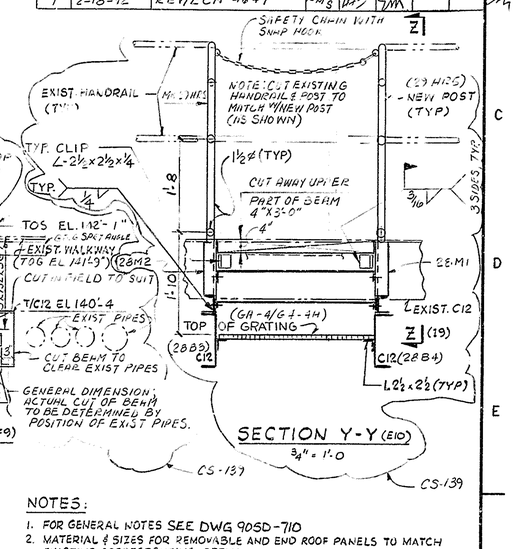

SECTION Y-Y (E10)

¾" = 1'-0

NOTES:

1. FOR GENERAL NOTES SEE DWG 905D-710
2. MATERIAL & SIZES FOR REMOVABLE AND END ROOF PANELS TO MATCH EXISTING CORRESPONDING ITEMS.
3. DIMENSION SHOWN IN ( ) IS AS BUILT DIMENSION.

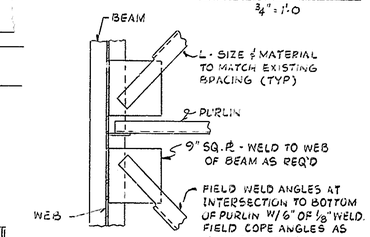

BRACE CONNECTION DETAIL

(AT ROOF PANEL)

* COAT WITH AMERLOCK 400 DEEP GREY

REFERENCE DRAWINGS:

VF - ROOF FRAMING & DETAILS 905-D-714

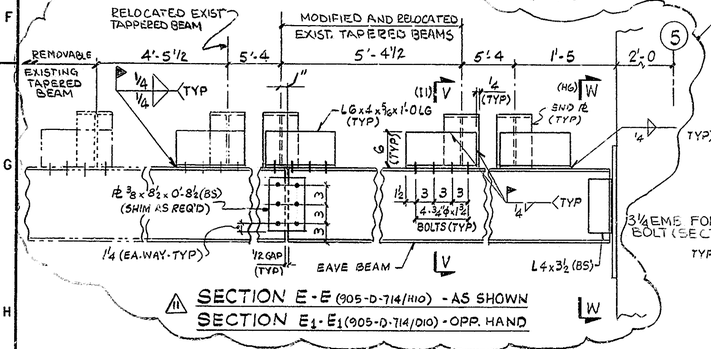

SECTION E-E (905-D-714/H10) - AS SHOWN

SECTION E1-E1 (905-D-714/D10) - OPP. HAND

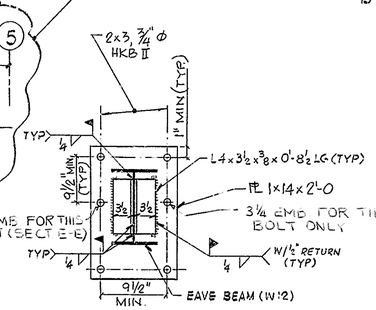

SECTION W-W (F4)

NOTE: STD EMBEDMENT IS REQ'D FOR HKB II BOLTS, U.O.N.

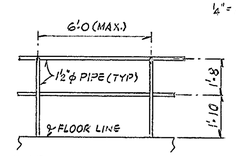

TYP. HANDRAIL DETAIL

N.T.S.

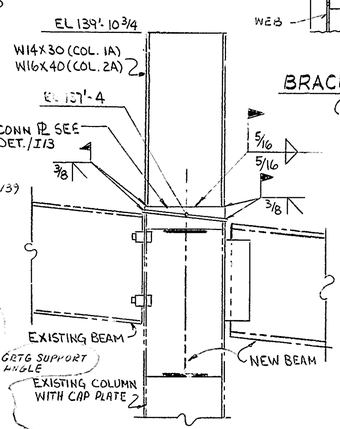

COL. 1A & 2A

COLUMN EXTENSION DETAIL

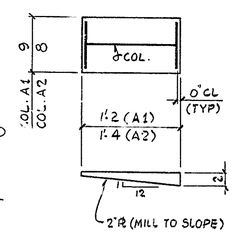

CONNECTION PL DETAIL

THIS DRAWING IS PART OF CS-1 CS-139 ZONES J9, K6 AND R6 H, L, L. NOTED BELOW. LS.

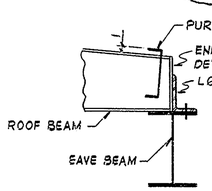

SECTION V-V (F3)

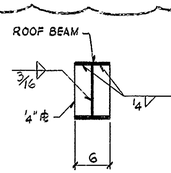

END PLATE DETAIL (H2)

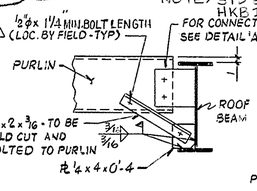

SECTION U-U (A3, C4)

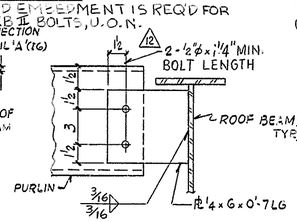

DETAIL 'A' (H5)

NTS

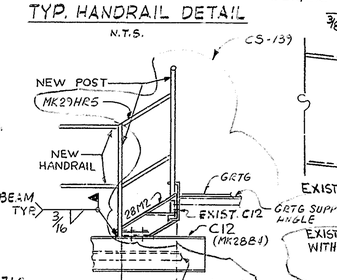

SECTION Z-Z (D16, E9)

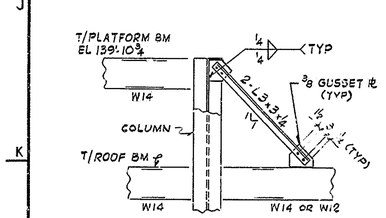

SECTION S-S (B10, D10)

N.T.S.

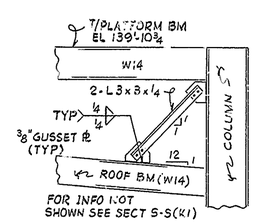

SECTION T-T (A8, A11)

N.T.S.

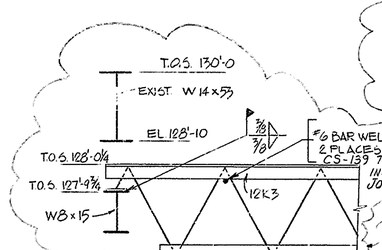

SECTION DD-DD

N.T.S. 905-D-713 (J2)

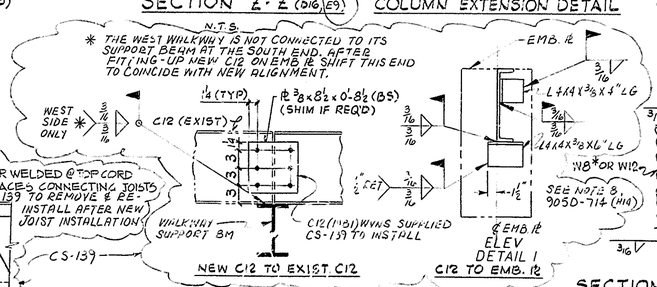

WALKWAY BEAM CONNECTION

(DWG 905-D-714/D9, I9)

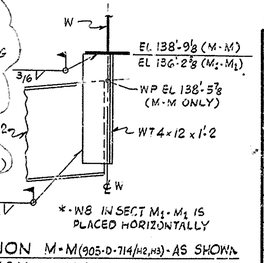

SECTION M-M (905-D-714/H2, H3) - AS SHOWN

SECTION M1-M1 (905-D-714/J4) - SIMILAR

N.T.S.

WVNS APPROVAL

COG. MGR. [signature]
COG. ENGR. [signature]
DRFT. SUPR. [signature] 7/13/89
Q.A. MGR. [signature]
R&S MGR. [signature]

FOR DRAWING INDEX SEE DRAWING NO.

APPRVD WVNS CO.		EBASCO SERVICES INCORPORATED A/E O.F.S. NO. 2388 TASK ORDER 009 FOR WEST VALLEY NUCLEAR SERVICES COMPANY, INC WEST VALLEY, NEW YORK
PROJECT MGR	12-7-88	
ENGINEER SUPV	12-9-88	
LEAD DISC ENGR	12-9-88	
DESIGN	12-9-88	WEST VALLEY DEMONSTRATION PROJECT VITRIFICATION FACILITY ROOF FRAMING & DETAILS SH. 2
CHECKED	12-11-88	
DRAWN V SEKERKA	DATE 11-30-88	
DE-AC07-81NE44139 PROJECT NO.		SIZE D; INDEX CODE NUMBER: AREA, DR. TYP, CL, ORIG; DRAWING NO. 905-D-715; REV. 12
19-CWV-02275 SUBCONTRACT NO.		
ISSUED FOR CONSTRUCTION		SCALE 1"=1'-0 U.N.; SPEC; CODES; A/E SHEET NO. 905-D-715 B