VERIFY ALL DOCUMENTS FOR CURRENT REVISION AND PENDING CHANGES PRIOR TO EACH USE.
INIT_____ DATE_____

-723

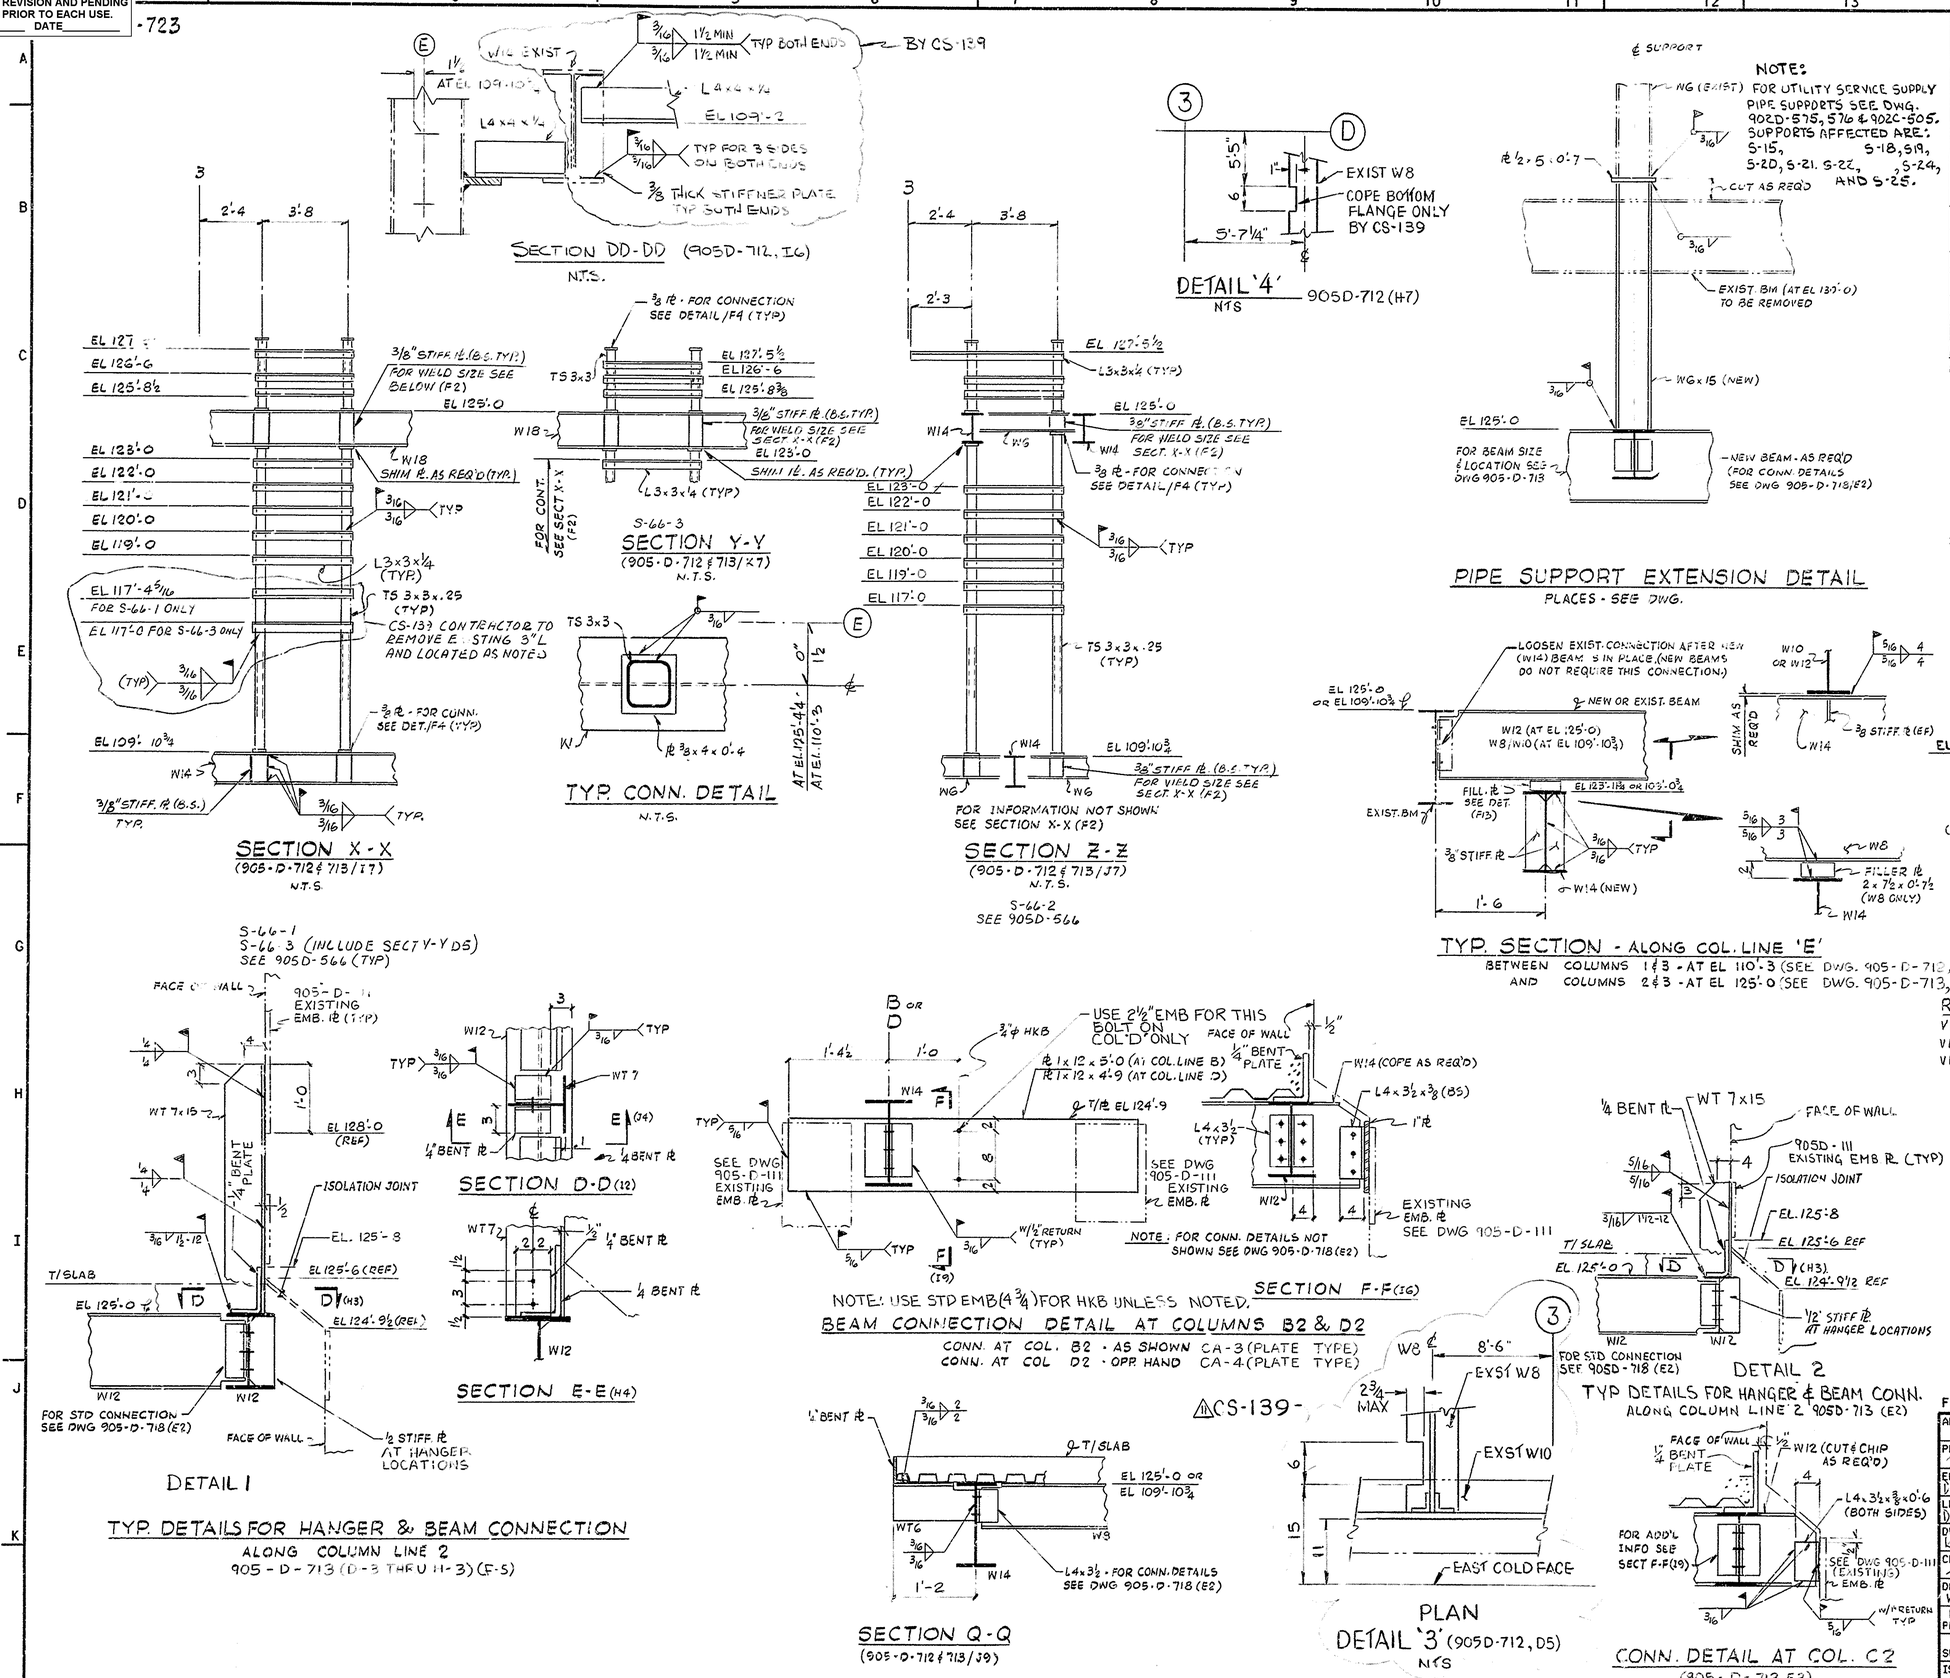

REV NO	DATE	REVISION	DR	CH	APPROVED
~~8~~	~~6-30-89~~	REVISED AS CIRCLED AND PER EBAR # 1227	V.S.		
0	7/13/89	ER 1646			
10	2-10-93	REV/FCN VF-2B-0596	PD	HB	HAJ
11	2-17-93	REV/FCN VF-2B-0592	PD	HB	HAJ
3	5-25-90	REV. PER ECN 3544A	GW	DRS	
4	5-22-91	REV. PER FCN VF-2A-141 VF-2A-239 FCN VF-2A-237	GW	DRS	Em
5	7-1-91	REV. PER FCN VF-2A-306	GW	HAB	Em
6	8-7-91	REV. PER ECN 4248	GW	DRS	Em
7	9-5-91	REV PER FCN VF-2A-364	JLH	DRS	Em
8	11-4-91	REV/ECN 4498	RMS	HAB	DJR
9	12-14-92	REV PER VF-2B-0452 & VF-2B-0442	HB	DRS	HAJ

NOTES:
1. FOR NOTES SEE DWG 905D-710

REFERENCE DRAWINGS:

VF- PLATFORM FRAMING AT EL 110'-3 - PLAN	905-D-712
VF- PLATFORM FRAMING AT EL 125'-4 1/4 - PLAN	905-D-713
VF- TYPICAL FRAMING CONNECTION DETAILS	905-D-718
	905-D-111

WVNS APPROVAL
COG. MGR. V. DeSamp
COG. ENGR. [signature]
DRFT. SUPR. [signature] 7/13/89
Q.A. MGR. [signature]
R&S MGR. [signature]

FOR DRAWING INDEX SEE DRAWING NO.

APPRVD WVNS CO.	
PROJECT MGR	
ENGINEER SUPV D. A. NUTA /RR	12-22-88
LEAD DISC ENGR D. A. NUTA /RR	12-22-88
DESIGN K. PARASHURAMA	12-19-88
CHECKED S. C[illegible]	12-19-88
DRAWN V. SEKERKA	DATE 12-13-88

EBASCO SERVICES INCORPORATED
A/E O.F.S. NO. 2388 TASK ORDER 009
FOR
WEST VALLEY NUCLEAR SERVICES COMPANY, INC
WEST VALLEY, NEW YORK

WEST VALLEY DEMONSTRATION PROJECT
VITRIFICATION FACILITY
MISCELLANEOUS DETAILS
SH. 2

DE-AC07-81NE44139
PROJECT NO.
19-CWV-02275
SUBCONTRACT NO.
ISSUED FOR CONSTRUCTION

SIZE D | INDEX CODE NUMBER: AREA, DR. TYP, CL, ORIG | DRAWING NO. 905-D-723 | REV. 11
SCALE NONE | SPEC. CODES | A/E SHEET NO. 905-D-723 B