VERIFY ALL DOCUMENTS FOR CURRENT REVISION AND PENDING CHANGES PRIOR TO EACH USE.
INIT_____ DATE_____

905-D-736

10	REV PER ECN VF-28-0181	PI	HB	7-6-92	DJK	
11	REV PER ECN-5494 / 5732	CRD	DKS	12-2-93	MM	

REVISIONS						
ZONE	REV	DESCRIPTION	BY	CHKD	DATE	APPROVED
	18	ECN 11023	GW	HB		
	8	REV. PER ECN 4690	GW	HAB	12-5-91	
	9	GEN REV ECN 4795	CGR	HAB	1-27-92	

REV NO	DATE	REVISION	DR	CH	APPROVED
~~-3~~	~~6-29-63~~	~~REV PER ECN 1045~~			
0	7/17/89	ER 1646			
.2	4-16-93	REV PER ECN 5871	GW	HB	MGM
13	5-11-94	REV. FCN VF-28-1907		HB	MM
14	11-23-94	REV/FCN VF-28-2123			MEM
15	7-3-95	VF-28-3003			MGM
16	9-21-95	FCN TM-1119	PD	KQ	EFK
17	5-16-95	FCN TM-2301	DAK	HB	EFK

NEW EAVE EXTENSION COUNTERFLASHING SHALL BE FABRICATED FROM 20GA. GALV. STL. COUNTERFLASHING SHALL EXTEND ALONG WEST SIDE OF ROOF FOR APPROX. 70 LINEAL FEET. COLOR TO BE PARCHMENT.

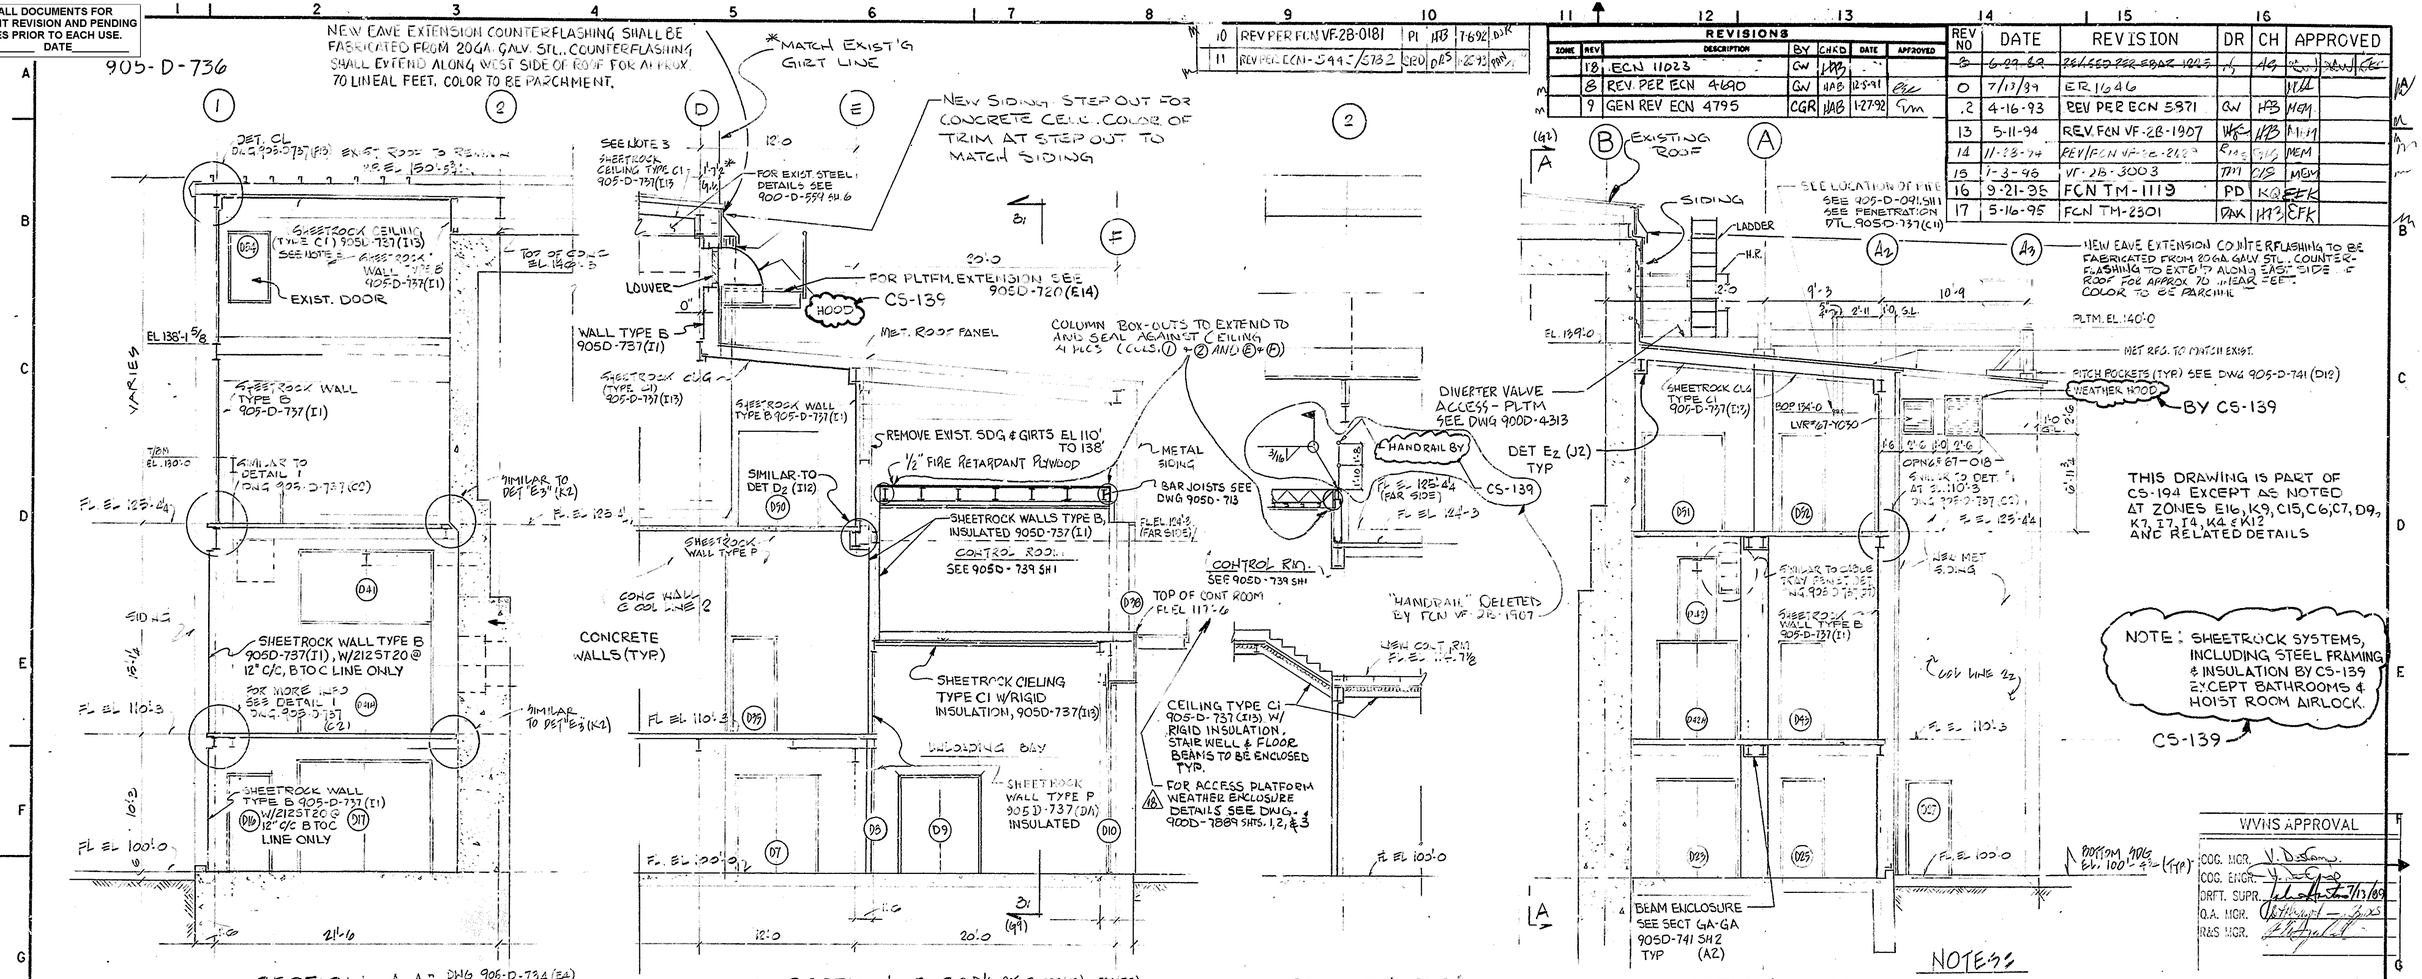

SECTION "A-A" DWG 905-D-734 (E4), DWG 905-D-733 (E1), DWG 905-D-731 (K4) 3/16" = 1'-0

SECTION "B-B" DWG 905-D-733 (N3) & 731 (E3) 3/16" = 1'-0

SECTION "D-D" DWG 905-D-732 (H3) 3/16" = 1'-0

SECTION "C-C" DWG 905-D-733 (E4), DWG 905-D-732 (E3), DWG 905-D-734 (C5) 3/16" = 1'-0

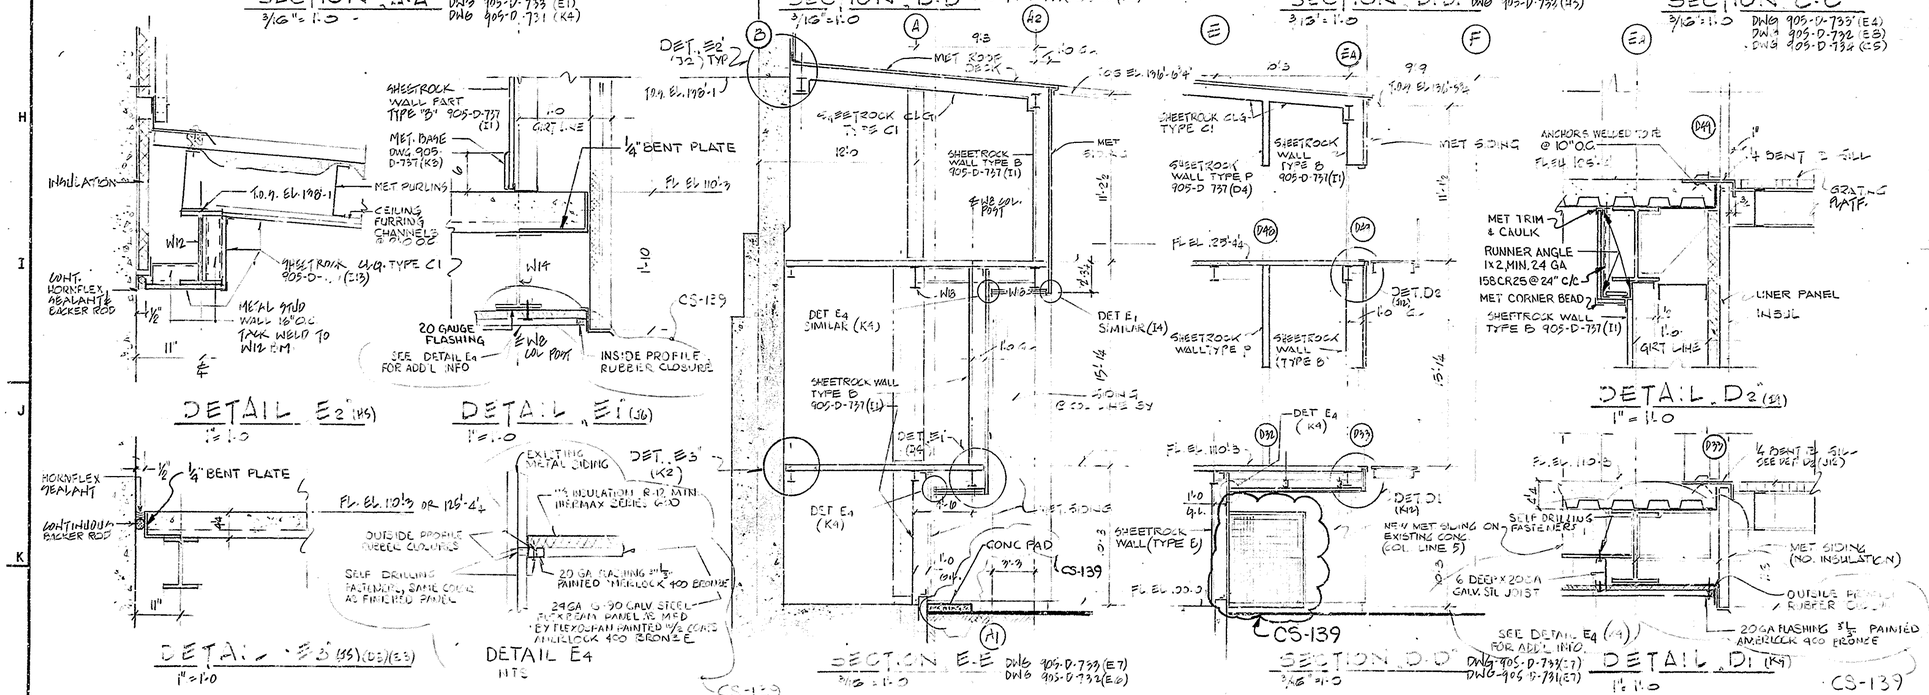

NOTES:

1. FOR ADDITIONAL NOTES, SEE DWG. 905D-710
2. ALL NEW METAL ROOF DECK & SIDING TO MATCH EXIST
3. FURRING CHANNELS TO BE SPACED AT 12" O/C FOR THE CEILING IN THE AREA BETWEEN B & D LINES, AND 1 TO 2 LINES

REFERENCE DRAWINGS:

ARCH. ELEVATIONS SH#1	905-D-731
ARCH ELEVATIONS SH#2	905-D-732
ARCH GRD FLOOR PLAN EL. 100'-0	905-D-733
ARCH FLOOR PLAN EL. 110'-3	905-D-734
ARCH FLOOR PLAN EL. 125'-3	905-D-735
PLATF FRAMING AT ELEV 110'-3	905-D-712
PLATF FRAMING AT ELEV 125'-3	905-D-713
ROOF FRAMING & DETAILS SH#1	905-D-714
NEW COLUMN SCHEDULE & FRAMING DETAILS	905-D-721
ARCH MISC. SECTIONS & DETS. SH.#1	905-D-737
V.F. DOOR SCHEDULE	905-D-738

FOR DRAWING INDEX SEE DRAWING NO. _____

WVNS APPROVAL	
COG. MGR.	
COG. ENGR.	
DRFT. SUPR.	7/13/89
Q.A. MGR.	
R&S MGR.	

APPRVD WVNS CO.		EBASCO SERVICES INCORPORATED A/E O.F.S. NO. 2388 TASK ORDER _____ FOR WEST VALLEY NUCLEAR SERVICES COMPANY, INC WEST VALLEY, NEW YORK
PROJECT MGR		
ENGINEER SUPV		
LEAD DISC ENGR		WEST VALLEY DEMONSTRATION PROJECT VITRIFICATION FACILITY ARCHITECTURAL SECTIONS & DETAILS SH#1
DESIGN		
CHECKED		
DRAWN	DATE	
DE-AC07-81NE44139 PROJECT NO.	SIZE D	INDEX CODE NUMBER: AREA / OR. TYP / CL / ORIG — DRAWING NO. 905D-736 — REV. 18
19-CWV-02275 SUBCONTRACT NO.		
ISSUED FOR CONSTRUCTION	SCALE AS NOTED	SPEC. CODES — A/E SHEET NO. 905-D-736 B