VERIFY ALL DOCUMENTS FOR CURRENT REVISION AND PENDING CHANGES PRIOR TO EACH USE.
INIT_____ DATE_____

905-D-737

REV NO	DATE	REVISION	DR	CH	APPROVED	
~~13~~	~~6-29-89~~	~~REVISED PER ECN 1225~~				
0	7/13/89	ER 10646				
9	9-12-97	ECN 10945	GW	DRS		
2	1-22-90	REV. PER ECN 3420	CGR		VAD	
3	2-15-90	REV. PER ECN 3461	CGR	TCC	VAD	
4	4-11-90	REV. PER ECN 3523	GW	DRS	VAD	
5	7-9-90	REV. PER ECN 3687	GW	DRS		
6	1-27-92	REV PER ECN 4795	CGR	HAB		
7	7-6-92	REV PER FCN VF2B-0181	PD	HB	DJR	
8	7-21-94	REV/ FCN'S 2132 & 2309	GW	ALA	MEM	

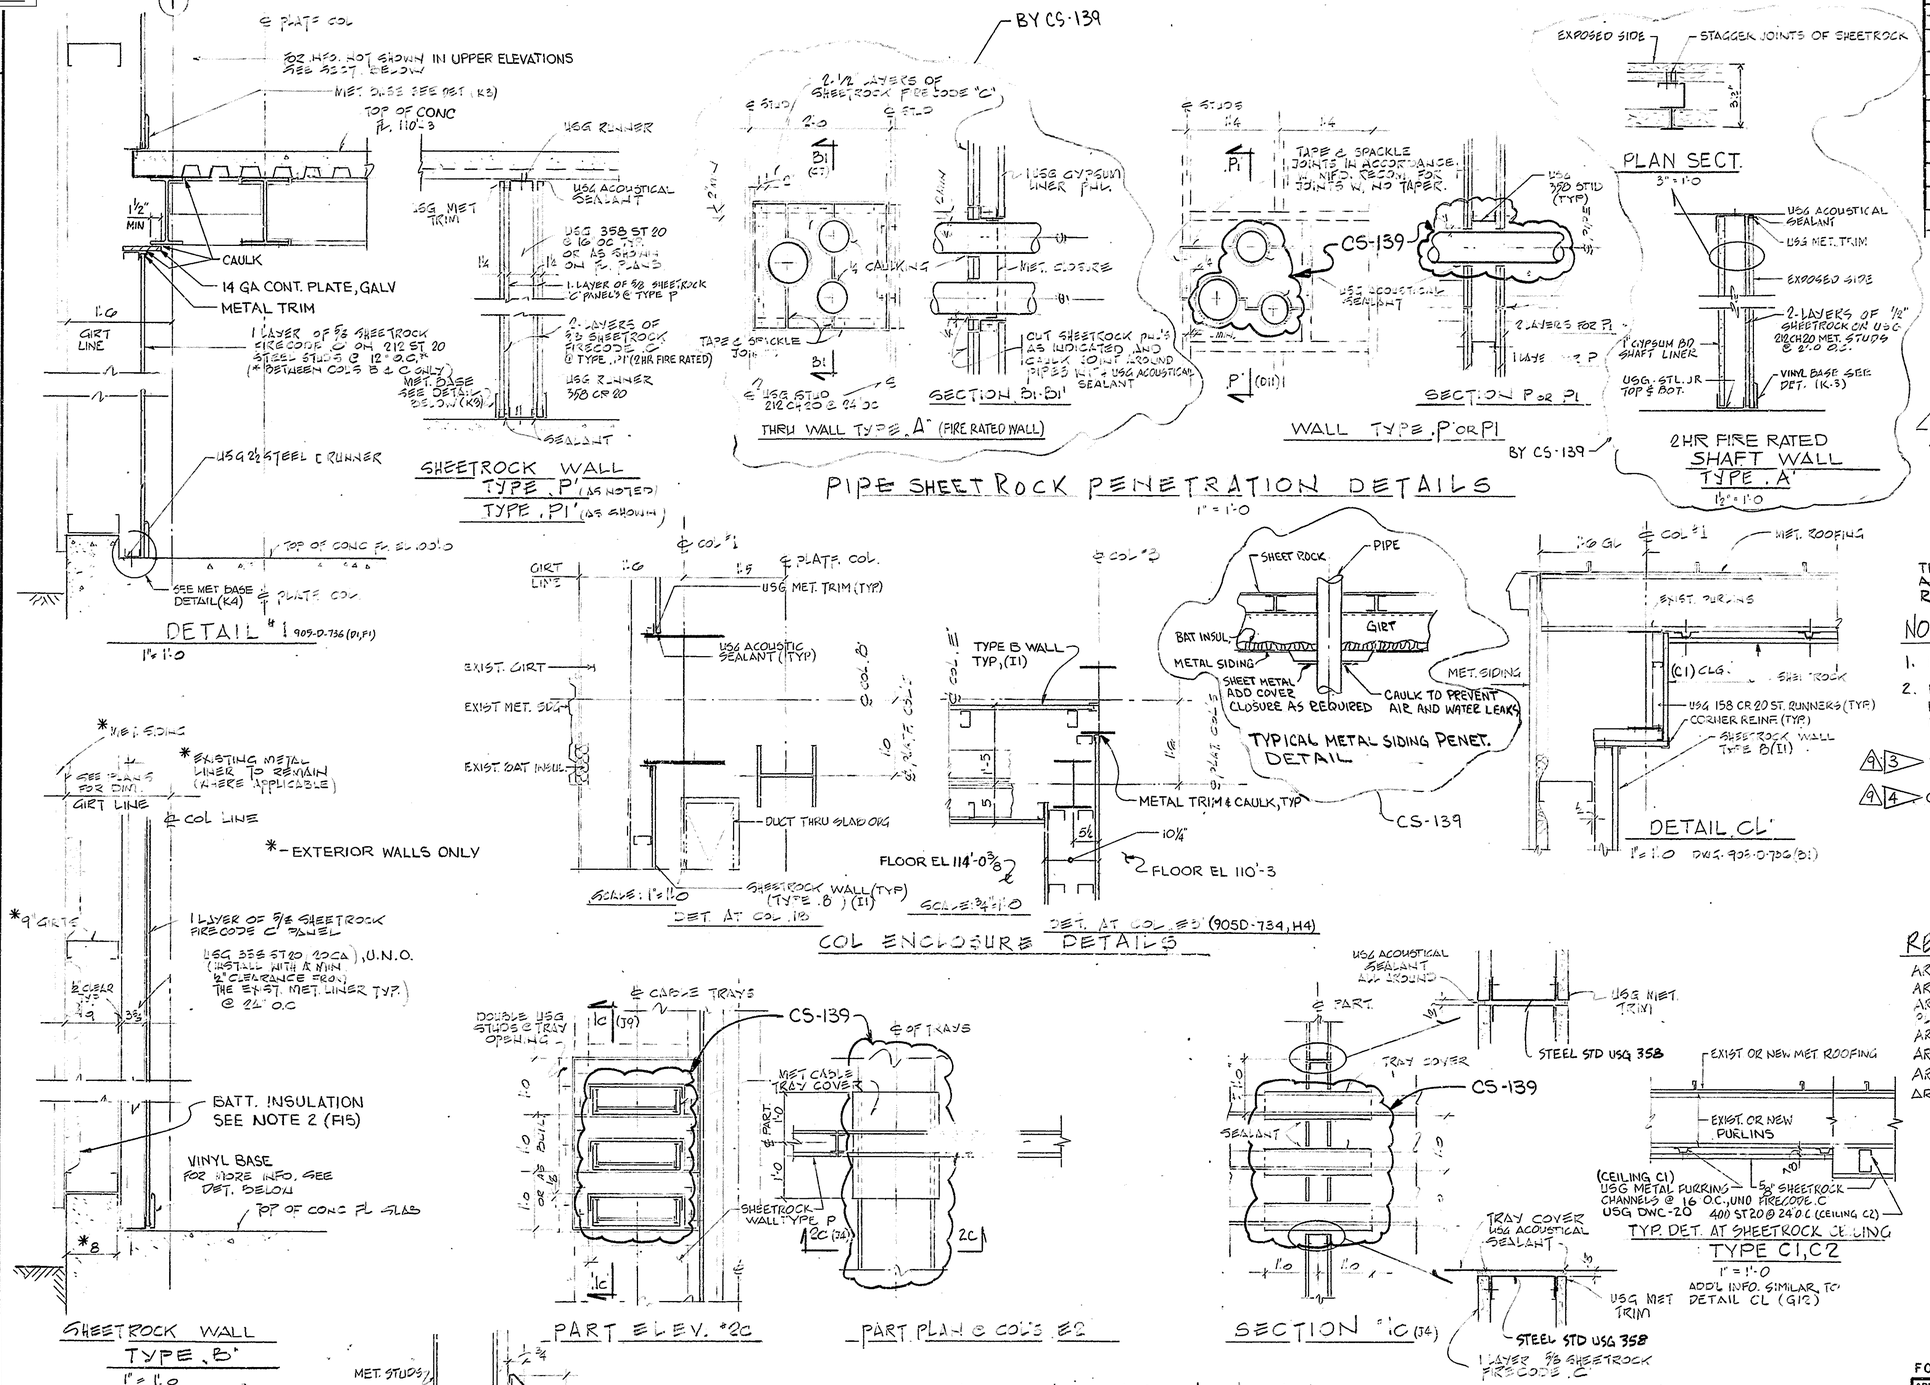

THIS DRAWING IS PART OF CS-194 EXCEPT AS NOTED AT ZONES K-10, I4, I6, I9, C10, F10, F14 AND RELATED DETAILS

NOTES:

1. FOR ADDITIONAL NOTES, SEE DWG. 905D-710
2. PRIOR TO INSTALLATION OF SHEETROCK ALONG EXTERIOR WALLS, EXISTING BATT INSULATION SHALL BE REPAIRED, MISSING INSUL. SHALL BE REPLACED, TEARS IN VAPOR BARRIER SHALL BE TAPED, BY CS-139.

9/3 WELDS TO BE FREE OF CRACKS AND POROSITY.

9/4 CAP EACH END WITH 3" FINISHING PLUGS.

REFERENCE DRAWINGS:

ARCHITECTURAL ELEVATIONS SH#1	905-D-731
ARCHITECTURAL ELEVATIONS SH#2	905-D-732
ARCHITECTURAL GROUND FLOOR PLAN EL 100'-0	905-D-733
ARCHITECTURAL FLOOR PLAN EL 110'-3	905-D-734
ARCHITECTURAL FLOOR PLAN EL 125'-3	905-D-735
ARCHITECTURAL SECTIONS & DETAILS SH#1	905-D-736
ARCHITECTURAL MISC. SECT'S & DET'S.	905D-739

FOR DRAWING INDEX SEE DRAWING NO. _____

APPRVD WVNS CO.		EBASCO SERVICES INCORPORATED
PROJECT MGR		A/E O.F.S. NO. 2388 TASK ORDER _____
ENGINEER SUPV		WEST VALLEY NUCLEAR SERVICES COMPANY, INC WEST VALLEY, NEW YORK
LEAD DISC ENGR		WEST VALLEY DEMONSTRATION PROJECT
DESIGN A. GROSS		VITRIFICATION FACILITY ARCHITECTURAL MISC. SECTIONS & DETS SH#1
CHECKED SANTOSPIRITO		
DRAWN A. GROSS	DATE	
DE-AC07-81NE44139 PROJECT NO.		SIZE D; INDEX CODE NUMBER (AREA, DR. TYP, CL, ORIG); DRAWING NO. 905D-737; REV. 9
19-CWV-02275 SUBCONTRACT NO.		
ISSUED FOR CONSTRUCTION		SCALE AS NOTED; SPEC. CODES; A/E SHEET NO. 905-D-737 B

WVNS APPROVAL
COG. MGR. V. DESIDERIO
COG. ENGR.
DRFT. SUPR. 7/13/89
Q.A. MGR.
R&S MGR.

NOTE: SHEETROCK SYSTEMS INCL. STEEL FRAMING BY CS-139 EXCEPT FOR BATHROOMS AND HOIST ROOM AIRLOCK. — CS-139