NO	DATE	REVISION	BY	CH	APPROVED	
B	02-18-94	GENERAL REVISION	LH	RJL	RJL	MMK FJES / FJES
C	06-02-94	GENERAL REVISION	LH	RJL	RJL	AC FJE / MMK
D	07-25-94	GENERAL REVISION AS PER DESIGN REVIEW COMMENTS	RJL	RJL	RJL	FJE / MMK
0	12/30/94	ER 3194			JRH	
1	1/10/95	REVISED PER ECN 8576	AAJ	KQ	RMB	
2	3/27/96	REVISED PER ECN 9719	DAK	HAB		
3	5/29/96	REVISED PER ECN 9715	SAB	DRS		
4	10/18/96	ECN 10251	RAS	HAB		
5	08/31/98	ECN 11599	BP	HAB		
6	11/4/98	ECN 11691	DAK	HAB		
7	4/27/01	ECN 13028	CAM	JLH		
8	08/04/2003	ECN 25674		HAB		

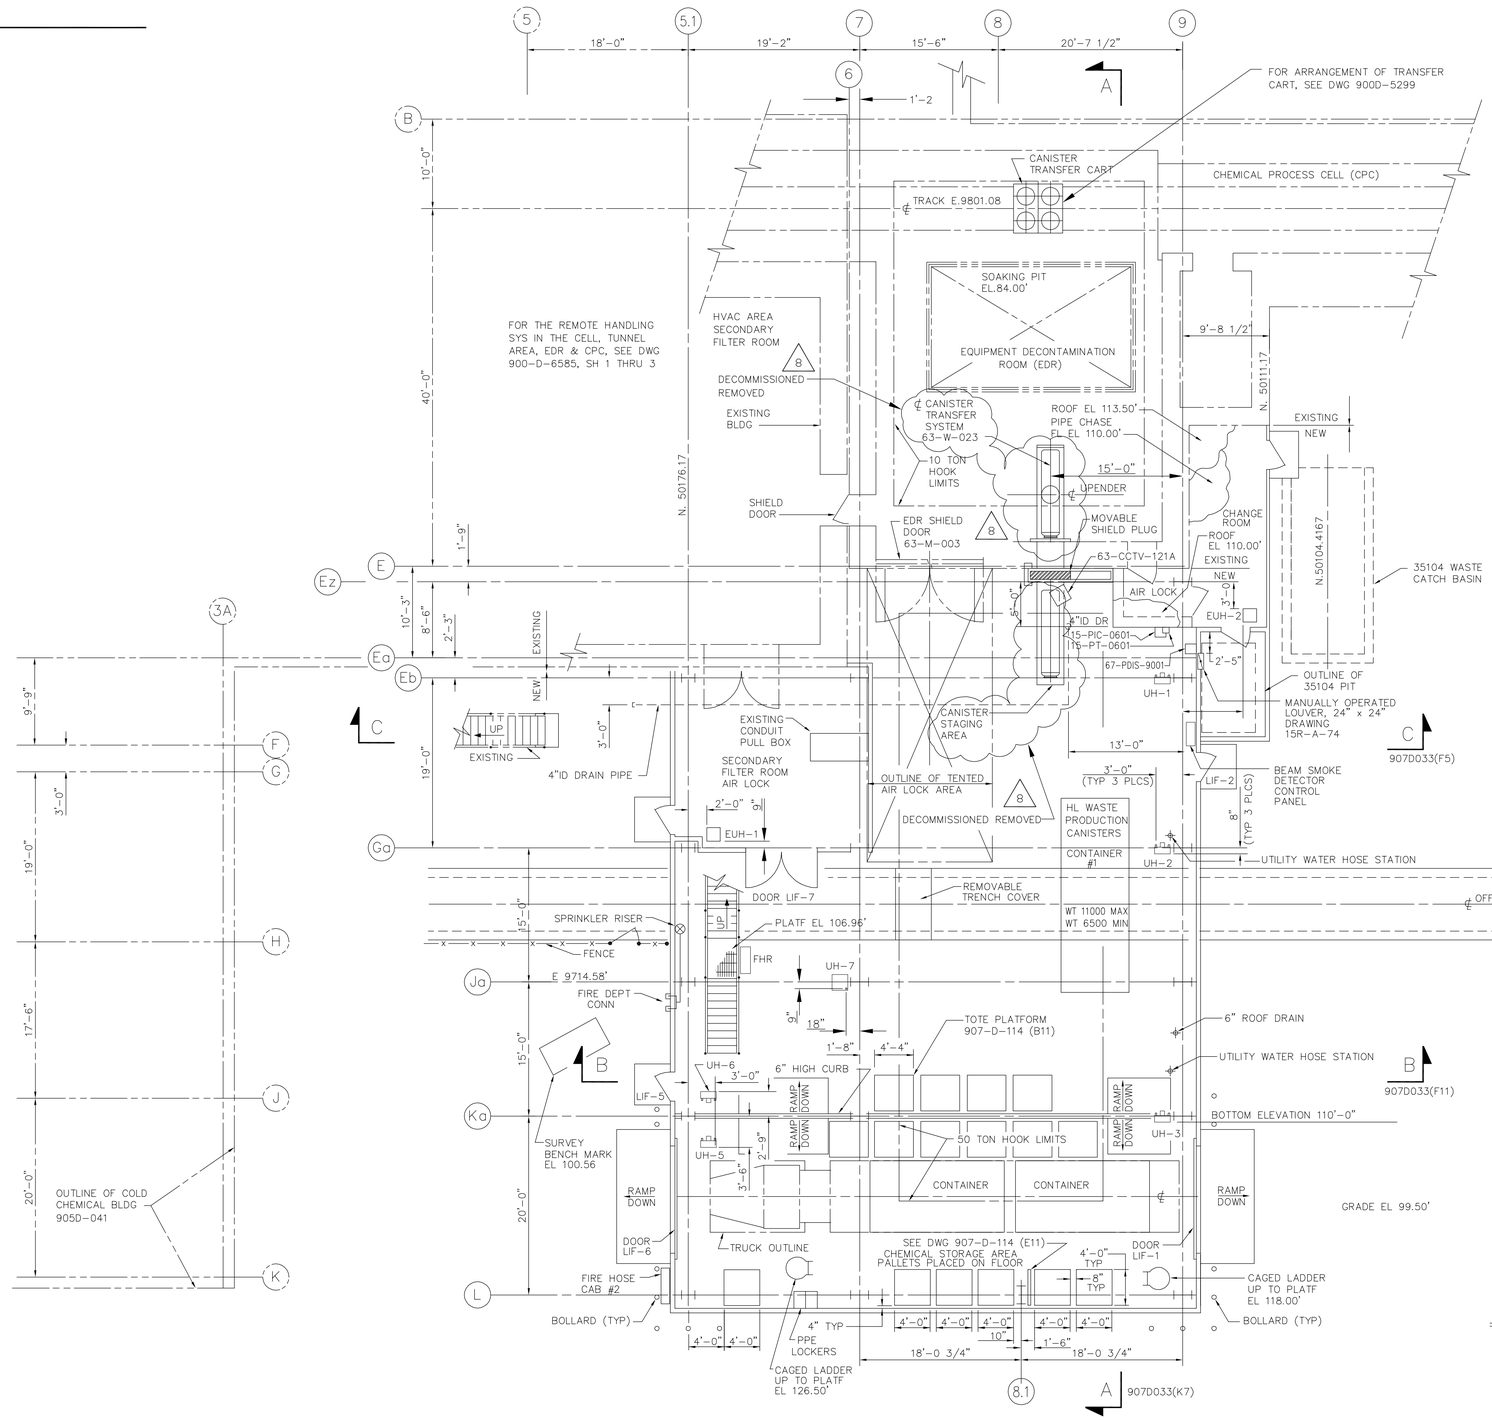

PLAN AT EL. 100.00'

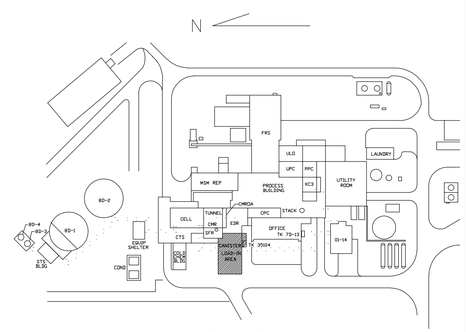

KEY PLAN

1 0 8 16 24 32FT 1/8"=1'-0"

FOR DRAWING INDEX SEE DRAWING NO. _____

WVNS APPROVAL

COG. MGR.	T E COTTRELL
COG. ENGR.	L E DONOVAN
DRFT. SUPR.	JOHN HORTON 12/30/94
Q.A. APPVL.	D L DEMPSTER
SYS ENGR APPVL.	L E DONOVAN

APPRVD WVNS CO	
PROJECT MGR FJE STOREY	10/20/93
ENGINEER SUPV P. HARRISON	10/20/93
LEAD DISC ENG P. HARRISON	10/20/93
DESIGN R.J. LEWKO	10/20/93
CHECKED P. HARRISON	10/20/93
DRAWN R.J. LEWKO	DATE 10/20/93

Raytheon Engineers & Constructors – EBASCO Division

A/E O.F.S. NO. 4889 FOR TASK ORDER 032

WEST VALLEY NUCLEAR SERVICES COMPANY, INC
WEST VALLEY, NEW YORK

WEST VALLEY DEMONSTRATION PROJECT

VITRIFICATION FACILITY G/A
LOAD-IN BUILDING
PLAN AT EL 100.00'

DE-AC07-81NE44139 PROJECT NO.
19-CWV-02275 SUBCONTRACT NO.
ISSUED FOR CONSTRUCTION

SIZE	INDEX CODE NUMBER: AREA	DR. TYP	CL	ORIG	DRAWING NO.	REV.
D					907-D-030	8

SCALE	SPEC. CODES	A/E SHEET NO.
1/8"=1'-0"		907-D-030 D

DWG FILE: 907D3003

OPER: DICK LEWKO DATE: 07-25-94 PRELIM REV: P1

130534 1=99.00