


SECTION "B-B"

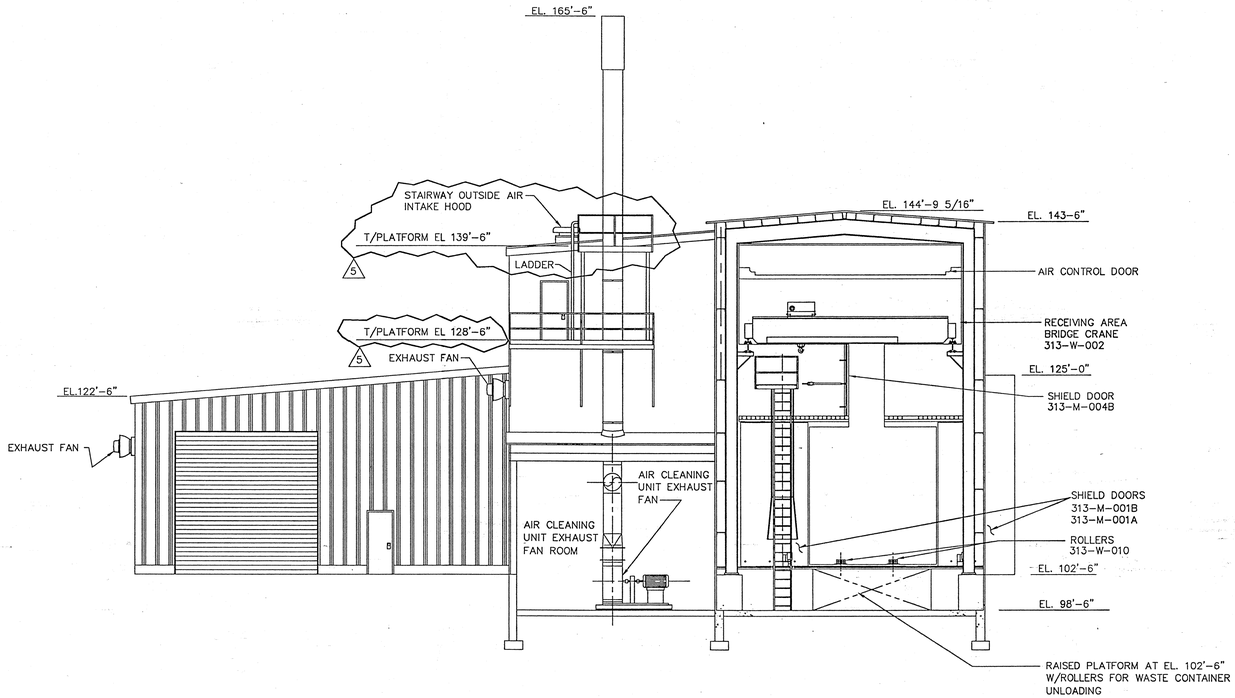


SECTION "C-C"

1 0 8 16 24 32FT

2339

REVISIONS
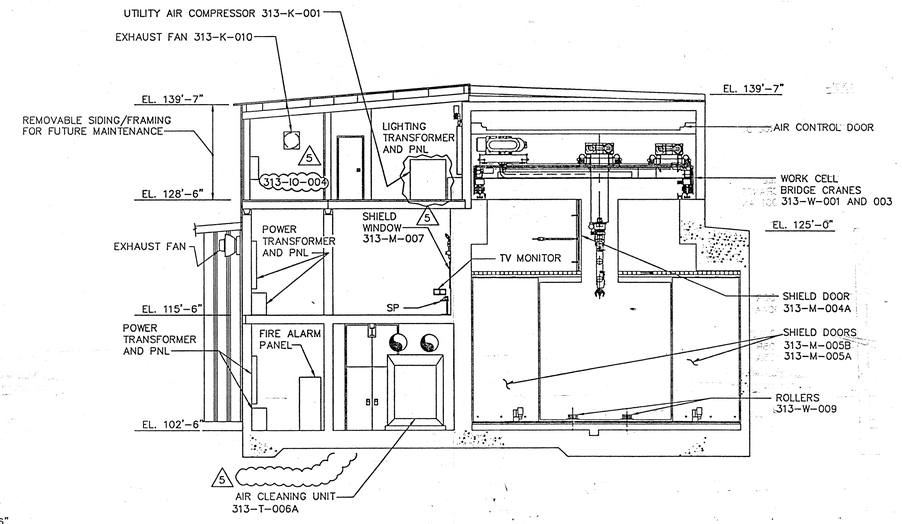
| REV | DESCRIPTION | APVD |
|---|---|---|
| 1 | INCORPORATE THE FOLLOWING DCNS: 066, 070, 073 & 076. | MG/AR 5/24/01 AWJ WC 5/24/01 EO 5/24/01 |
| 2 | FOR ACTION ITEM CHIT RESOLUTION. ADDED FAN AS CIRCLED. | WN 08/22/01 WC 08/22/01 EO 08/22/01 |
| 3 | GENERAL REVISION AS CIRCLED. | LC WC EO 01/16/03 |
| 4 | INCORPORATED AR# 021E COMMENTS | EST WC EO 03/11/03 |
| 5 | INCORPORATED: FCN-157, FCN-191. | WC EO 2/23/04 |
| 0 | ER25966 04234 | |

AS BUILT

VERIFY ALL DOCUMENTS FOR CURRENT REVISION AND PENDING CHANGES PRIOR TO EACH USE
INIT _____ DATE _____

UNLESS OTHERWISE SPECIFIED ALL DIMENSIONS IN INCHES

DRAFTER ARR DATE 06/30/00
CHECKER MJG DATE 06/30/00
ENGINEER DUJB DATE 06/30/00

VENDOR: BUTLER CONSTRUCTION CO. OF WNY, INC. RAYTHEON NUCLEAR, INC.
FOR Westinghouse Government Services Group
WEST VALLEY NUCLEAR SERVICES CO. WEST VALLEY N.Y.

REMOTE HANDLED WASTE FACILITY
GENERAL ARRANGEMENTS
SECTIONS B-B AND C-C

FILE NAME 911_D_030_SH5
PLOT SCALE 1=1
D SPEC # 0000
NEXT ASSEMBLY

DATABASE LINKED DRAWING.
SEE ENGINEERING RELEASE FORM (ER) FOR DRAWING APPROVAL SIGNATURES.

DWG SIZE D
SCALE 1/8"=1'-0"
WEIGHT
A/E DWG #
A/E CONTRACT #
DWG # 911-D-030
REV 05
SHEET 5 OF 7
CODE IDENT #

CAD DRAWING-DO NOT REVISE THIS ORIGINAL