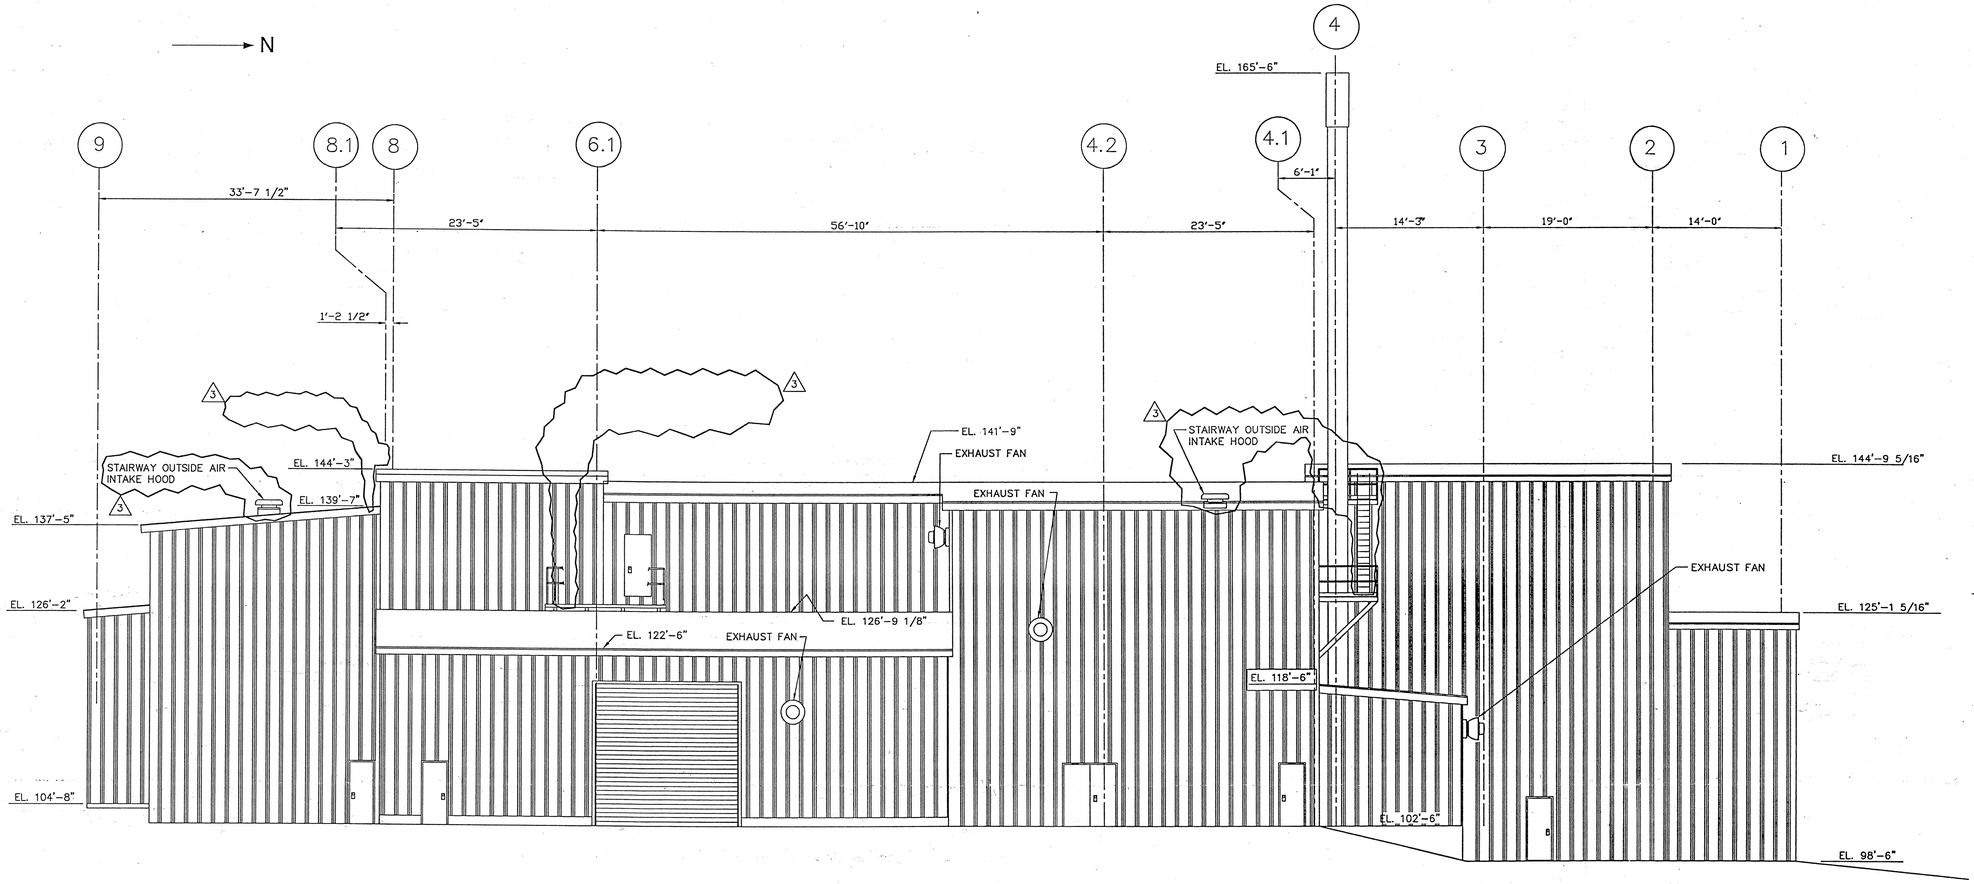

SECTION "F-F"

1 0 8 16 24 32FT

2337

REVISIONS			
REV	DESCRIPTION	APVD	
1	INCORPORATE THE FOLLOWING DCN: 066 & 073.	MG/AR 5/24/01	
		AWJ WC 5/24/01	EO 5/24/01
2	FOR ACTION ITEM CHIT RESOLUTION. ADDED AXIS & NORTH ARROW AS CIRCLED.	WN WC EO 8/22/01	
3	INCORPORATED: FCN-191, FCN-157.	LW SJC RBO 2/21/04	
0		EE23986 04/23/01	DJS

AS BUILT

VERIFY ALL DOCUMENTS FOR CURRENT REVISION AND PENDING CHANGES PRIOR TO EACH USE
INIT _____ DATE _____

UNLESS OTHERWISE SPECIFIED ALL DIMENSIONS IN INCHES

FILE NAME 911_D_030_SH6
PLOT SCALE 1=1
D SPEC # 0000
NEXT ASSEMBLY

DRAFTER ARR DATE 06/30/00
CHECKER MJG DATE 06/30/00
ENGINEER DUJB DATE 06/30/00

DATABASE LINKED DRAWING.
SEE ENGINEERING RELEASE FORM (ER) FOR DRAWING APPROVAL SIGNATURES.

DWG SIZE D

VENDOR: BUTLER CONSTRUCTION CO. OF WNY, INC. RAYTHEON NUCLEAR, INC.
FOR
Westinghouse Government Services Group
WEST VALLEY NUCLEAR SERVICES CO. WEST VALLEY N.Y.

REMOTE HANDLED WASTE FACILITY GENERAL ARRANGEMENT SECTION F-F

SCALE 1/8"=1'-0"
WEIGHT
DWG # 911-D-030
REV 03
A/E DWG #
SHEET 6 OF 7
A/E CONTRACT #
CODE IDENT #

CAD DRAWING-DO NOT REVISE THIS ORIGINAL