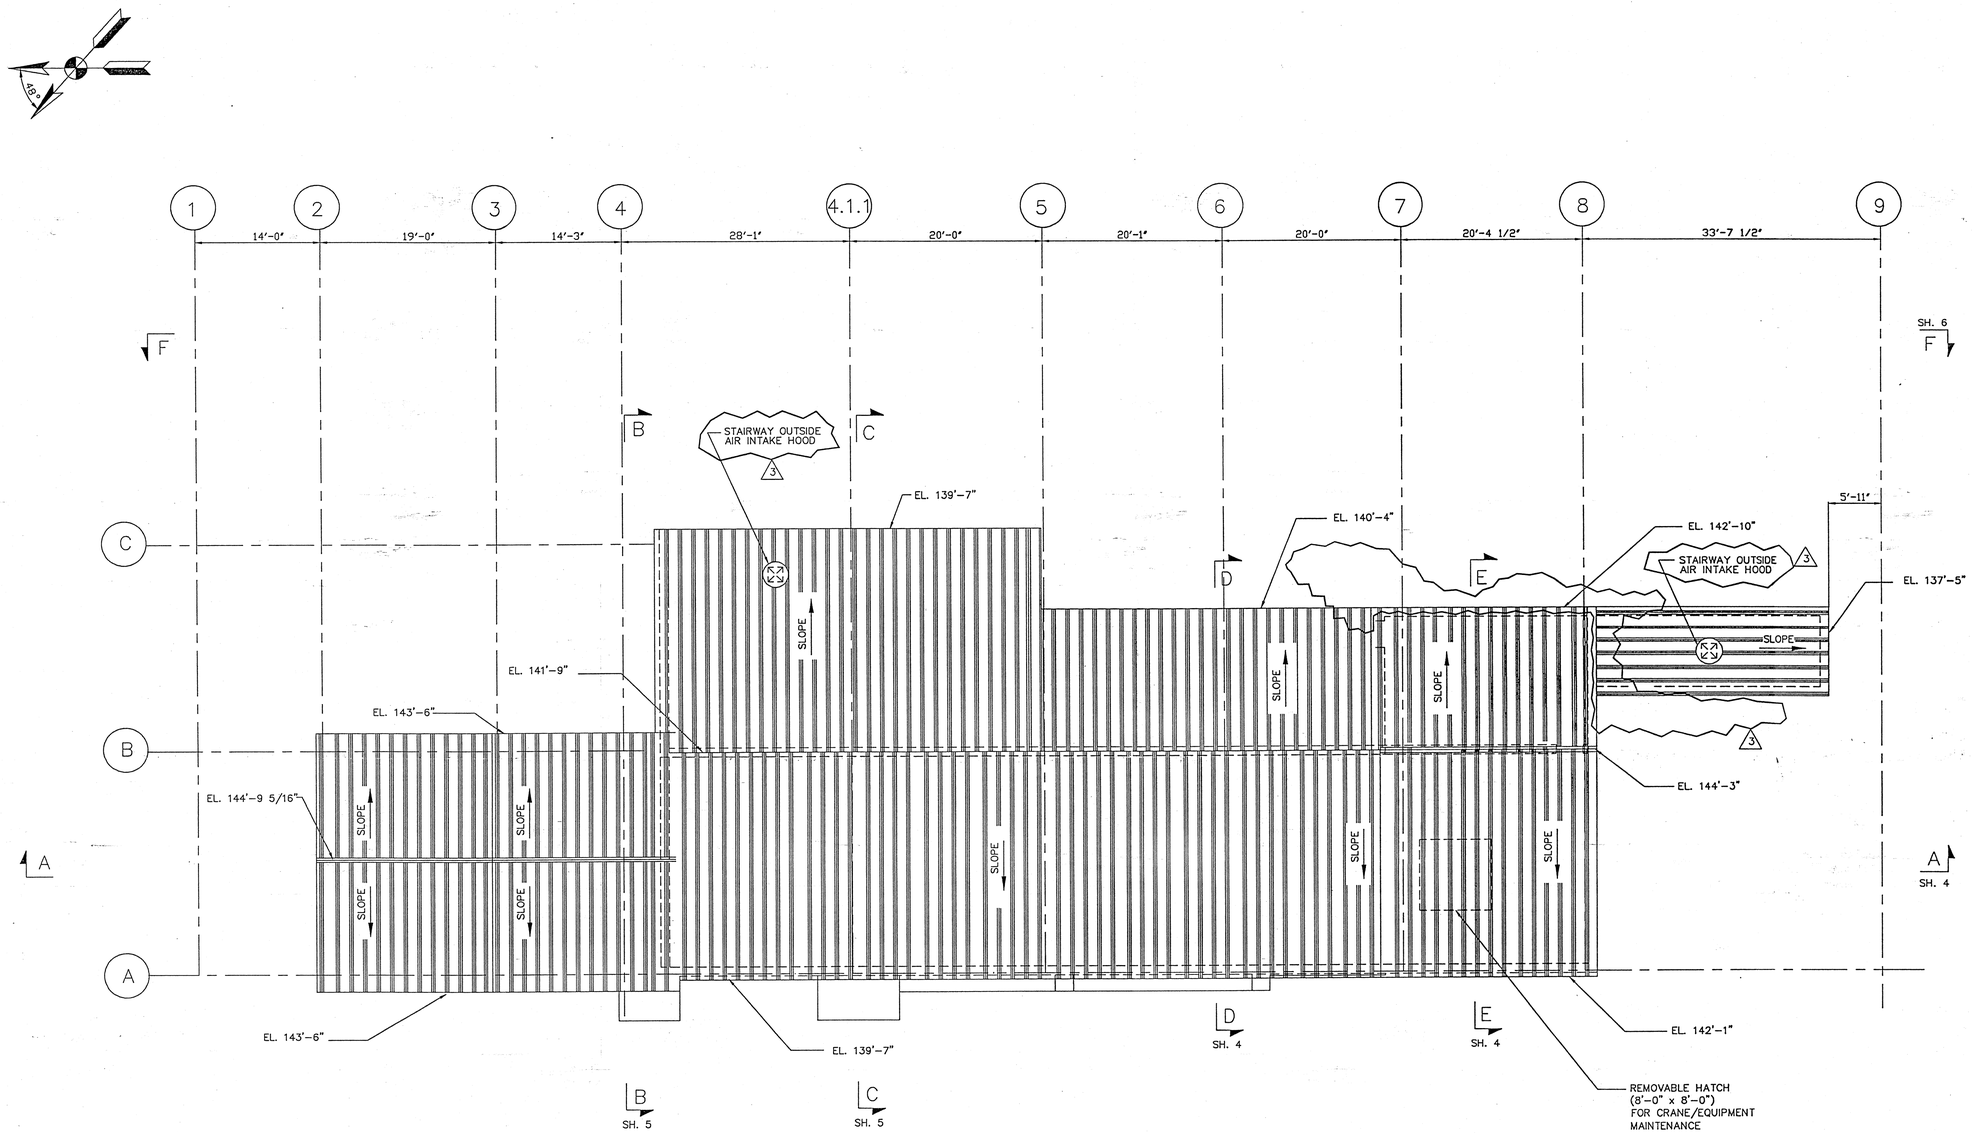

UPPER ROOF PLAN

1 0 8 16 24 32FT

2339

REV	DESCRIPTION	APVD
1	INCORPORATE THE FOLLOWING DCN: 070 & 073.	NG/AR 05/24/01; AWJ WC 05/24/01; EO 05/24/01
2	FOR ACTION ITEM CHIT RESOLUTION. ADDED FANS AS CIRCLED.	WN WC EO 8/22/01
3	INCORPORATED: FCN-157.	WC WC EO 2/23/04
0	ER 25966 04/23/04	CBG

AS BUILT

VERIFY ALL DOCUMENTS FOR CURRENT REVISION AND PENDING CHANGES PRIOR TO EACH USE
INIT _____ DATE _____

UNLESS OTHERWISE SPECIFIED
ALL DIMENSIONS IN INCHES

FILE NAME 911_D_030
PLOT SCALE 1=1
D SPEC # 0000
NEXT ASSEMBLY

DRAFTER ARR DATE 06/30/00
CHECKER MJG DATE 06/30/00
ENGINEER DUJB DATE 06/30/00

DATABASE LINKED DRAWING.
SEE ENGINEERING RELEASE FORM (ER) FOR DRAWING APPROVAL SIGNATURES.

DWG SIZE D

VENDOR:

FOR Westinghouse Government Services Group
WEST VALLEY NUCLEAR SERVICES CO.
WEST VALLEY N.Y.

REMOTE HANDLED WASTE FACILITY
GENERAL ARRANGEMENT
UPPER ROOF PLAN

SCALE 1/8"=1'-0"
WEIGHT
A/E DWG #
A/E CONTRACT #
DWG # 911_D-030
REV 03
SHEET 7 OF 7
CODE IDENT #

CAD DRAWING-DO NOT REVISE THIS ORIGINAL