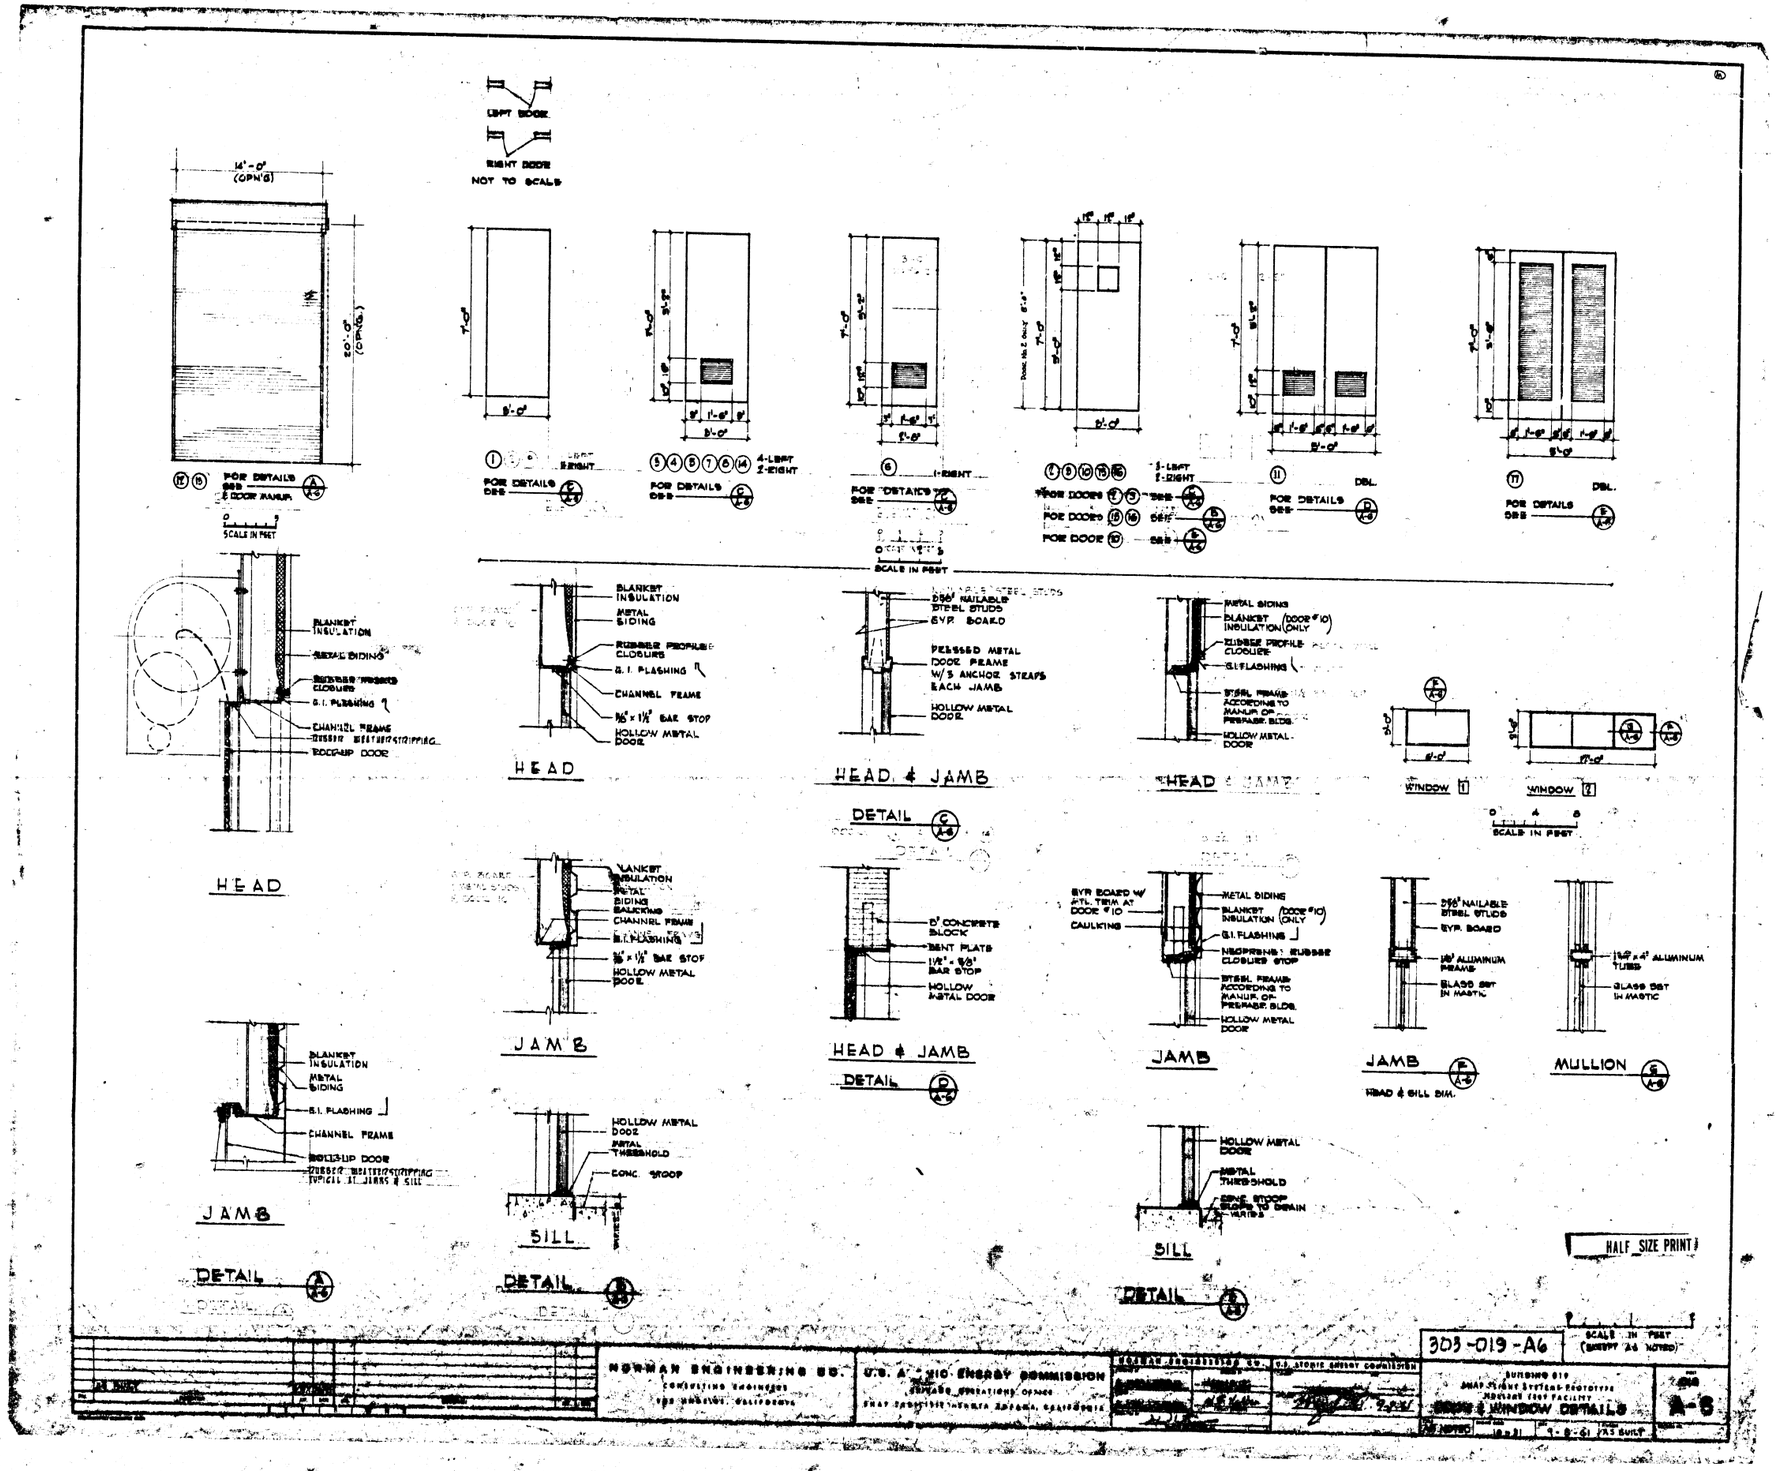

303-019-A6

SCALE IN FEET (EXCEPT AS NOTED)

NORMAN ENGINEERING CO.
CONSULTING ENGINEERS
LOS ANGELES, CALIFORNIA

U.S. ATOMIC ENERGY COMMISSION
SAN FRANCISCO OPERATIONS OFFICE
SNAP PROPULSION PLANT, SANTA SUSANA, CALIFORNIA

NORMAN ENGINEERING CO. | U.S. ATOMIC ENERGY COMMISSION

BUILDING 019
SNAP FLIGHT SYSTEMS PROTOTYPE
NUCLEAR TEST FACILITY
DOOR & WINDOW DETAILS

AS NOTED | 10-31 | 9-8-61 | AS BUILT

A-6