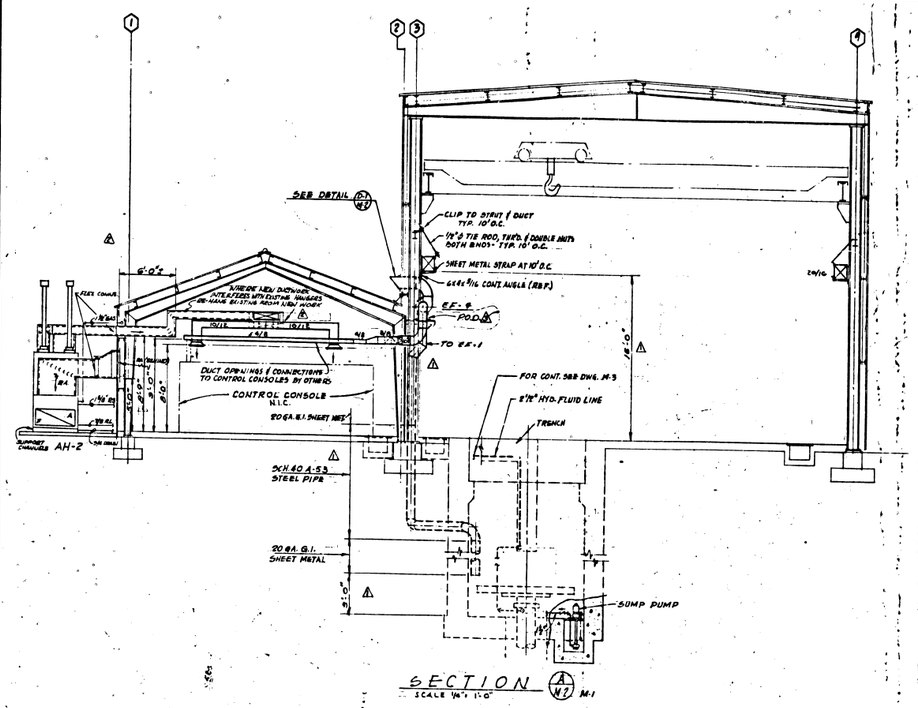

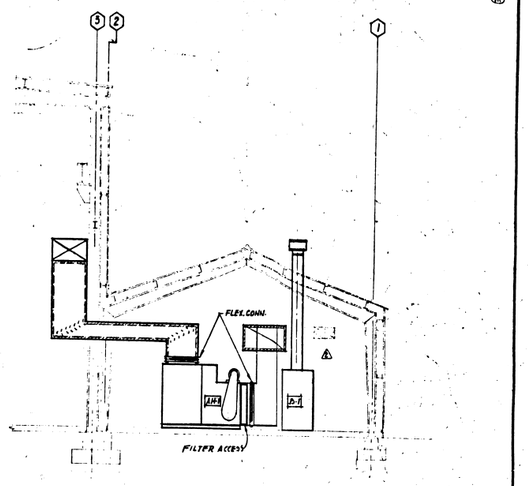

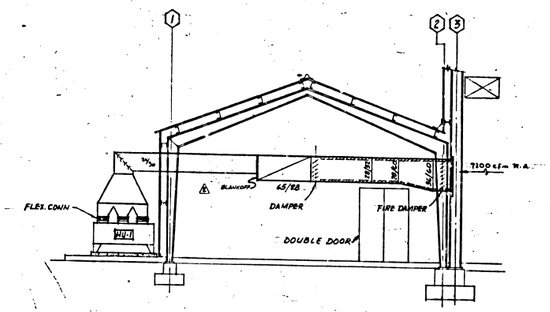

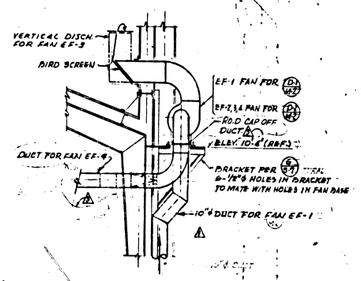

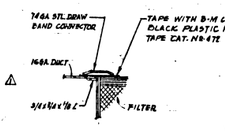

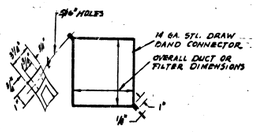


NORMAN ENGINEERING CO.
CONSULTING ENGINEERS
LOS ANGELES, CALIFORNIA

U.S. ATOMIC EMERGY COMMISSION
CHICAGO OPERATIONS OFFICE
SNAP FACILITIES-SANTA SUSANA, CALIFORNIA

NORMAN ENGINEERING CO.		U.S. ATOMIC ENERGY COMMISSION	
DRAWN M. R. WITHIN	CHECKED H.E. CLARK	APPROVED	DATE
TRACED D. L. BWIN	APPROVED W. E. Miller		9-5-51

303-019-M2

BUILDING 019
SNAP FLIGHT SYSTEMS PROTOTYPE NUCLEAR TEST FACILITY
HEAT, VENT. & AIR COND. SECTIONS & DETAILS

SCALE	DATE	STATUS	DRAWING NO.
1/4"=1'-0"	9-5-51	AS BUILT	M-2

HALF SIZE PRINT