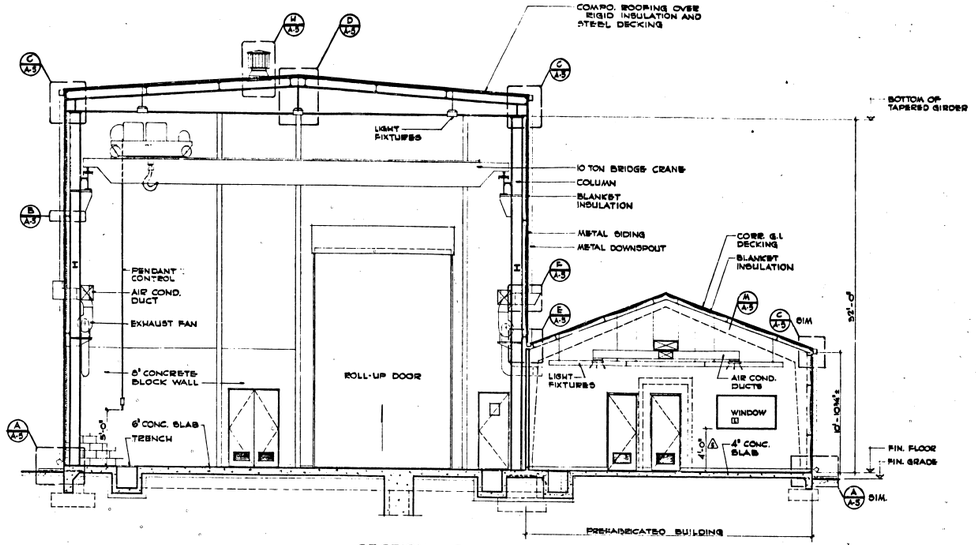

SECTION (A/A-5) A-1

SCALE IN FEET 0 1 4 8

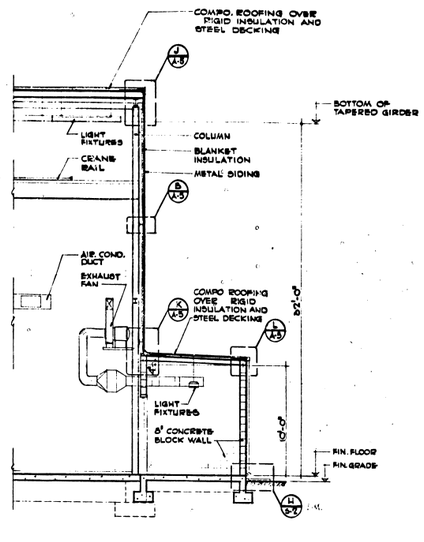

SECTION (B/A-5) A-1

SCALE IN FEET 0 1 4 8

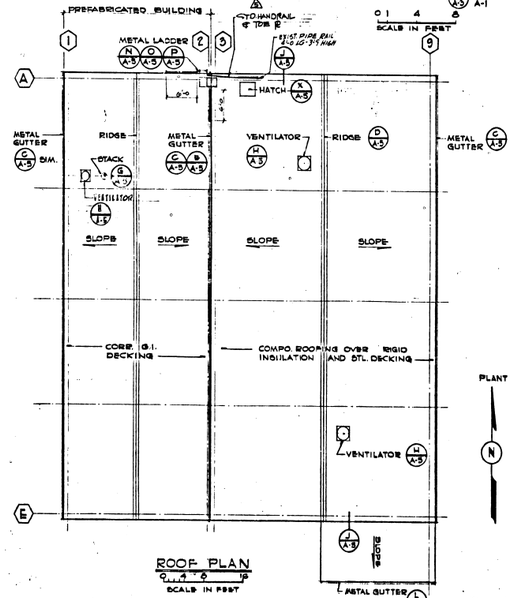

ROOF PLAN

SCALE IN FEET 0 4 8 16

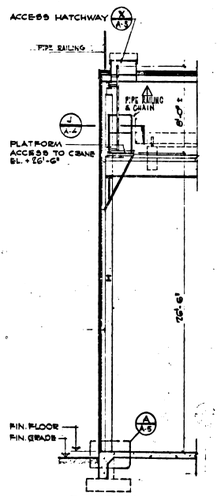

SECTION (C/A-5) A-1

SCALE IN FEET 0 4 8

HALF SIZE PRINT

REVISIONS			
NO.	DESCRIPTION	BY	DATE
1	AS BUILT	KPK	12-61
2	REVISED PER BULLETIN NO 1	KPK	1-62
3	REVISED PER LOCATION NO 9	KPK	5-62
4	REVISED PER LOCATION NO 1	KPK	5-62

NORMAN ENGINEERING CO.
CONSULTING ENGINEERS
LOS ANGELES, CALIFORNIA

U.S. ATOMIC ENERGY COMMISSION
CHICAGO OPERATIONS OFFICE
SNAP FACILITIES-SANTA SUSANA, CALIFORNIA

NORMAN ENGINEERING CO.
Drawn by: A.A. POST
Checked by: A. MILLGREEN
Project Engineer: J.A. WAGNER
Approved: W.F. KELLER
Date: 9-5-61

U.S. ATOMIC ENERGY COMMISSION
Approved: [signature]
Date: 9-5-61

303-019-A3

BUILDING 019
SNAP FLIGHT SYSTEMS PROTOTYPE
NUCLEAR TEST FACILITY
SECTIONS & ROOF PLAN

019 A-3

AS NOTED | 7-31 | 9-8-61