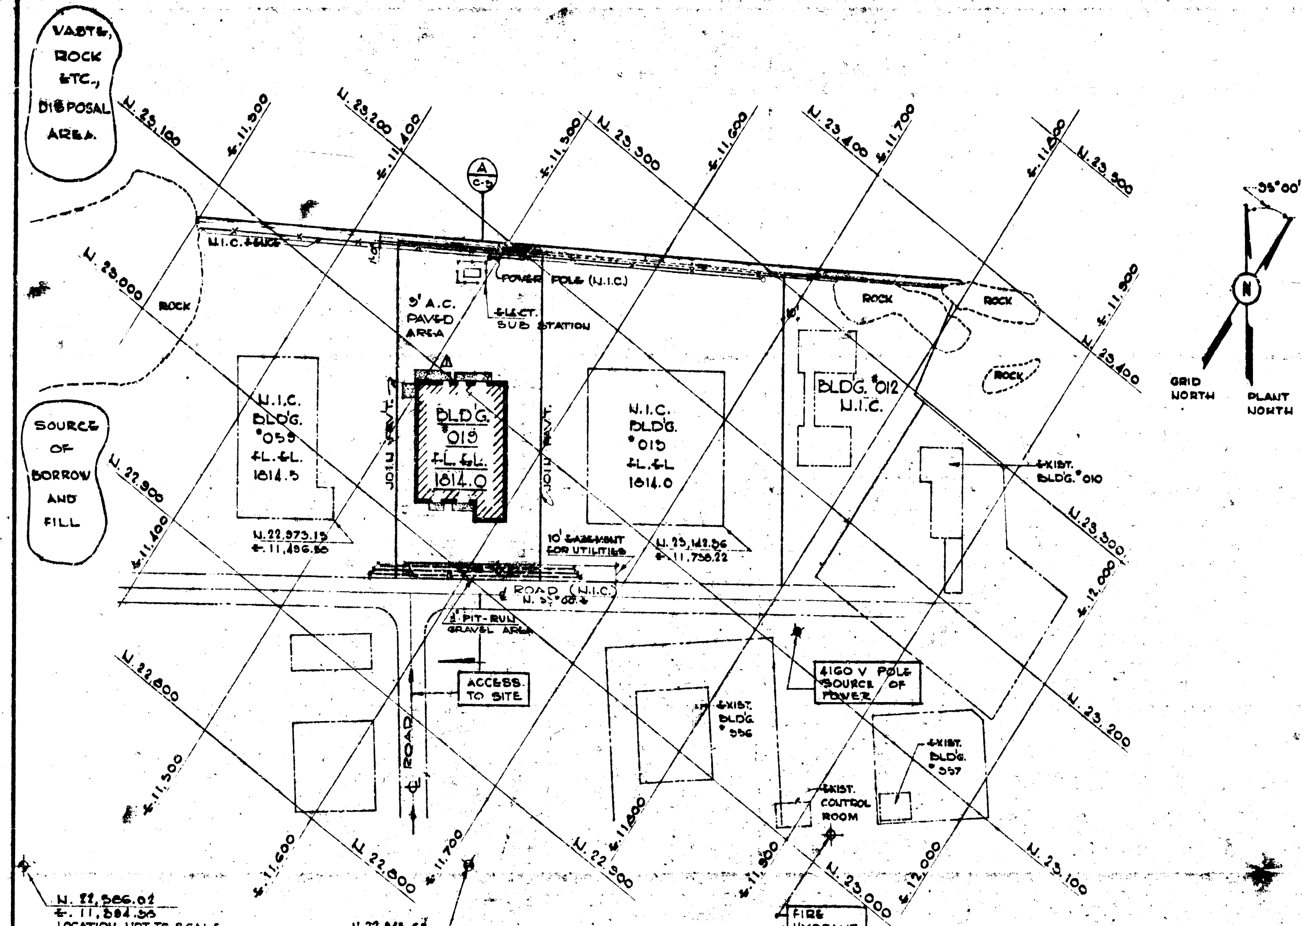

SITE PLAN

0 40 80
SCALE IN FEET

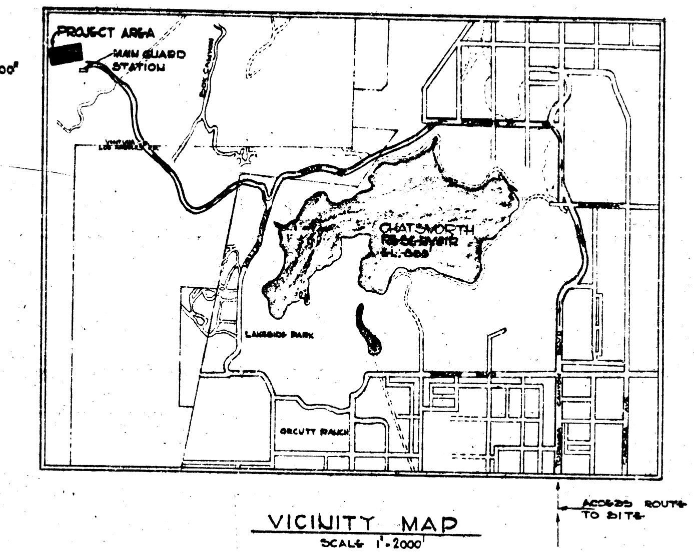

VICINITY MAP

SCALE 1"=2000'

LEGEND:

(hatched)	WORK UNDER THIS CONTRACT
(shaded)	NEW PAVING
(outline)	EXISTING OR N.I.C. WORK
N.I.C.	NOT IN CONTRACT
(symbol)	EXISTING BENCH MARK

NOTES:

1. EXISTING STOCK PILE OF BORROW & FILL IS APPROX. IN AREA N. 22,850 AND E. 11,250
2. WASTE DISPOSAL AREA IS APPROX. N. 22,700 AND E. 11,100. CONTRACTING OFFICER WILL FURNISH EXACT LOCATION.

HALF SIZE PRINT

NORMAN ENGINEERING CO.
CONSULTING ENGINEERS
LOS ANGELES, CALIFORNIA

U.S. ATOMIC ENERGY COMMISSION
CHICAGO OPERATIONS OFFICE
SAN FRANCISCO—SANTA SUSANA, CALIFORNIA

303-019-C1

BUILDING 019

SITE & VICINITY MAP

C-1

AS BUILT