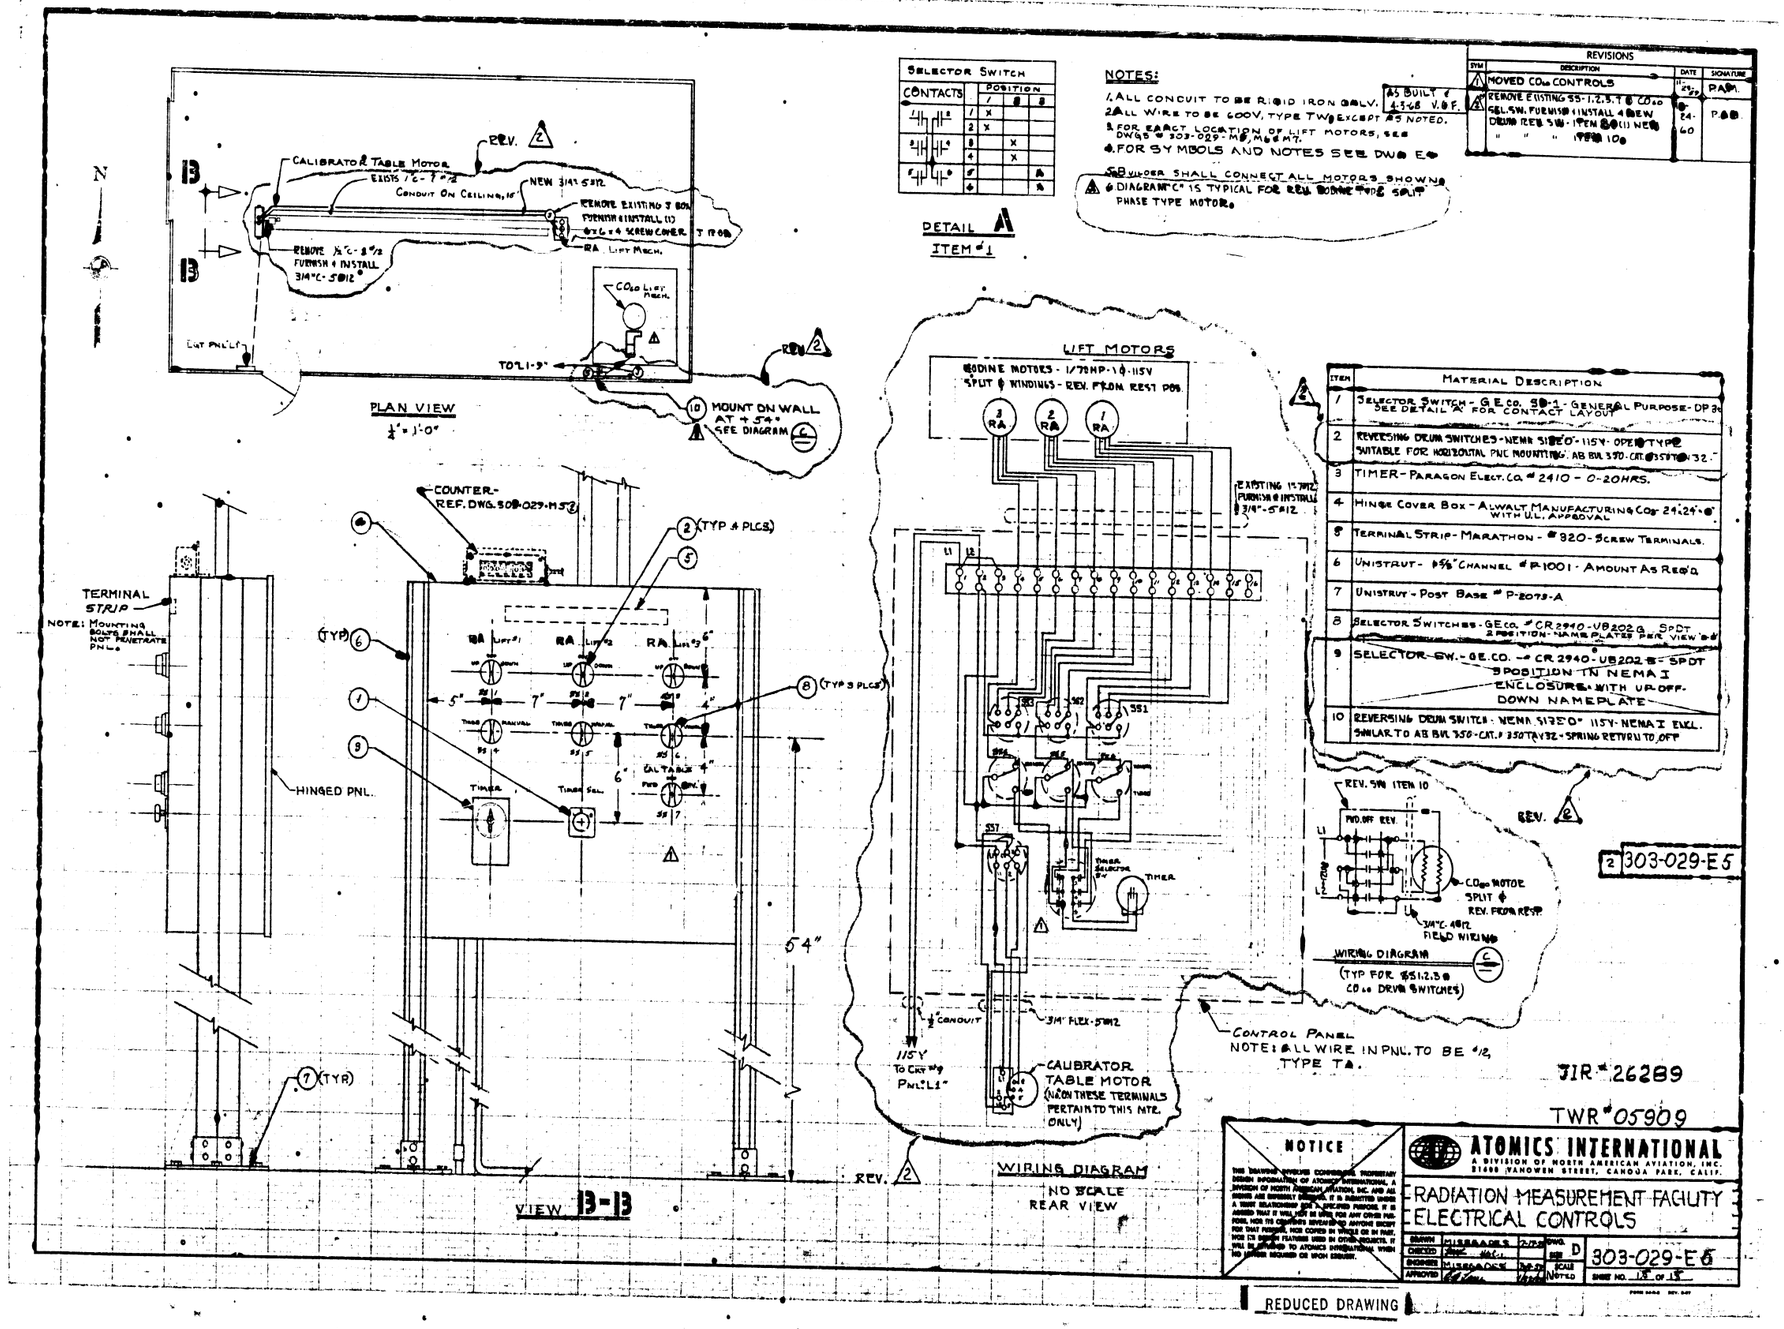

SELECTOR SWITCH			
CONTACTS	POSITION		
	1	2	3
1	X		
2	X		
3		X	
4		X	
5			X
6			X

DETAIL A
ITEM #1

NOTES:

1. ALL CONDUIT TO BE RIGID IRON GALV.
2. ALL WIRE TO BE 600V, TYPE TW EXCEPT AS NOTED.
3. FOR EXACT LOCATION OF LIFT MOTORS, SEE DWGS # 303-029-M8, M6 & M7.
4. FOR SYMBOLS AND NOTES SEE DWG E6

AS BUILT 4-3-68 V.B.F.

SUBVENDOR SHALL CONNECT ALL MOTORS SHOWN @ DIAGRAM C IS TYPICAL FOR REV. CO60 TYPE SPLIT PHASE TYPE MOTOR.

REVISIONS			
SYM	DESCRIPTION	DATE	SIGNATURE
1	MOVED CO60 CONTROLS	11-25-64	PABM
2	REMOVE E LISTING 55-1,2,5,7 & CO60 SEL. SW. FURNISH & INSTALL 4 NEW DRUM REV. SW. ITEM 5 & (1) NEW " " " ITEM 10	4-24-60	PAB

ITEM	MATERIAL DESCRIPTION
1	SELECTOR SWITCH - G.E. CO. SB-1 - GENERAL PURPOSE - DP 3 POS. SEE DETAIL A FOR CONTACT LAYOUT
2	REVERSING DRUM SWITCHES - NEMA 5132D - 115V - OPEN TYPE SUITABLE FOR HORIZONTAL PNL MOUNTING. AB BUL 350 - CAT. # 350TA132
3	TIMER - PARAGON ELECT. CO. # 2410 - 0-20 HRS.
4	HINGE COVER BOX - ALWALT MANUFACTURING CO. 24"x24"x8" WITH U.L. APPROVAL
5	TERMINAL STRIP - MARATHON - # 820 - SCREW TERMINALS.
6	UNISTRUT - P56 CHANNEL # P1001 - AMOUNT AS REQ'D.
7	UNISTRUT - POST BASE # P-2073-A
8	SELECTOR SWITCHES - G.E. CO. # CR 2940 - UB202 G - SPDT 2 POSITION - NAME PLATES PER VIEW B-B
9	SELECTOR SW. - G.E. CO. # CR 2940 - UB202 B - SPDT 3 POSITION IN NEMA I ENCLOSURE WITH UP-OFF-DOWN NAMEPLATE
10	REVERSING DRUM SWITCH: NEMA 5132D 115V - NEMA I ENCL. SIMILAR TO AB BUL 350 - CAT. # 350TA132 - SPRING RETURN TO OFF

2 303-029-E5

JIR # 26289

TWR # 05909

NOTICE

THIS DRAWING CONTAINS CONFIDENTIAL PROPRIETARY DESIGN INFORMATION OF ATOMICS INTERNATIONAL, A DIVISION OF NORTH AMERICAN AVIATION, INC. AND ALL RIGHTS ARE EXPRESSLY RESERVED. IT IS SUBMITTED UNDER A TRUST RELATIONSHIP FOR A LIMITED PURPOSE. IT IS AGREED THAT IT WILL NOT BE USED FOR ANY OTHER PURPOSE, NOR ITS CONTENTS REVEALED TO ANYONE EXCEPT FOR THAT PURPOSE, NOR COPIED IN WHOLE OR IN PART, NOR ITS DESIGN FEATURES USED IN OTHER PRODUCTS. IT WILL BE RETURNED TO ATOMICS INTERNATIONAL WHEN NO LONGER REQUIRED OR UPON REQUEST.

ATOMICS INTERNATIONAL
A DIVISION OF NORTH AMERICAN AVIATION, INC.
21600 VANOWEN STREET, CANOGA PARK, CALIF.

RADIATION MEASUREMENT FACILITY
ELECTRICAL CONTROLS

DRAWN	HUBBARD	7-7-59	DWG. SIZE	D	303-029-E6
CHECKED					
ENGINEER	HUBBACK		SCALE	NOTED	
APPROVED			SHEET NO. 13 OF 13		