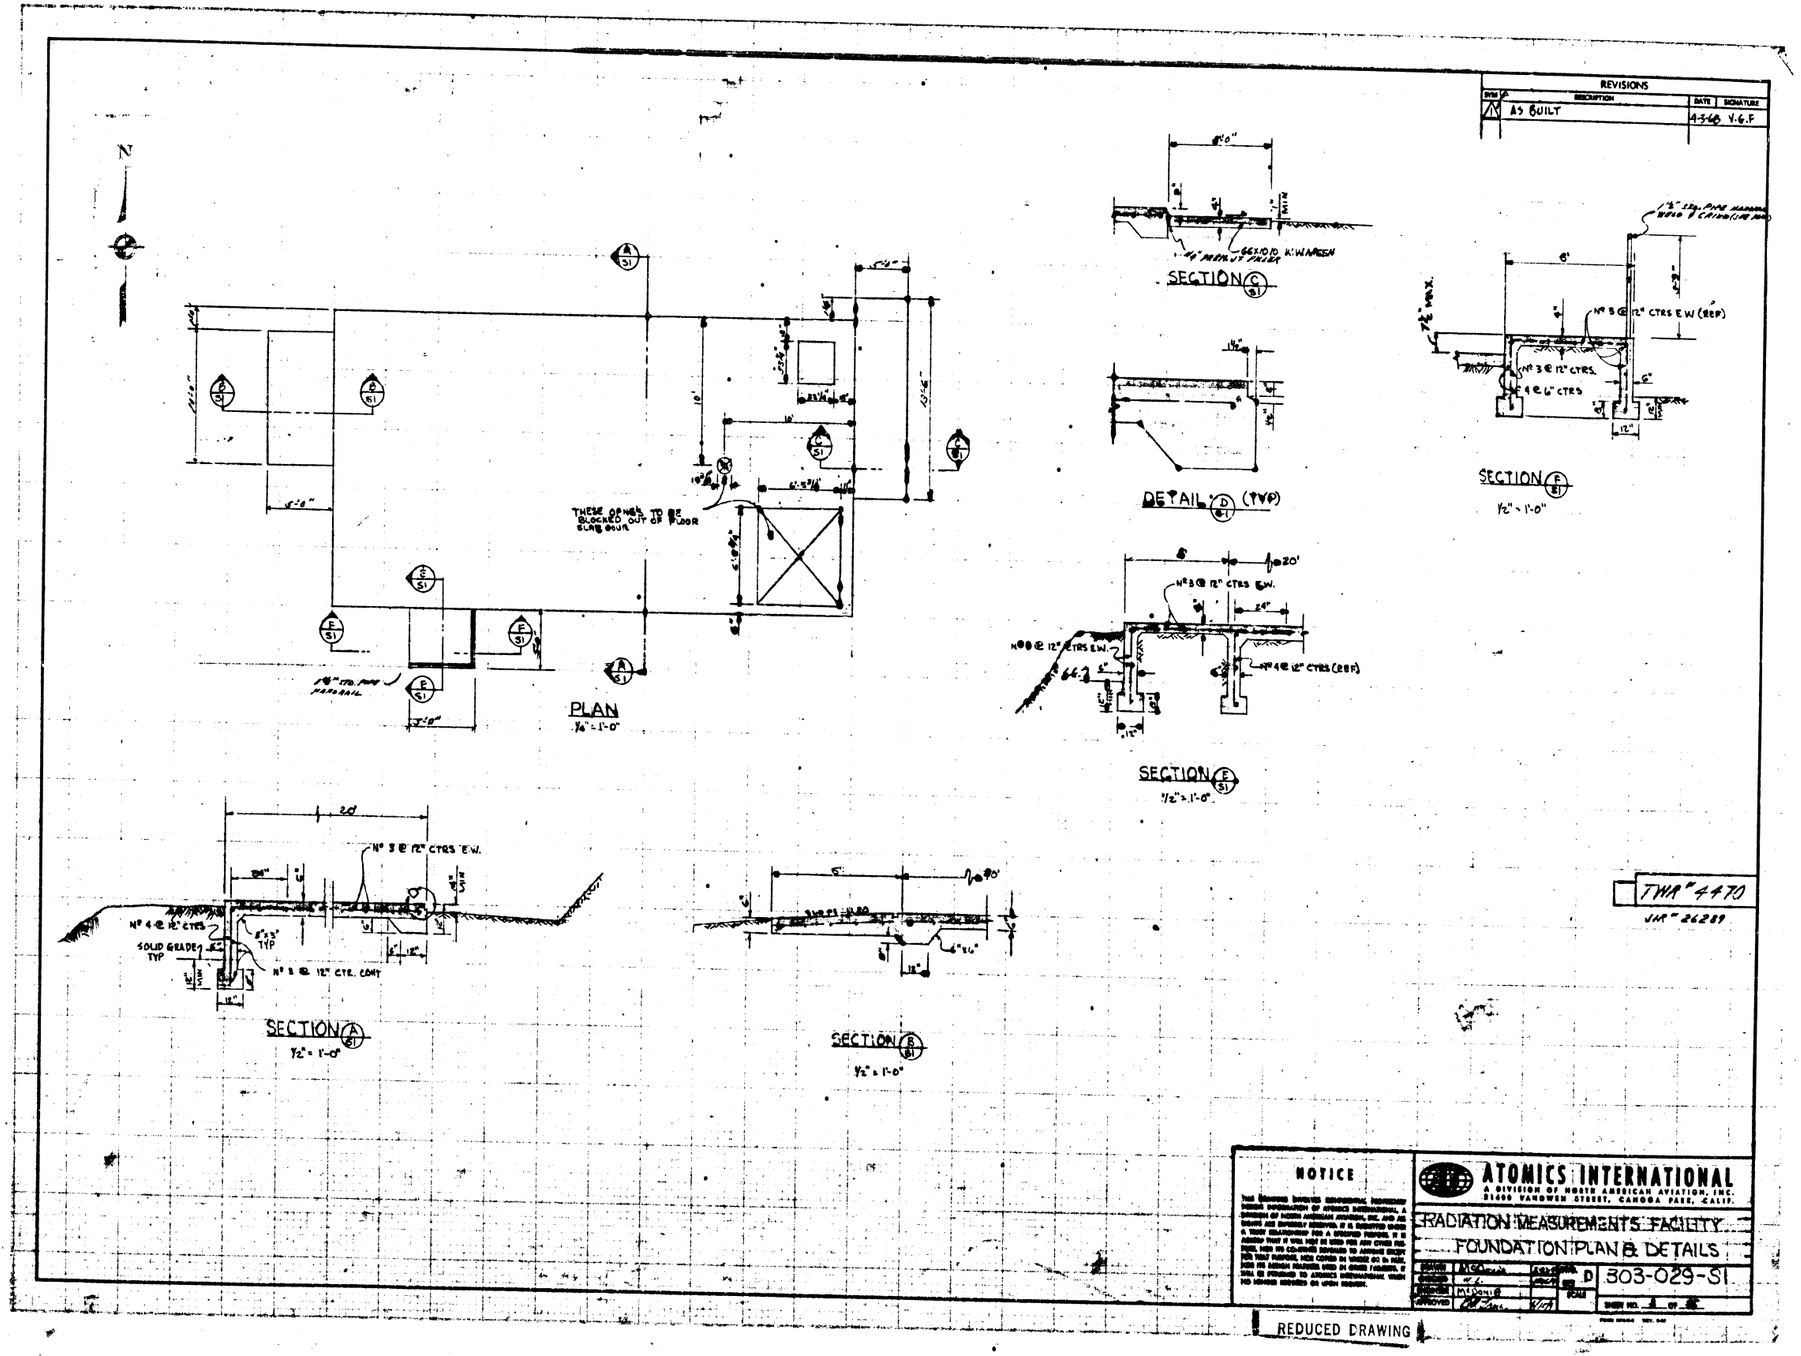
REVISIONS
AS BUILT
4-3-68 V.G.F
N
PLAN
1/4" = 1'-0"
THESE OPNGS TO BE BLOCKED OUT OF FLOOR SLAB POUR
SECTION C S1
DETAIL D S1 (TYP)
SECTION F S1
1/2" = 1'-0"
SECTION E S1
1/2" = 1'-0"
SECTION A S1
1/2" = 1'-0"
SECTION B S1
1/2" = 1'-0"
SOLID GRADE TYP
TWR # 4470
JIR # 26289
NOTICE
ATOMICS INTERNATIONAL
A DIVISION OF NORTH AMERICAN AVIATION, INC.
21400 VANOWEN STREET, CANOGA PARK, CALIF.
RADIATION MEASUREMENTS FACILITY
FOUNDATION PLAN & DETAILS
D
303-029-S1
REDUCED DRAWING