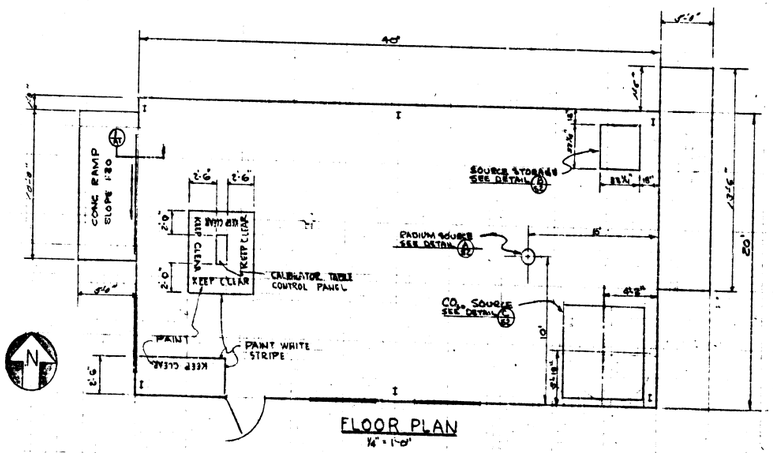

FLOOR PLAN
1/4" = 1'-0"

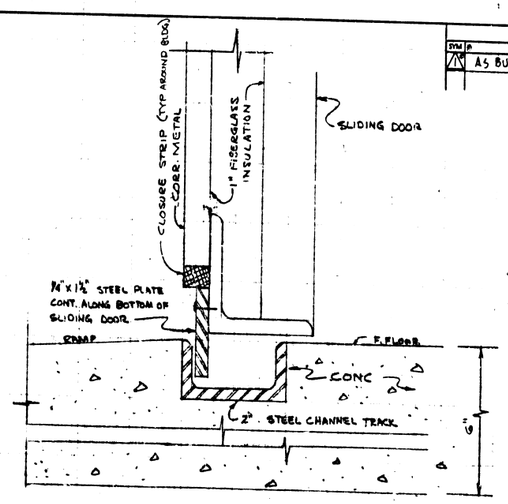

DETAIL (1/A1)
FULL SIZE

REVISIONS			
SYM	DESCRIPTION	DATE	SIGNATURE
A	AS BUILT	4-3-68	V.G.F

NOTES:
1. CEILING WALLS AND SLIDING DOOR TO BE INSULATED WITH OWENS-CORNING FIBERGLAS PF GFL, 1" THICK, KRAFT FACED, PAINTED.
2. FLOOR TO BE SURFACED WITH ASPHALT TILE
3. EXTERIOR PAINTING: 1 COAT TO BE POLYMON WITH "BASE" LATEX CAT. 4 SERIES 1214 TO BE OBTAINED FROM DUREZ.
4. ALL ANTI-CAKE SILICONE INTERIOR TO BE APPLIED TO (2) FINISH COATS PLUS PRIME COAT- COLOR E (MED. GRAY)
5. STENCILING AND WARNING LETTERS TO BE PAINTED- COLOR N (WHITE)- TEMPO PAINT
6. COLOR CODE NUMBERS REFER TO THE COLOR HARMONY MANUAL, 13th EDITION AS PUBLISHED BY THE CONTAINER CORPORATION OF AMERICA.

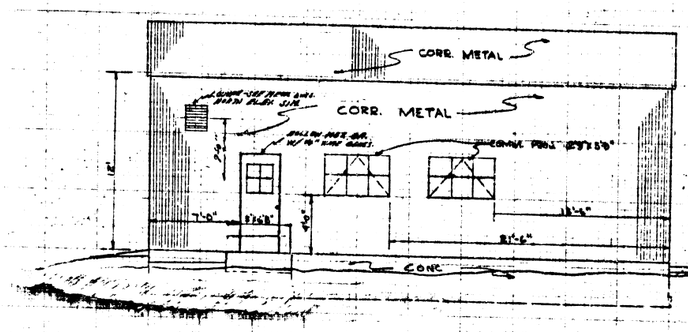

SOUTH ELEVATION
3/4" = 1'-0"

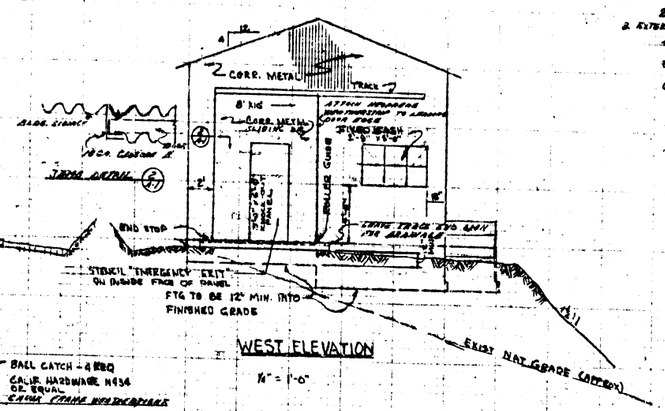

WEST ELEVATION
1/4" = 1'-0"

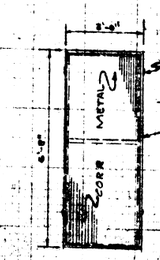

BALL CATCH - 4 REQ
CALIF. HARDWARE N434 OR EQUAL
DOOR FRAME ∠ 1 1/2 X 1 1/2 X 3/16

DETAIL - KNOCK OUT PANEL
1/2" = 1'-0"

TWR # 4470
JIR # 26289

NOTICE

THIS DRAWING SUBMITTED CONFIDENTIAL PROPERTY OF NORTH AMERICAN AVIATION, INC. AND ITS DIVISIONS AND SUBSIDIARY COMPANIES. IT IS SUBMITTED UNDER A TRUST RELATIONSHIP FOR A SPECIFIED PURPOSE, IT IS UNDERSTOOD THAT IT WILL NOT BE USED FOR ANY OTHER PURPOSE, NOR ITS CONTENTS DISCLOSED TO ANYONE EXCEPT FOR THAT PURPOSE, NOR COPIED IN WHOLE OR IN PART, NOR BY ANYONE FURNISHED SUCH OR SIMILAR PURPOSES, IT WILL BE RETURNED TO NORTH AMERICAN AVIATION, INC. WHEN NO LONGER REQUIRED FOR SUCH PURPOSE.

ATOMICS INTERNATIONAL
A DIVISION OF NORTH AMERICAN AVIATION, INC.
81000 WARNOWEN STREET, CANOGA PARK, CALIF.

RADIATION MEASUREMENTS FACILITY
PLAN-ELEVATIONS-DETAILS

DRAWN	M.C. Davis	2-2-68	SIZE D	303-029-A1
CHECKED	P.C.	2-2-68		
ENGINEER	M.C. Davis	2-2-68	SCALE	
APPROVED	[illegible]	2-2-68	SHEET NO. 2 OF 4	

REDUCED DRAWING