REVISIONS			
SYM	DESCRIPTION	DATE	SIGNATURE
1	"AS BUILT" REVISIONS	9-26-64	JL

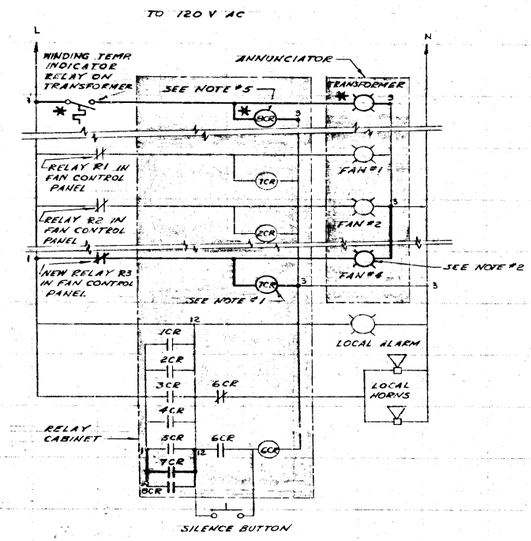

PARTIAL DIAGRAM OF ANNUNCIATOR AND RELAY CABINET

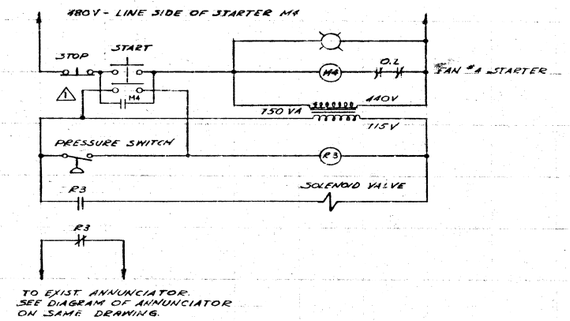

DIAGRAM - CONTROL OF FAN #4

NOTES

1. WIRE EXIST. SPARE RELAY 7CR AS SHOWN IN HEAVY LINES ON DIAGRAM.
2. WIRE SPARE INDICATING LIGHT IN ANNUNCIATOR AS SHOWN AND PROVIDE NAME PLATE, TO MATCH EXISTING, TO READ FAN NO. 4.
3. USE EXISTING SPARE WIRES.
4. REARRANGE EXISTING DEVICES WHERE REQUIRED TO ACCOMODATE NEW DEVICES.
5. * PROVIDE AND INSTALL SPNO RELAY, STRUTHERS DUNN, CAT# 18HXX, WITH 115V AC COIL.
6. FOR SYMBOLS SEE DWG 303-021-E1

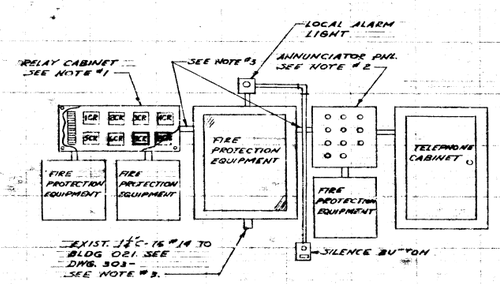

ALL ABOVE EQUIPMENT IS EXISTING EXCEPT RELAY BCR (SEE NOTE #5)

ELEVATION (D/E1)

SCALE: NONE

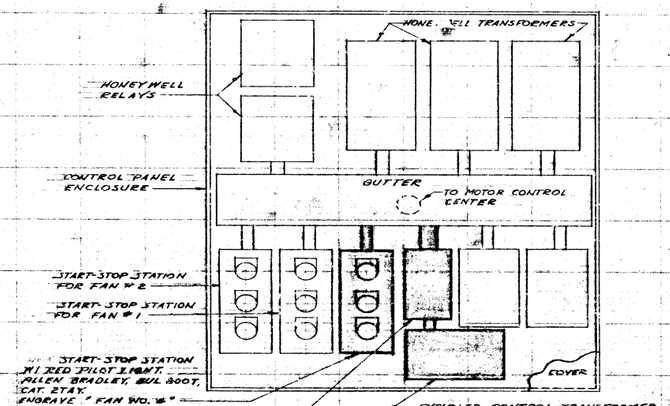

ONLY EQUIPMENT SHOWN SHADED IS NEW. SEE NOTE 4

FAN CONTROL PANEL

ELEVATION (C/E1)

303-021-E2

TWR 20536
JIR 29091-5, 7521-4224

NOTICE

THIS DRAWING INVOLVES CONFIDENTIAL PROPRIETARY DESIGN INFORMATION OF ATOMICS INTERNATIONAL, A DIVISION OF NORTH AMERICAN AVIATION, INC. AND ALL RIGHTS ARE EXPRESSLY RESERVED. IT IS SUBMITTED UNDER A TRUST RELATIONSHIP FOR A SPECIFIED PURPOSE. IT IS AGREED THAT IT WILL NOT BE USED FOR ANY OTHER PURPOSE, NOR ITS CONTENTS REVEALED TO ANYONE EXCEPT FOR THAT PURPOSE, NOR COPIED IN WHOLE OR IN PART, NOR ITS DESIGN FEATURES USED IN OTHER PROJECTS. IT WILL BE RETURNED TO ATOMICS INTERNATIONAL WHEN NO LONGER REQUIRED OR UPON REQUEST.

ATOMICS INTERNATIONAL
A DIVISION OF NORTH AMERICAN AVIATION, INC.
21600 VANOWEN STREET, CANOGA PARK, CALIF.

R/A WASTE & FUEL STORAGE BLDGS 21 & 22
EXHAUST MODIF. DIAGRAMS & DETAILS

DRAWN	J. LOWENSON	11/16/64	DWG. SIZE D	303-021-E2
CHECKED				
ENGINEER	J. LOWENSON		SCALE NONE	SHEET NO. 2 OF 2
APPROVED	[illegible]	11/16		

REDUCED DRAWING