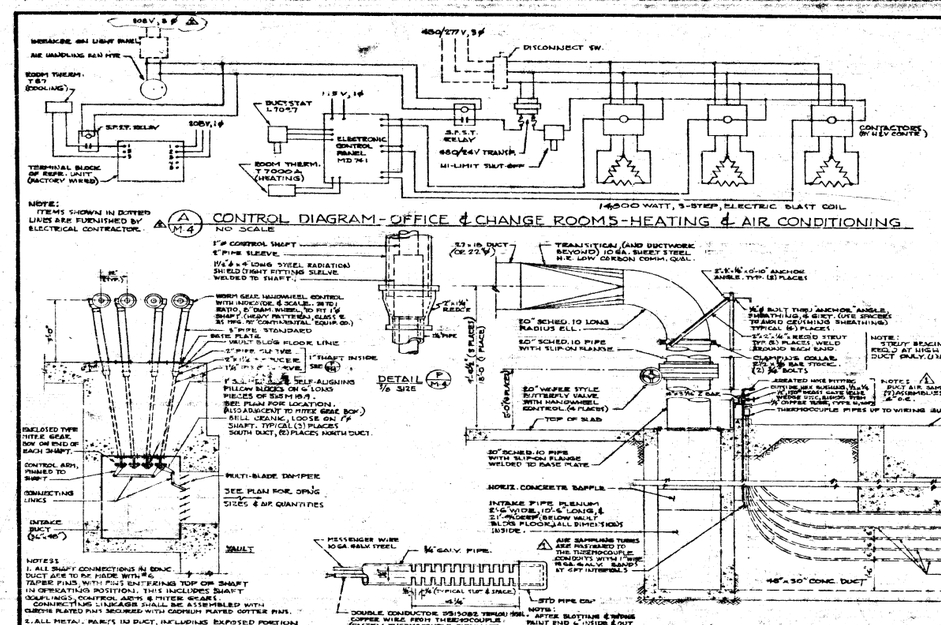

NOTE: ITEMS SHOWN IN DOTTED LINES ARE FURNISHED BY ELECTRICAL CONTRACTOR.

(A) M-4 CONTROL DIAGRAM - OFFICE & CHANGE ROOMS - HEATING & AIR CONDITIONING
NO SCALE

NOTES:
1. ALL SHAFT CONNECTIONS AT DUCT DUCT ARE TO BE MADE WITH 1/4" TAPER PINS WITH PINS ENTERING TOP OR SHAFT IN OPERATING POSITION. THIS INCLUDES SHAFT COUPLINGS, CONTROL ARMS & MITER GEARS. CONNECTING LINKAGES SHALL BE ASSEMBLED WITH CADMIUM PLATED PINS SECURED WITH CADMIUM PLATED COTTER PINS.
2. ALL METAL PARTS IN DUCT, INCLUDING EXPOSED PORTION OF ANCHOR BOLTS, LINKAGE AND DAMPER ASSEMBLY, SHALL BE PAINTED WITH ONE COAT TETROLEUM PRIMER, AND ONE COAT ALUMINUM TO FINISH BEFORE INSTALLATION. SHAFTS AND COUPLINGS BE EXPOSED IN DUCT, SO PRE TWO COATS OF PAINT AFTER ASSEMBLY AND TESTING. SHAFT TURNING VERTICALLY IN SLEEVES, SAME TWO COATS, BEFORE ASSEMBLY.

NOTE: STEADY BEARING STUD AT HIGH DUCT SHOWN

NOTES:
1. ALL SAMPLING STATIONS (T) AND (P) ARE IDENTICAL.
2. SEE "SEQUENCE OF OPERATION" IN SPECIFICATIONS FOR EXPLANATION OF OPERATION.
3. ITEMS SHOWN IN DOTTED LINES ARE FURNISHED BY ELEC. CONTRACTOR.

(B) M-4 CONTROL DIAGRAM - EXH. FAN 1 & 2
NO SCALE.

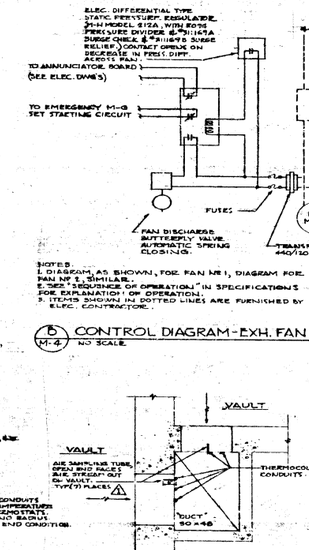

NOTES:
1. DIAGRAM AS SHOWN, FOR FAN NO 1, DIAGRAM FOR FAN NO 2, SIMILAR.
2. SEE "SEQUENCE OF OPERATION" IN SPECIFICATIONS FOR EXPLANATION OF OPERATION.
3. ITEMS SHOWN IN DOTTED LINES ARE FURNISHED BY ELEC. CONTRACTOR.

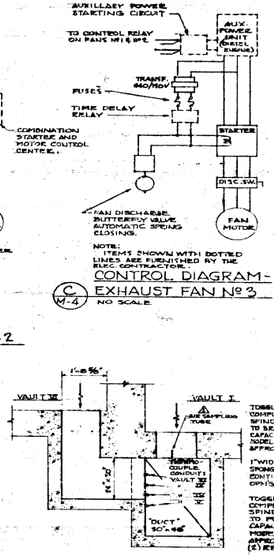

NOTE: ITEMS SHOWN WITH DOTTED LINES ARE FURNISHED BY THE ELEC. CONTRACTOR.

(C) M-4 CONTROL DIAGRAM - EXHAUST FAN NO 3
NO SCALE.

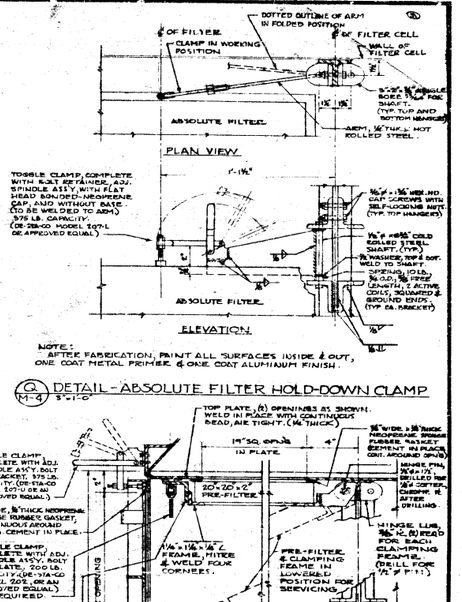

NOTE: AFTER FABRICATION, PRINT ALL SURFACES INSIDE & OUT, ONE COAT METAL PRIMER & ONE COAT ALUMINUM FINISH.

(G) M-4 DETAIL - ABSOLUTE FILTER HOLD-DOWN CLAMP
3"=1'-0"

FULLY INSULATED CONDENSATE DRAIN LINE FROM D-X COIL, 3/4" COPPER TUBE.

(I) M-4 DETAIL - CONDENSATE DRAIN LINE
1/4"=1'-0"

NOTE: SECTION AS SHOWN IS FOR AIR INTAKES AT NORTH END OF BLDG, AIR INTAKE AT SOUTH END SIMILAR, EXCEPT FOR NUMBER OF FILTER ELEMENTS.

(H) M-4 SECTION - VAULT AIR INTAKE
1/2"=1'-0"

NOTES:
AFTER FABRICATION, PAINT ALL SURFACES ONE COAT METAL PRIMER & ONE COAT ALUMINUM FINISH.

(J) M-4 DETAIL - FILTER CELL DOOR
1/2"=1'-0"

NOTES:
1. SEE PLAN FOR OPENING SIZES AND AIR QUANTITIES.

NOTES:
1. SEE PLAN FOR OPENING SIZES AND AIR QUANTITIES.

(E) M-4 SECTION - VAULT EXHAUST
1/2"=1'-0"

(F) M-4 SECTION - VAULT VI EXHAUST
1/2"=1'-0"

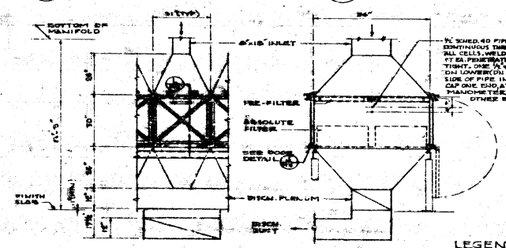

(K) M-4 DETAIL - FILTER CELL

LEGEND
H.R.S. HOT ROLLED STEEL
M.O. MASONRY OPENING (CLEAR.)

NOTES:
1. AFTER FABRICATION, PAINT ALL SURFACES INSIDE & OUT, ONE COAT METAL PRIMER & ONE COAT ALUMINUM FINISH. (DO NOT PAINT GASKETS)
2. ALL MATERIAL 10 GA. (1/8") H.R. STEEL SHEET LOW CARBON COMMERCIAL QUALITY, EXCEPT WHERE OTHERWISE NOTED. WELD ALL SEAMS AIRTIGHT.

(L) M-4 SECTION - DETAILS OF FILTER CELL
3"=1'-0"

HALF SIZE PRINT

3-10-70	AS BUILT	PHJH	D&C
1-30-70	REVISED W/ ADDENDUM	PHJH	D&C

APPROVED: U. S. ATOMIC ENERGY COMMISSION
[illegible] 4-23-70

William J. Lacey 3/16/70

DANIEL, MANN, JOHNSON, & MENDENHALL
ARCHITECTS & ENGINEERS
3325 WILSHIRE BOULEVARD - LOS ANGELES 5, CALIFORNIA - TELEPHONE DUNKIRK 2-3605

U.S. ATOMIC ENERGY COMMISSION
CHICAGO OPERATIONS OFFICE

NRA WASTE AND FUEL STORAGE
SANTA SUSANA, CALIFORNIA

HEATING, VENTILATING & AIRCONDITIONING SECTIONS & DETAILS

JOB NO.	204-1-1
DRAWING NO.	M-4
DATE	SEPT. 25, 1969

303-022-M4