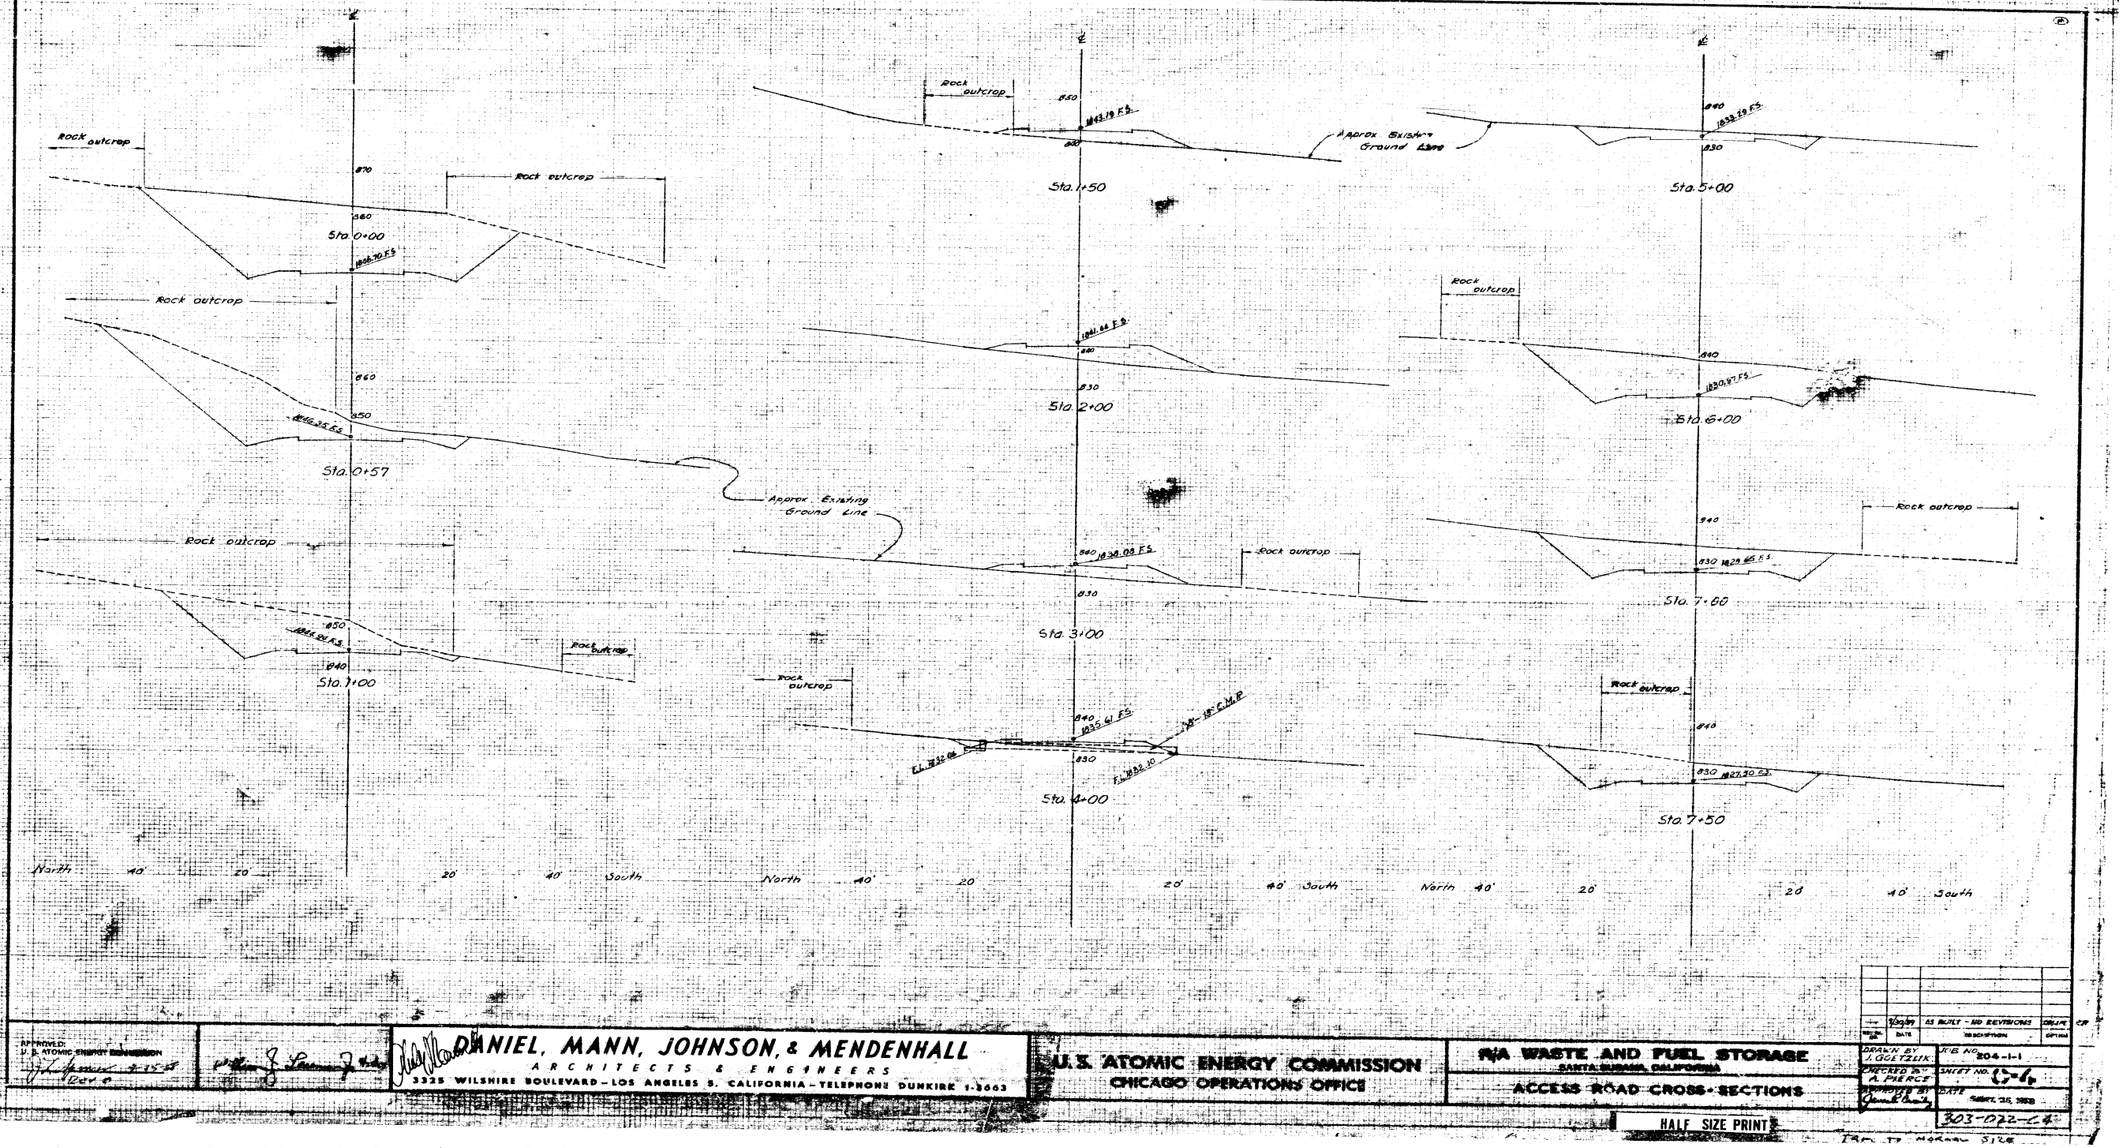

APPROVED:
U. S. ATOMIC ENERGY COMMISSION

DANIEL, MANN, JOHNSON, & MENDENHALL
ARCHITECTS & ENGINEERS
3325 WILSHIRE BOULEVARD – LOS ANGELES 5, CALIFORNIA – TELEPHONE DUNKIRK 1-3663

U. S. ATOMIC ENERGY COMMISSION
CHICAGO OPERATIONS OFFICE

N/A WASTE AND FUEL STORAGE
SANTA SUSANA, CALIFORNIA
ACCESS ROAD CROSS-SECTIONS

HALF SIZE PRINT

NO.	DATE	DESCRIPTION	DRAWN	CHK'D
	Sept '59	AS BUILT - NO REVISIONS		

DRAWN BY J. GOLTZLIK
CHECKED BY A. PIERCE
APPROVED BY
DRG. NO. 204-1-1
SHEET NO. C5-6
DATE Sept. 25, 1959
303-022-C-6

FOR 11" x 17" SIZE