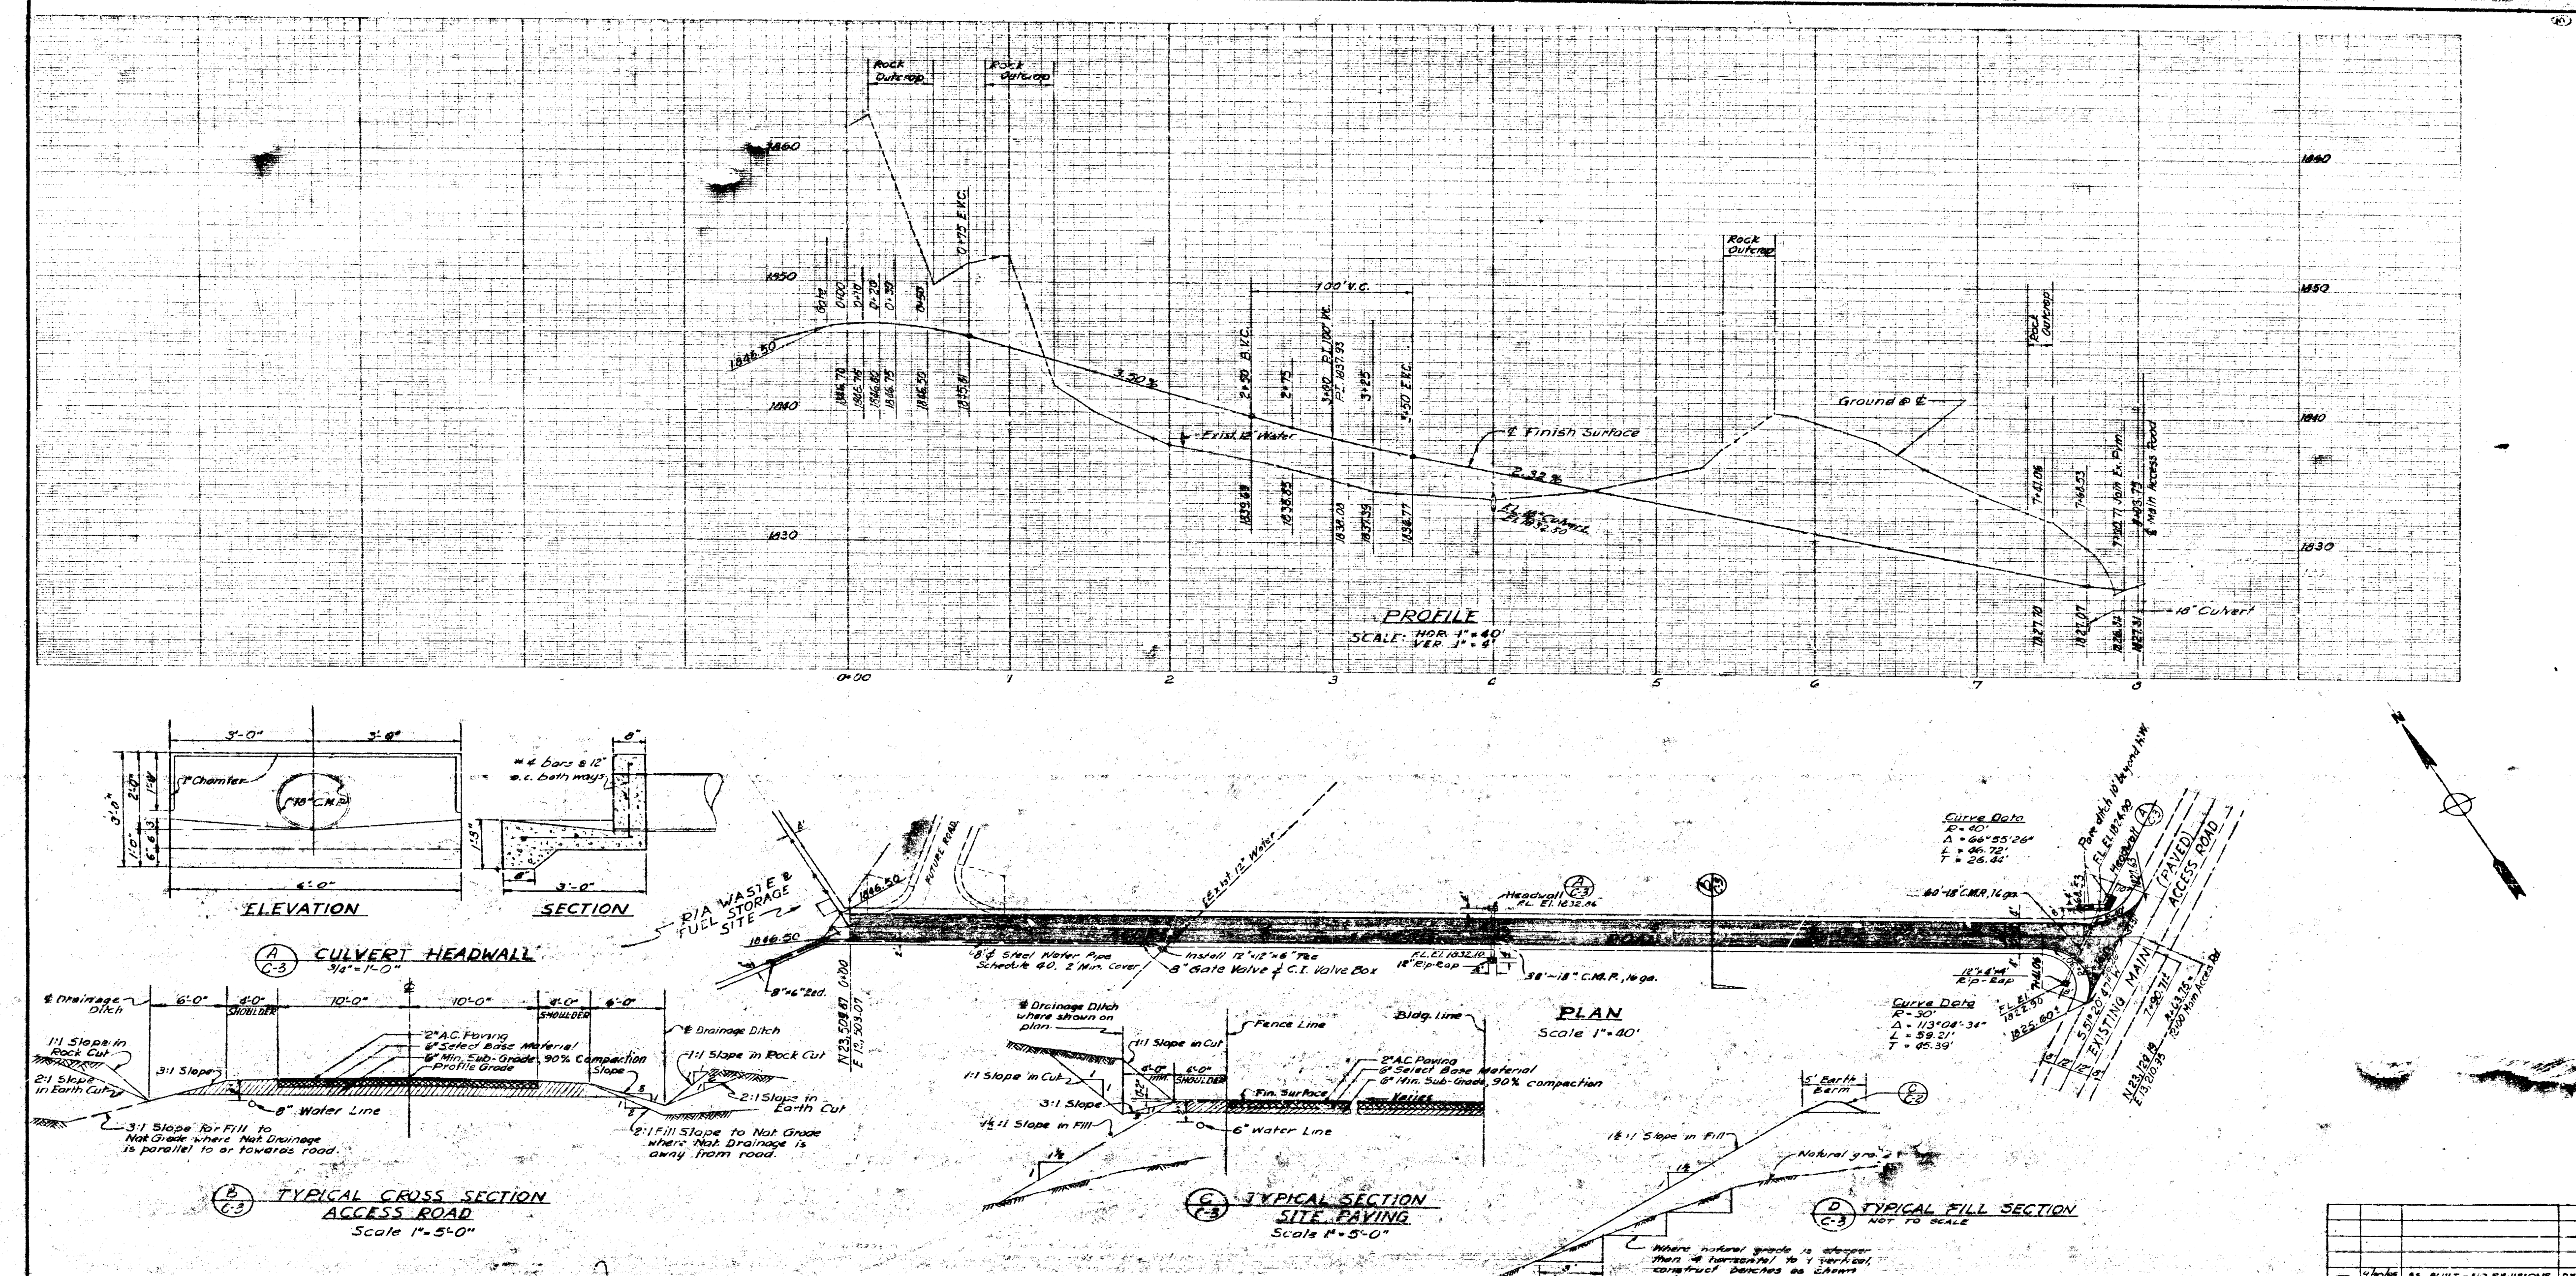

Revision No.	Date	Description	By
—	4/30/59	AS BUILT - NO REVISIONS	DRJM R.P.

APPROVED:
U. S. ATOMIC ENERGY COMMISSION
[signature] 4-30-58
Rev. 0

[signature]

DANIEL, MANN, JOHNSON, & MENDENHALL
ARCHITECTS & ENGINEERS
3325 WILSHIRE BOULEVARD - LOS ANGELES 5, CALIFORNIA - TELEPHONE DUNKIRK 1-3663

U.S. ATOMIC ENERGY COMMISSION
CHICAGO OPERATIONS OFFICE

R/A WASTE AND FUEL STORAGE
SANTA SUSANA, CALIFORNIA

ACCESS ROAD & DETAILS

DRAWN BY: J. GOETZLIK
CHECKED BY: A. PIERCE
APPROVED BY: [signature]
JOB NO. 204-1-1
SHEET NO. C-3
DATE SEPT. 25, 1958

303-022-C3

HALF SIZE PRINT

TRIM TO NORMAL SIZE