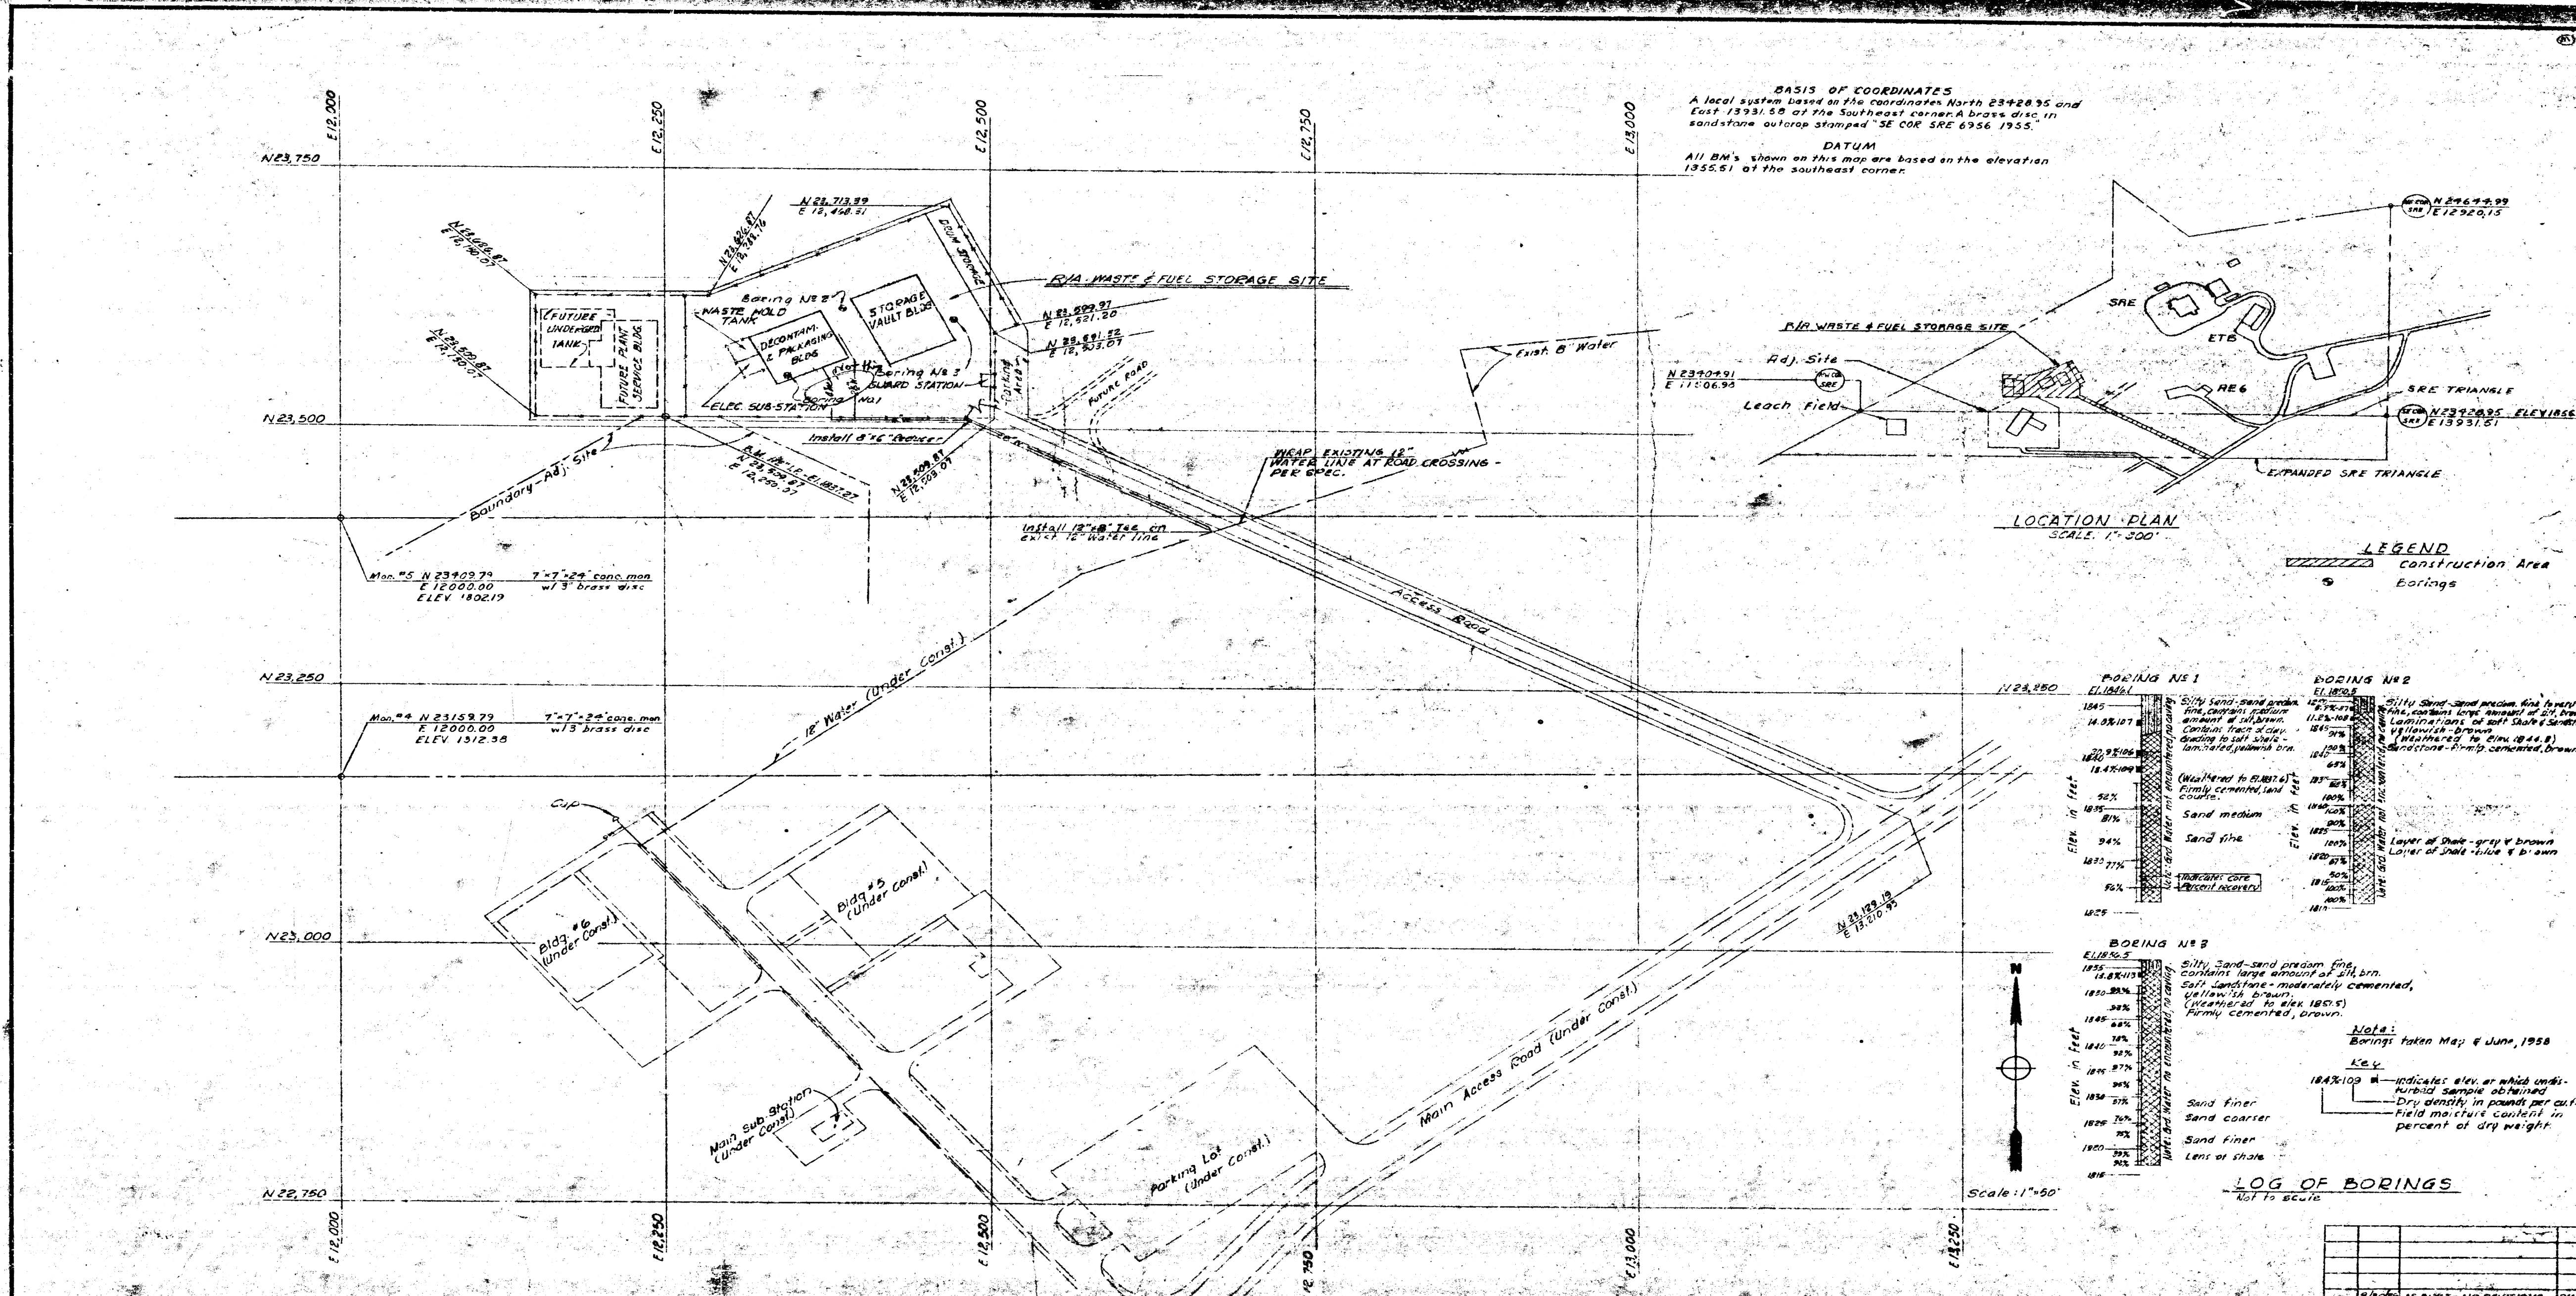

	9/30/59	AS BUILT - NO REVISIONS	R.B.
REVISION	DATE	DESCRIPTION	DRAWN

APPROVED:
U.S. ATOMIC ENERGY COMMISSION

DANIEL, MANN, JOHNSON, & MENDENHALL
ARCHITECTS & ENGINEERS
3325 WILSHIRE BOULEVARD - LOS ANGELES 5, CALIFORNIA - TELEPHONE DUNKIRK 1-3463

U.S. ATOMIC ENERGY COMMISSION
CHICAGO OPERATIONS OFFICE

R/A WASTE AND FUEL STORAGE
SANTA SUSANA, CALIFORNIA
AREA PLAN

Designed by: W. A. Dale Barre
Checked by: W. A. Dale Barre
Job No. 804-1-1
Sheet No. C-1

HALF SIZE PRINT

303-022-C1