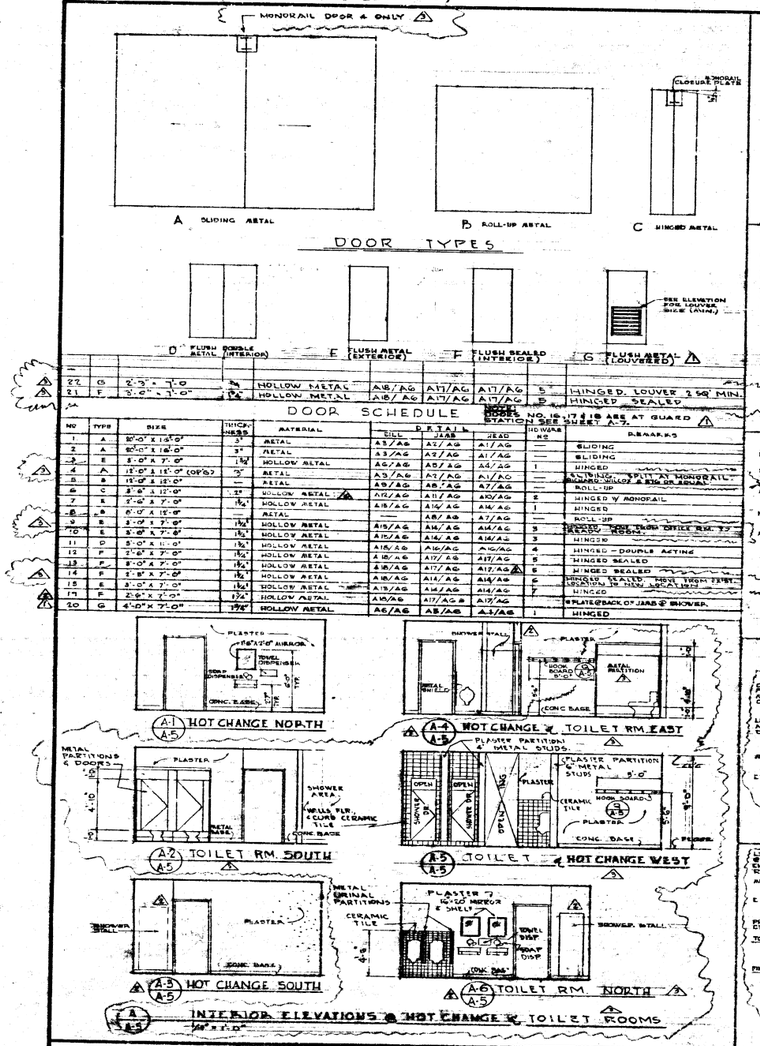

DOOR SCHEDULE

NO	TYPE	SIZE	THICK NESS	MATERIAL	DETAILS SILL / JAMB	HEAD	NO WARE NO	REMARKS

* PLATE @ BACK OF JAMB @ SHOWER.

NOTE: ALL DOORS TO HAVE PANIC HARDWARE EXCEPT DOOR NO. 16 WHICH IS TO HAVE STANDARD PRIVACY LATCH. ALL DOORS TO HAVE KICK PLATES ON PUSH SIDE. DOOR NO. 16 TO HAVE 34" KICK PLATE ON PULL SIDE. DOOR NO. 10 TO HAVE 34" KICK PLATE ON BOTH SIDES. 

DOOR NO. 16, 17 & 18 ARE AT GUARD STATION SEE SHEET A-7.

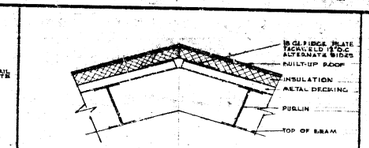

B A-5 RIDGE (D&P BLDG) 1½"=1'-0"

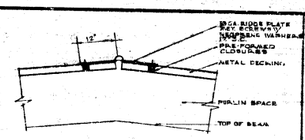

G A-5 RIDGE (VAULT BLDG) 1½"=1'-0"

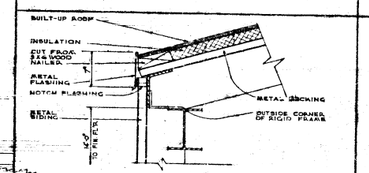

C A-5 EAVE (D&P BLDG) 1½"=1'-0"

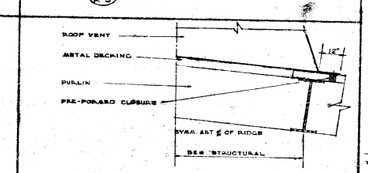

H A-5 VENT OPNG @ RIDGE (VAULT BLDG) 1½"=1'-0"

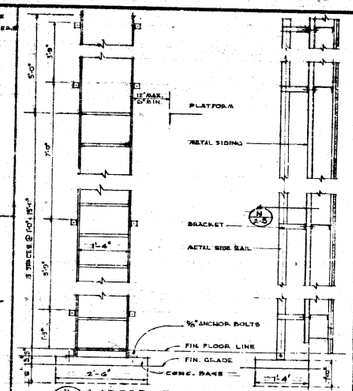

A1 A-5 LADDER ELEVATIONS ¾"=1'-0"

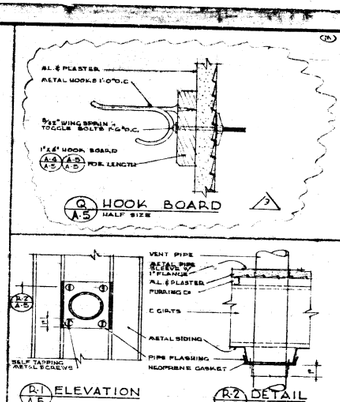

Q A-5 HOOK BOARD HALF SIZE

R-1 A-5 ELEVATION R-2 A-5 DETAIL

P A-5 PIPE SLEEVE THRU WALL 3"=1'-0"

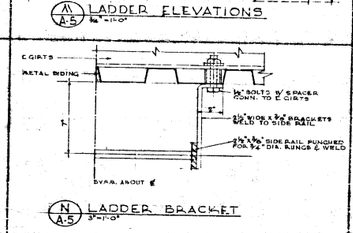

N A-5 LADDER BRACKET 3"=1'-0"

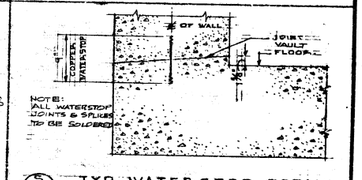

S A-5 TYP. WATERSTOP DETAIL 1½"=1'-0"

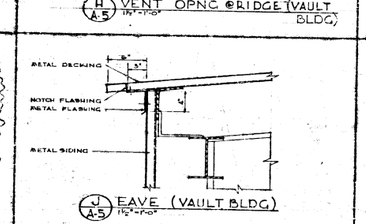

D A-5 RAKE (D&P BLDG) 1½"=1'-0"

J A-5 EAVE (VAULT BLDG) 1½"=1'-0"

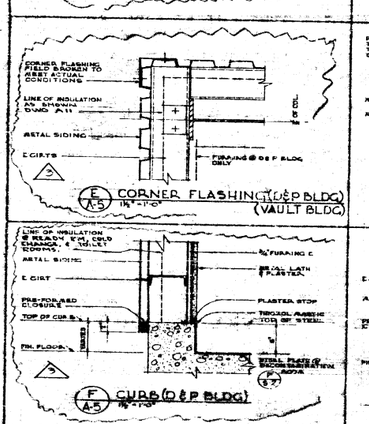

E A-5 CORNER FLASHING (D&P BLDG) (VAULT BLDG) 1½"=1'-0"

F A-5 CURB (D&P BLDG) 1½"=1'-0"

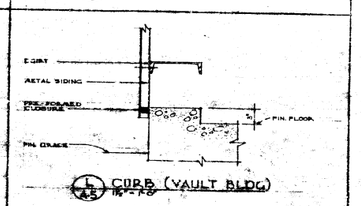

K A-5 RAKE (VAULT BLDG) 1½"=1'-0"

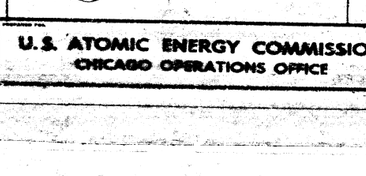


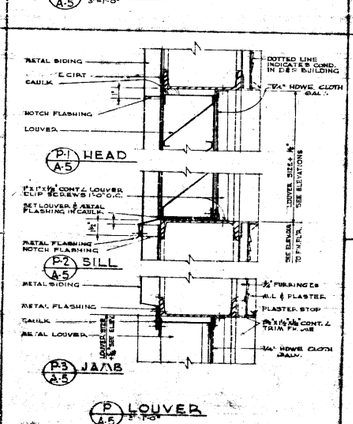

P-1 A-5 HEAD
P-2 A-5 SILL
P-3 A-5 JAMB
P A-5 LOUVER 3"=1'-0"

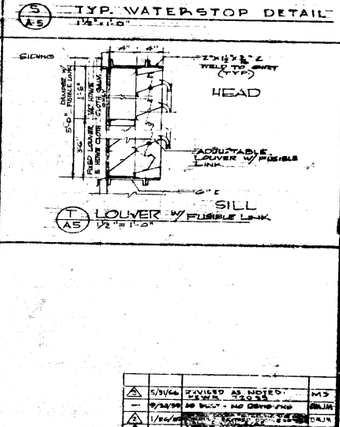

3	5/31/66	REVISED AS NOTED	MJ
2	9/26/66	AS BUILT - NO CHANGE FROM	DRJN C.R.
1	1/24/66	[illegible]	DRJN C.R.
0	7/15/65	ISSUED FOR CONSTRUCTION	DRJN H.C.
NO.	DATE	DESCRIPTION	APPVD

APPROVED: U. S. ATOMIC ENERGY COMMISSION
[signature] 1-25-67

[signature]

DANIEL, MANN, JOHNSON, & MENDENHALL
ARCHITECTS & ENGINEERS
3325 WILSHIRE BOULEVARD – LOS ANGELES 5, CALIFORNIA – TELEPHONE DUNKIRK 7-3663

U.S. ATOMIC ENERGY COMMISSION
CHICAGO OPERATIONS OFFICE

JOB TITLE: R/A WASTE AND FUEL STORAGE
SANTA SUSANA, CALIFORNIA

SHEET TITLE: DOOR SCHEDULE & MISCELLANEOUS DETAILS

DESIGNED BY: DINALANTA
DRAWN BY: FORD
JOB NO. 204-(1-1)
CHECKED BY: [signature]
DATE: SEPT. 25, 1965

303-022-A 5

HALF SIZE PRINT