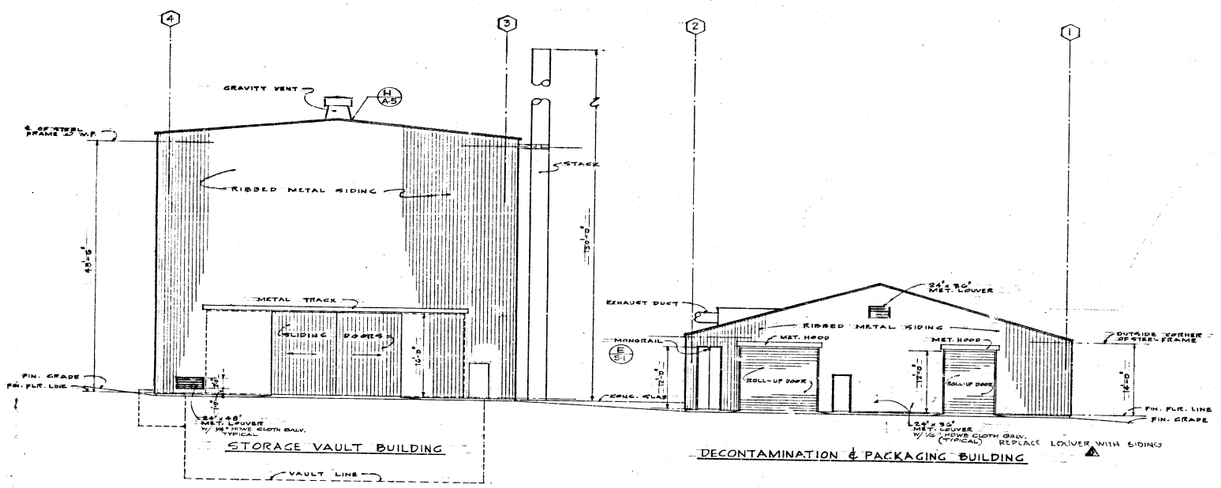

A A-3 NORTH ELEVATION
1/8" = 1'-0"

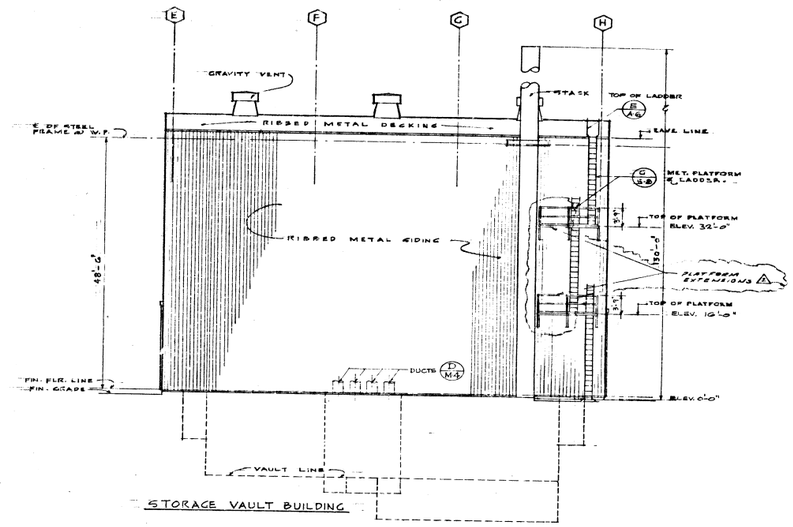

B A-3 WEST ELEVATION
1/8" = 1'-0"

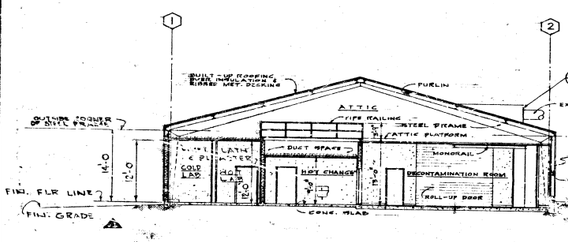

C A-3 SECTION
1/8" = 1'-0"

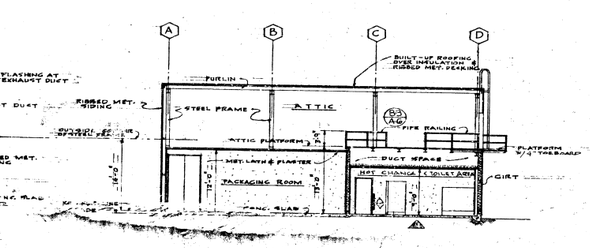

D A-3 SECTION
1/8" = 1'-0"

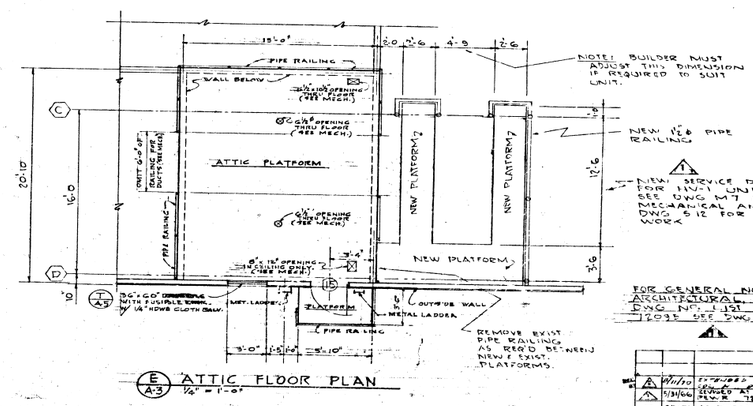

E A-3 ATTIC FLOOR PLAN

APPROVED: U. S. ATOMIC ENERGY COMMISSION

DANIEL, MANN, JOHNSON, & MENDENHALL
ARCHITECTS & ENGINEERS
3325 WILSHIRE BOULEVARD – LOS ANGELES 5, CALIFORNIA – TELEPHONE DUNKIRK 1-3663

PREPARED FOR: U.S. ATOMIC ENERGY COMMISSION
CHICAGO OPERATIONS OFFICE

JOB TITLE: R/A WASTE AND FUEL STORAGE
SANTA SUSANA, CALIFORNIA

SHEET TITLE: ELEVATIONS, SECTIONS & ATTIC PLAN

REV. NO.	DATE	DESCRIPTION	DR.	CK.
2	8/16/66	ADDED ATTIC PLATFORMS		
1	5/31/66	REVISED ATTIC PLATFORM		
—	9/26/58	AS BUILT - NO CHANGES		

DRAWN BY: T.T. OLIVER
JOB NO.: 204-1-1
DESIGNED BY: DMALANTA
SHEET NO.: A-3
DATE: SEPT. 26, 1958
303-022-A3

HALF SIZE PRINT

VELLUM RELEASE