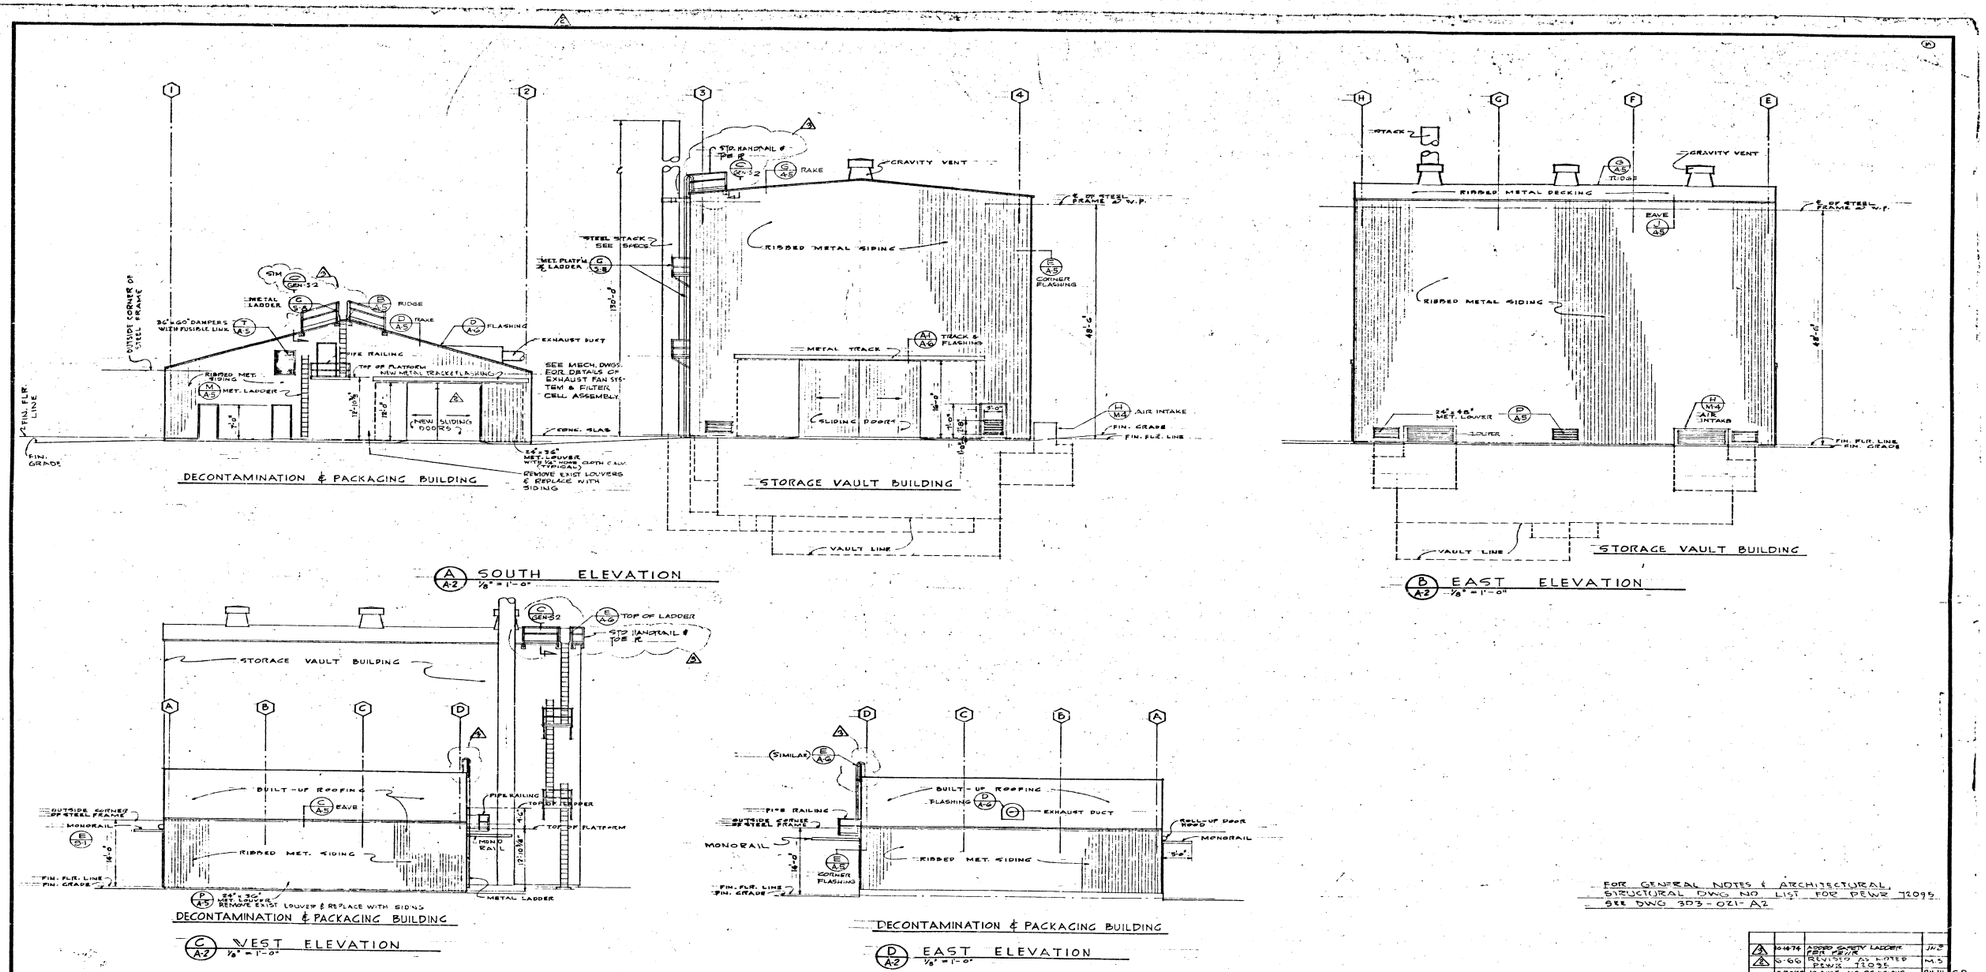

FOR GENERAL NOTES & ARCHITECTURAL, STRUCTURAL DWG NO LIST FOR PEWR 72095 SEE DWG 303-021-A2

REVISION NO.	DATE	DESCRIPTION	DRWN	CHKD
3	10-16-74	ADDED SAFETY LADDER FOR PEWR	JHE	
2	6-66	REVISED AS NOTED PEWR 72095	M.S.	
—	9/30/59	AS BUILT - NO RS/15-2048	DWJH	G.R.
1	11/24/58	ADDED EMERGENCY EXIT DOOR & DOOR DIMENSIONS	DWJH	H.C.

APPROVED: U. S. ATOMIC ENERGY COMMISSION

William J. Lessmann Jr. 9/25/58

DANIEL, MANN, JOHNSON, & MENDENHALL
ARCHITECTS & ENGINEERS
3326 WILSHIRE BOULEVARD - LOS ANGELES 5, CALIFORNIA - TELEPHONE DUNKIRK 1-3663

PREPARED FOR
U.S. ATOMIC ENERGY COMMISSION
CHICAGO OPERATIONS OFFICE

JOB TITLE: R/A WASTE AND FUEL STORAGE
SANTA SUSANA, CALIFORNIA

SHEET TITLE: ELEVATIONS

DRAWN BY: T.T. OLIVER
CHECKED BY: DIMALANTA
APPROVED BY: James R. Amiel
JOB NO. 204-1-1
SHEET NO. 1 OF 2
DATE: SEPT 25, 1958

303-022-A2

HALF SIZE PRINT