STORAGE VAULT ACCESS PLUG OR COVER SCHEDULE

VAULT	COVER DIMENSIONS THICK.	BASIC WIDTH "W"	LENGTH	NO. PER VAULT	DETAILS WIDTH K-SEC.	LENGTH K-SEC.	SLEEVES TYPE	NO. PER COVER	REMARKS
I	8¼"	6'-8"	16'-2"	4	A/S-4	D/S-4	A	70	
II	8½"	6'-5"	18'-9"	4	C/S-4	D/S-4	D	14	
III	8½"	6'-5"	6'-9"	4	E/S-4	F/S-4	B	16	
IV	2'-6"	7'-6¾"	13'-7"	2	G/S-4	H/S-4	C	18	EACH
(2 VAULTS)	2'-6"	8'-3¾"	12'-7"	2	G/S-4	H/S-4	C	12	VAULT
V	3'-6"	6'-5"	7'-9"	4	E/S-4	F/S-4	B	20	
VI	2'-6"	6'-11¾"	8'-2"	8	J/S-4	J/S-4	—	—	[illegible]

STORAGE VAULT COVER SLEEVE SCHEDULE (L/S-4)

SLEEVE TYPE	r (IN.)	r' (IN.)	t (IN.)	t' (IN.)	h (IN.)	TOTAL EACH REQ'D.	REMARKS
A	3/16	2 3/4	5/16	5/16	42	280	
B	7	6 5/16	5/16	3/4	42	144	
C	10	8 3/4	1/4	1	30	120	
D	12	11 3/8	1/4	1 1/4	42	56	

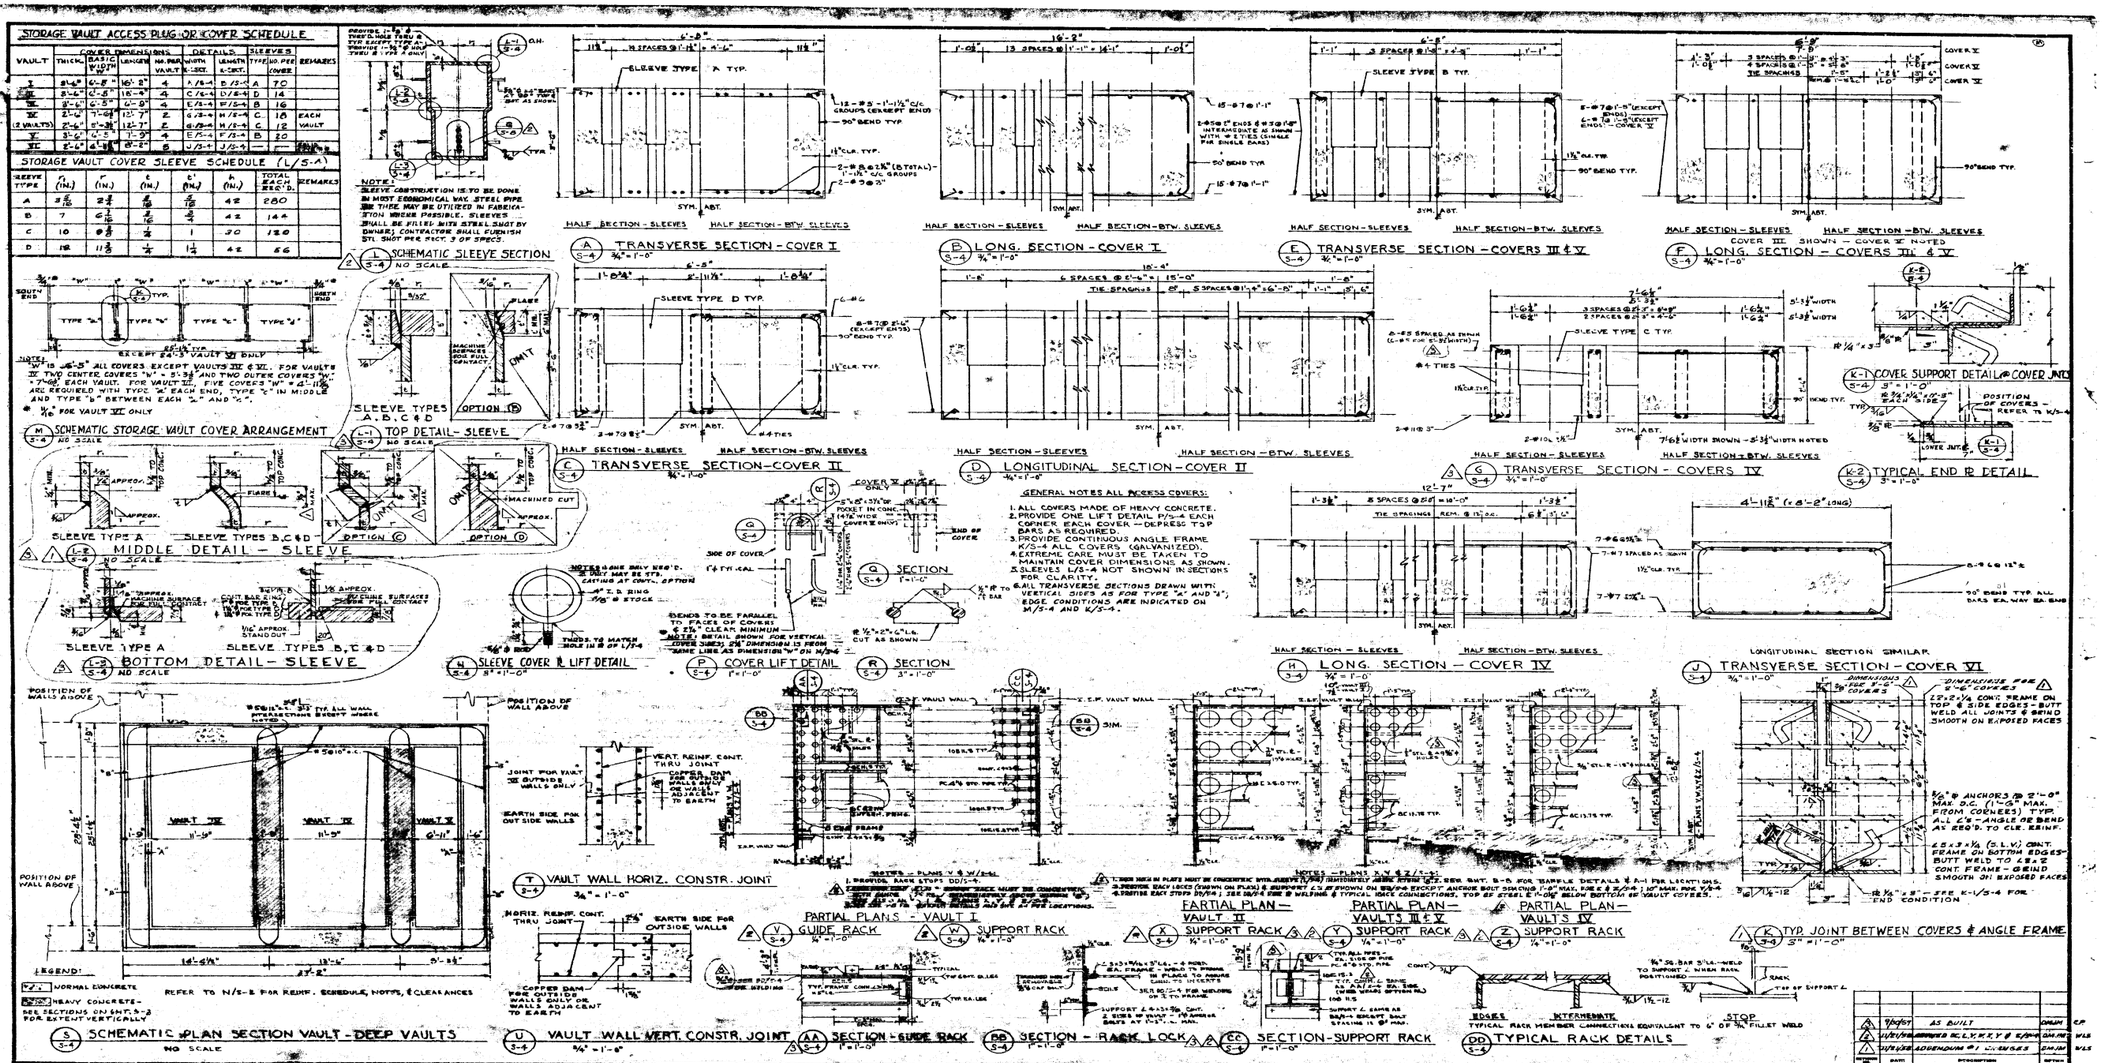

NO.	DATE	DESCRIPTION	DRAWN	BY
3	9/26/58	AS BUILT	DMJM	CP
2	11/21/58	REVISED SECS. V, X, Y & Z & SUPPORTS	DMJM	WLS
1	10/14/58	ADDENDUM #1 — CHANGES	DMJM	WLS

APPROVED: U.S. ATOMIC ENERGY COMMISSION

DANIEL, MANN, JOHNSON, & MENDENHALL
ARCHITECTS & ENGINEERS
3325 WILSHIRE BOULEVARD – LOS ANGELES 5, CALIFORNIA – TELEPHONE DUNKIRK 1-3663

PREPARED FOR: U.S. ATOMIC ENERGY COMMISSION
CHICAGO OPERATIONS OFFICE

JOB TITLE: R/A WASTE AND FUEL STORAGE
SANTA SUSANA, CALIFORNIA

SHEET TITLE: MISCELLANEOUS VAULT DETAILS

DRAWN BY: J. CASSIDY
JOB NO.: 204-1-1
CHECKED BY: J. CASSIDY
SHEET NO.: S-4
APPROVED BY: [illegible]
DATE: SEPT. 25, 1958

303-022-54

HALF SIZE PRINT