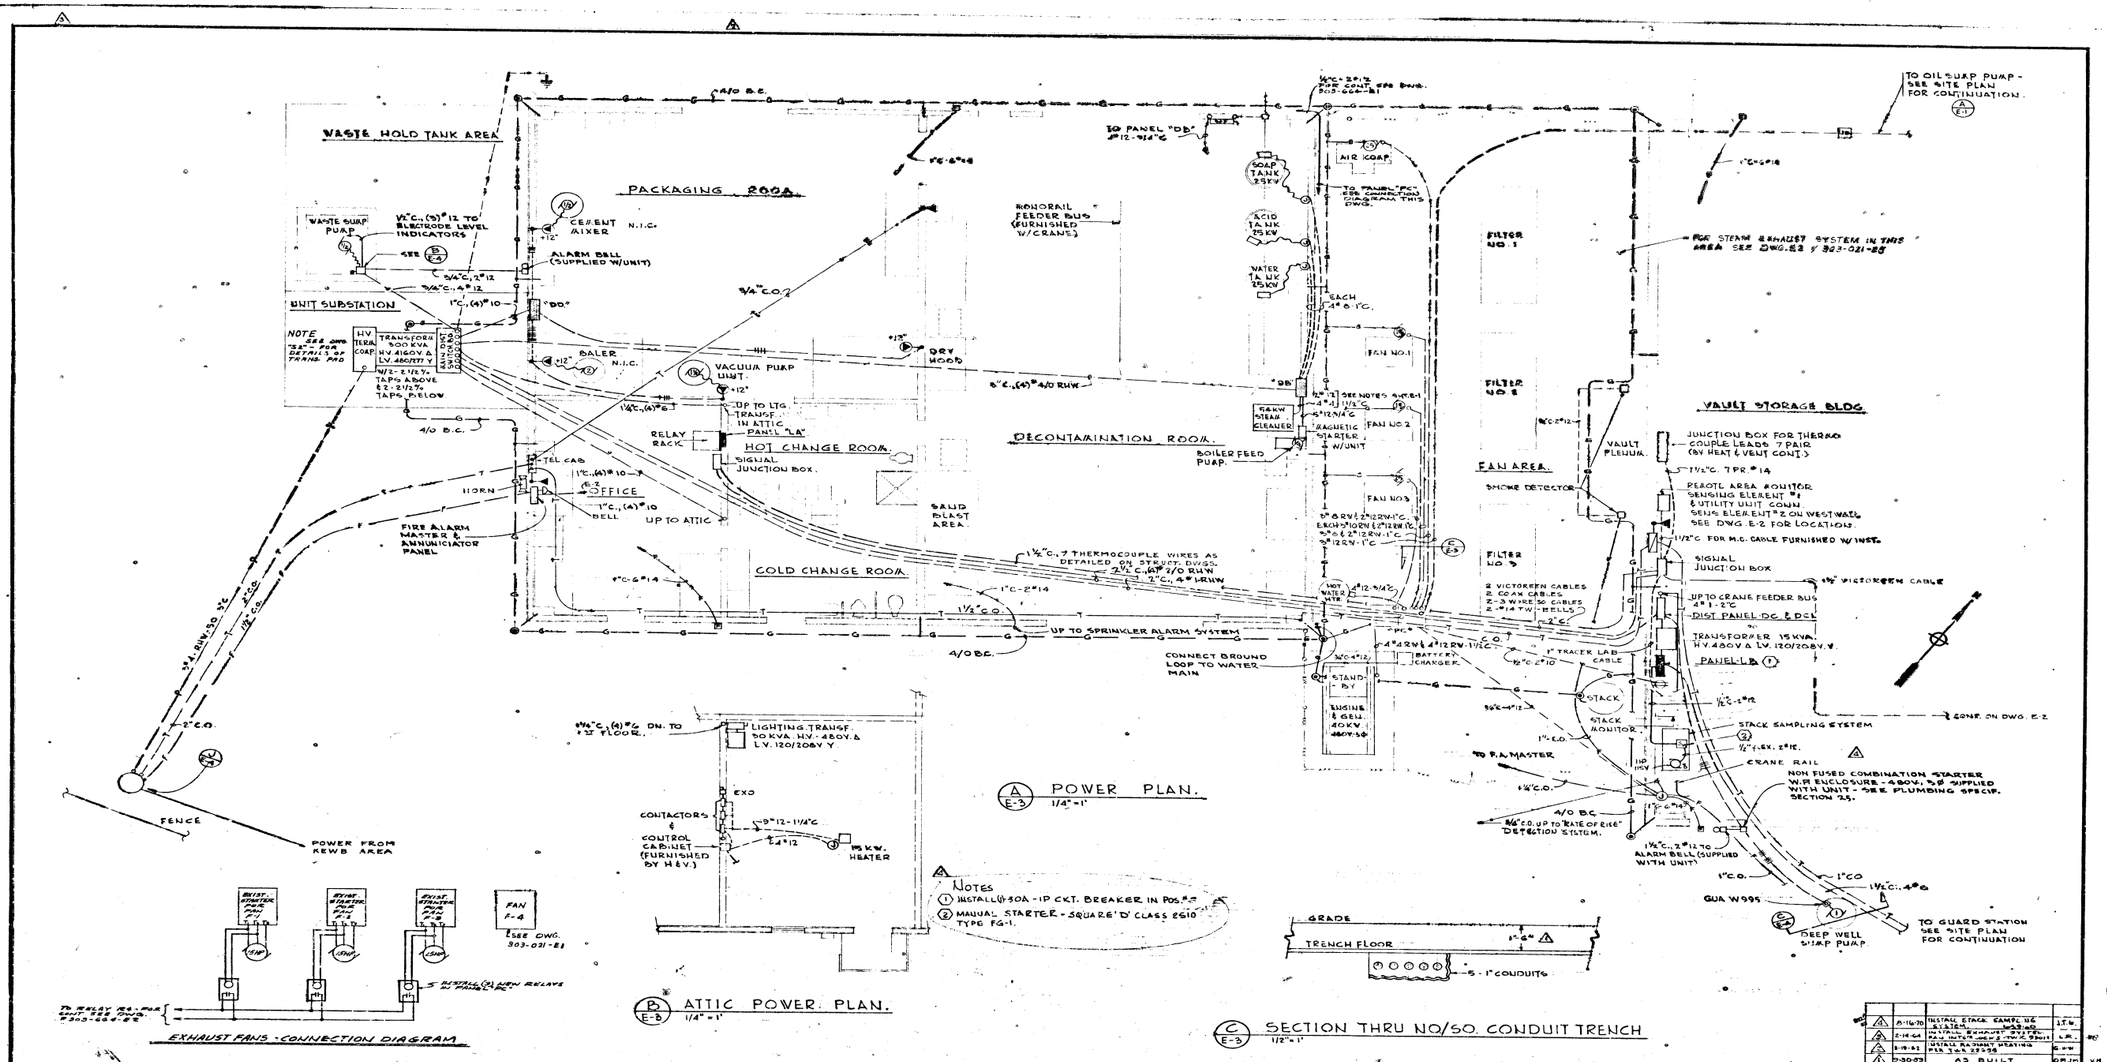

A E-3 POWER PLAN. 1/4" = 1'

B E-3 ATTIC POWER PLAN. 1/4" = 1'

C E-3 SECTION THRU NO/SO. CONDUIT TRENCH 1/2" = 1'

REVISION	DATE	DESCRIPTION	DRAWN
1	8-16-70	INSTALL STACK SAMPLING SYSTEM	J.T.G.
2	2-14-64	INSTALL EXHAUST SYSTEM	L.R.
3	1-8-61	INSTALL 2 SMOKE DETECTORS PER S.A.S. 22598	E.W.
4	7-30-03	AS BUILT	DRJH

APPROVED: U. S. ATOMIC ENERGY COMMISSION

DANIEL, MANN, JOHNSON, & MENDENHALL
ARCHITECTS & ENGINEERS
3325 WILSHIRE BOULEVARD - LOS ANGELES 5, CALIFORNIA - TELEPHONE DUNKIRK 1-3663

PREPARED FOR: U.S. ATOMIC ENERGY COMMISSION
CHICAGO OPERATIONS OFFICE

JOB TITLE: R/A WASTE AND FUEL STORAGE
SANTA SUSANA, CALIFORNIA

SHEET TITLE: POWER (480/277 VOLT) PLAN

DRAWN BY: T. GREEL
CHECKED BY: D. MILLER
APPROVED BY: James G. Chantry
JOB NO. 204-1-1
SCALE: 1/4"
DATE: SEPT. 25, 1958

303-022-E3

HALF SIZE PRINT

VELLUM REPRO