


A S-7 RAKE DETAIL
3/4" = 1'-0"

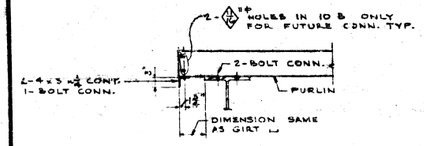


B S-7 PURLIN CONN.
3/4" = 1'-0"




C S-7 STRUT ELEVATION
1 1/2" = 1'-0"

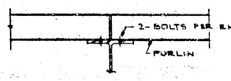


D S-7 STRUT DETAIL
1 1/2" = 1'-0"

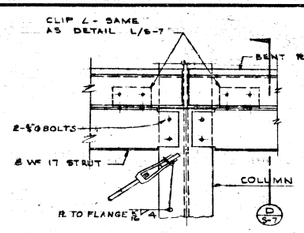


1 E S-7 STRUT DETAIL
1" = 1'-0"

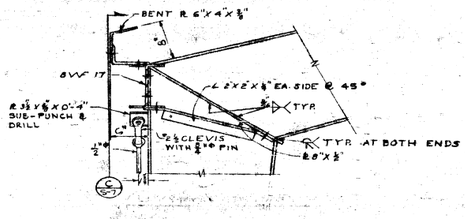


F S-7 CORNER DETAIL
3/4" = 1'-0"

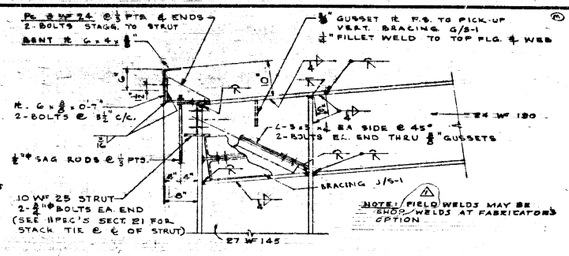


G S-7 GIRT CONN.
3/4" = 1'-0"

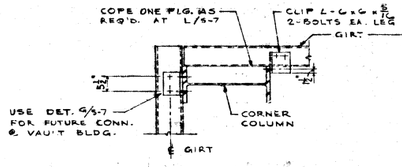


H S-7 BASE R DETAIL
3" = 1'-0"

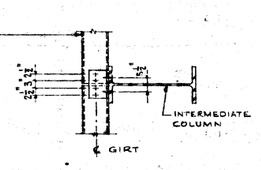


J S-7 RIDGE DETAIL
1 1/2" = 1'-0"

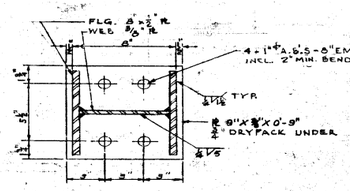


K S-7 ELEVATION
1" = 1'-0"

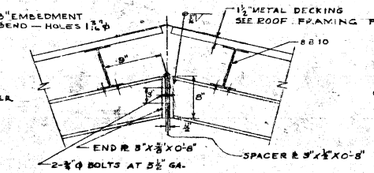


L S-7 STRUT CONN.
1" = 1'-0"

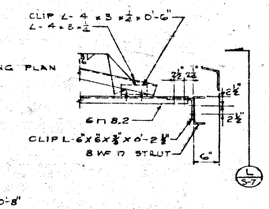


M S-7 SAG ROD DETAIL
1" = 1'-0"

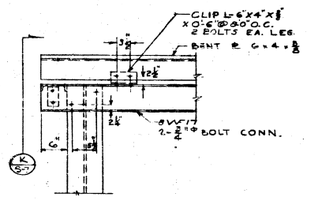


N S-7 ELEVATION
1" = 1'-0"

P S-7 STRUT CONN.
1" = 1'-0"

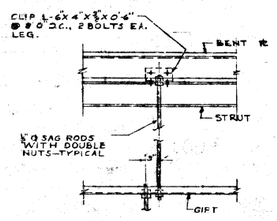


R S-7 BASE R DETAIL
1" = 1'-0"
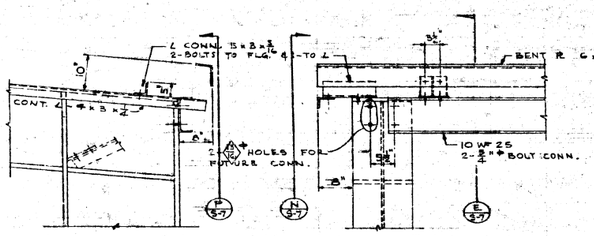
| | | | | |
|---|---|---|---|---|
| 1 | 7/1959 | AS BUILT | CB-LW | EP |
| NO. | DATE | DESCRIPTION | DRAWN | APPROVED |

APPROVED: U.S. ATOMIC ENERGY COMMISSION
T. E. Shipman Lt. Col. 9-25-58

William J. Lemmon Jr. 9/24/58

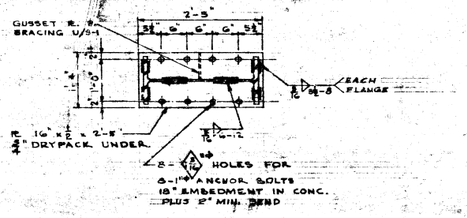DANIEL, MANN, JOHNSON, & MENDENHALL
ARCHITECTS & ENGINEERS
3325 WILSHIRE BOULEVARD – LOS ANGELES 5, CALIFORNIA – TELEPHONE DUNKIRK 1-3663

PREPARED FOR: U.S. ATOMIC ENERGY COMMISSION
CHICAGO OPERATIONS OFFICE

JOB TITLE: R/A WASTE AND FUEL STORAGE
SANTA SUSANA, CALIFORNIA

SHEET TITLE: STRUCTURAL STEEL DETAILS

| | |
|---|---|
| DESIGNED BY | MILLS |
| CHECKED BY | J. CASSIDY |
| APPROVED BY | |
| JOB NO. | 204-1-1 |
| SHEET NO. | S-7 |
| DATE | SEPT 25 1958 |

303-022-57

HALF SIZE PRINT