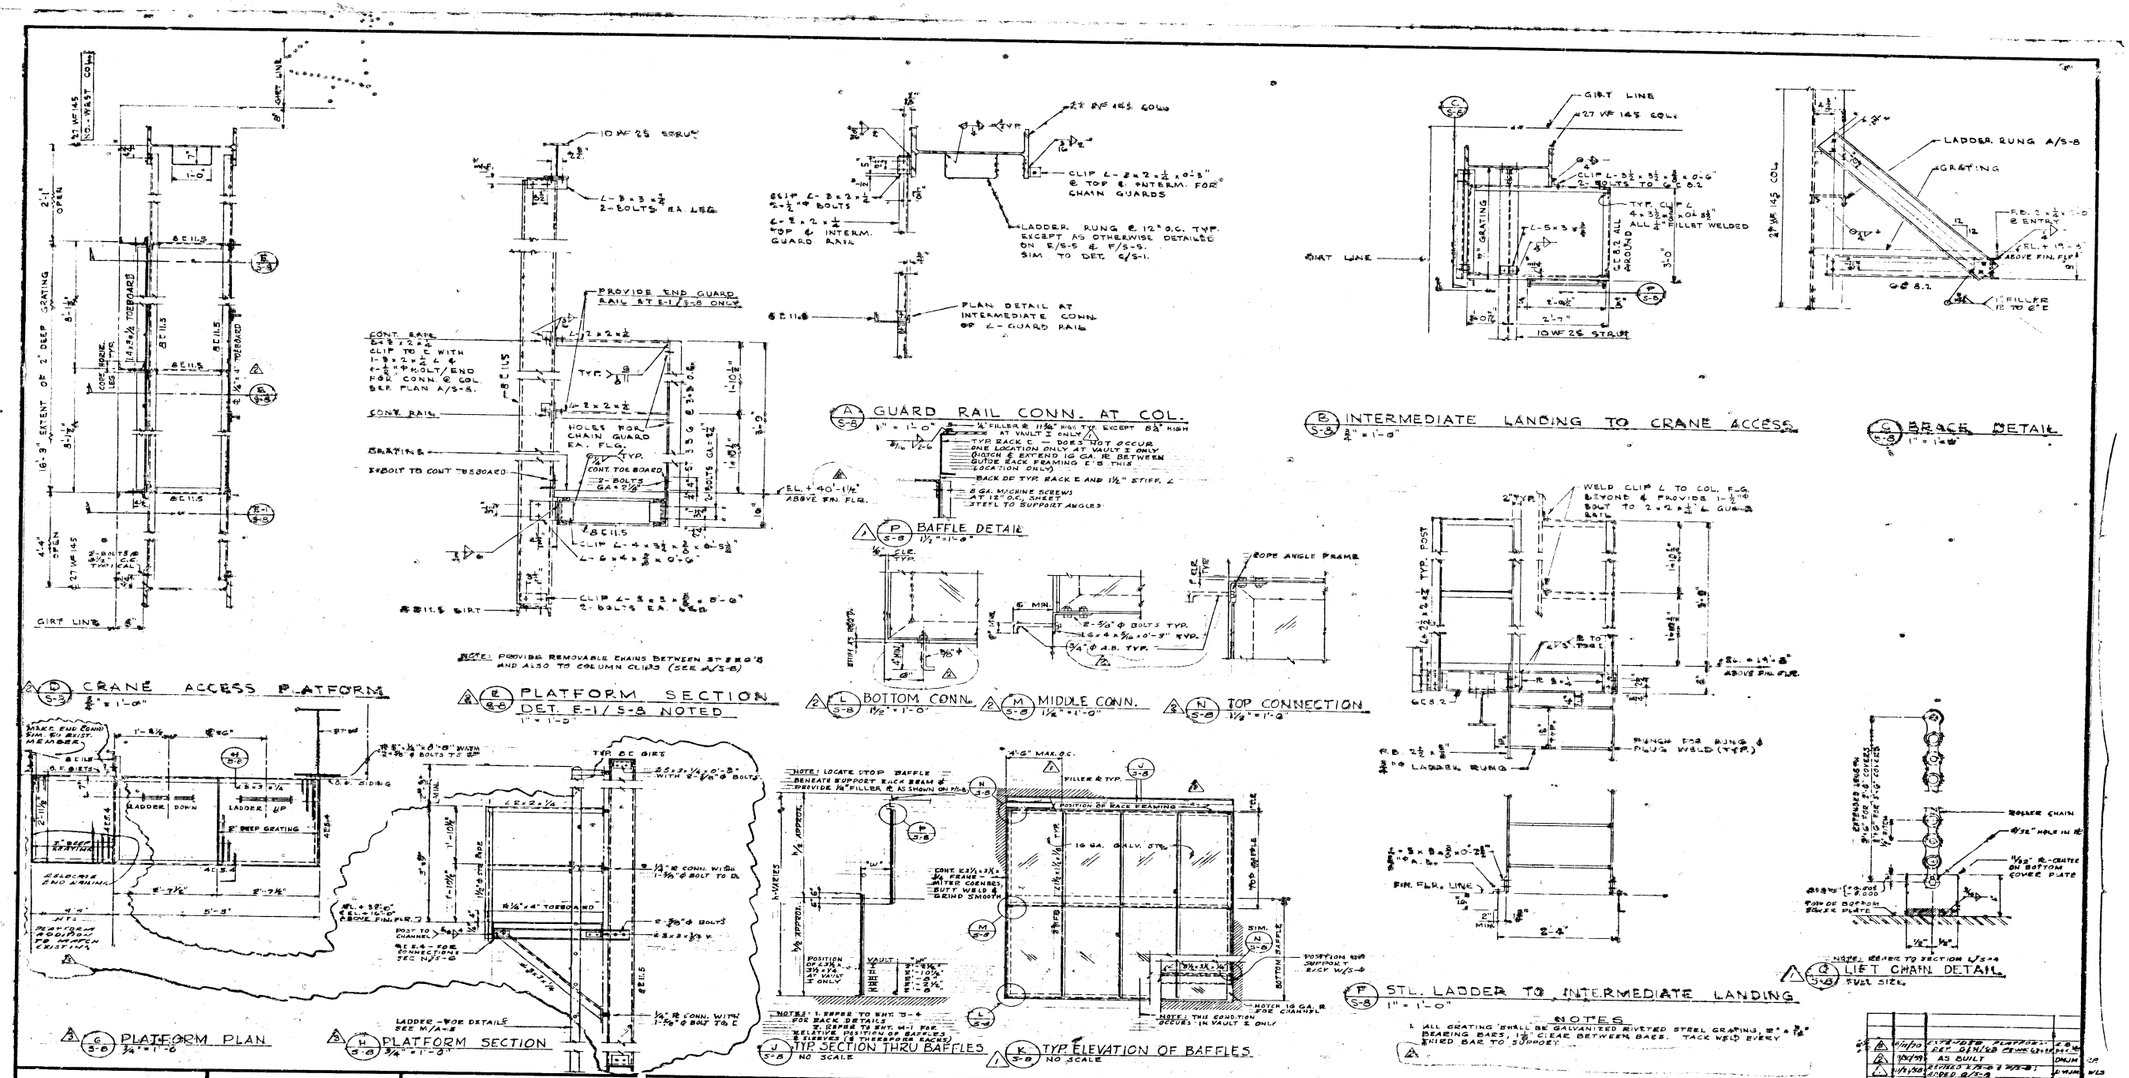

APPROVED:
U.S. ATOMIC ENERGY COMMISSION
CHICAGO OPERATIONS OFFICE
9-25-58

DANIEL, MANN, JOHNSON, & MENDENHALL
ARCHITECTS & ENGINEERS
3375 WILSHIRE BOULEVARD – LOS ANGELES 5, CALIFORNIA – TELEPHONE DUNKIRK 1-3663

PREPARED FOR
U.S. ATOMIC ENERGY COMMISSION
CHICAGO OPERATIONS OFFICE

JOB TITLE: R/A WASTE AND FUEL STORAGE
SANTA SUSANA, CALIFORNIA

SHEET TITLE: MISCELLANEOUS STEEL DETAILS

REV. NO.	DATE	DESCRIPTION	DRAWN	CHKD.
4	10/1/59	AS BUILT	DRJM	
3	10/1/58	REVISED PER CHANGE NOTICE 10	DRJM	JR
2	10/1/58	REVISED PER CHANGE NOTICE 9	DRJM	WLS
1	10/1/58	REVISED PER CHANGE NOTICE 8	DRJM	

DRAWN BY: L. MILLS
JOB NO.: 204-7-2
SUPERVISED BY: J. CASSIDY
SHEET NO.: S-8
APPROVED BY: James R. Dunlap
DATE: SEPT. 25, 1958
303-022-S8

HALF SIZE PRINT

VELLUM RELEASE