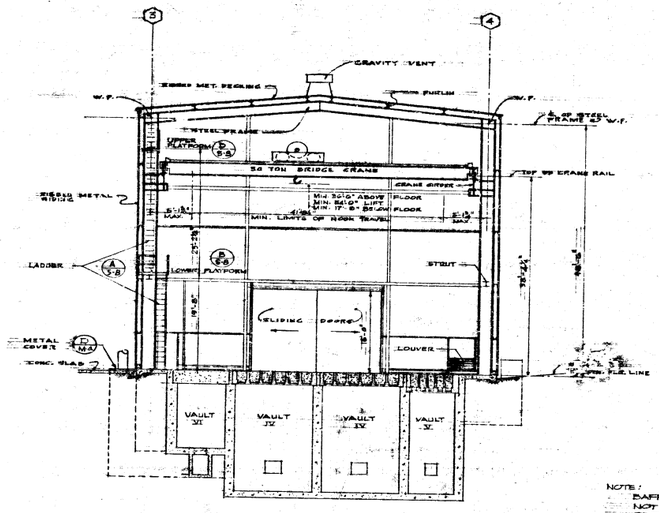

STORAGE VAULT BUILDING

A/A-4 SECTION

1/8" = 1'-0"

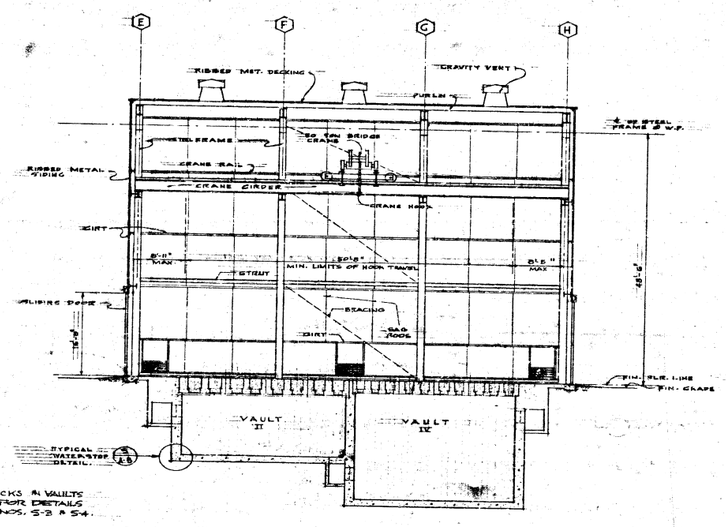

NOTE:
BAFFLES & RACKS IN VAULTS NOT SHOWN. FOR DETAILS SEE SHEETS NOS. S-3 & S-4.

STORAGE VAULT BUILDING

D/A-4 SECTION

1/8" = 1'-0"

FINISH SCHEDULE

ROOM	FLOOR: CONCRETE	FLOOR: ASPHALT TILE	FLOOR: METAL	FLOOR: TILE, CERAMIC	BASE: CONCRETE	BASE: RUBBER	BASE: METAL	WAINSCOT	WALLS: CEM. PLASTER	WALLS: TILE, CERAMIC	WALLS: EXPOSED	CEILING: CEM. PLASTER	CEILING: EXPOSED	PAINT	REMARKS
SERVICE		●							●			●		SEE SPEC.	THIS AREA TO BE REARRANGED ⚠1
COLD CHANGE	●	●		●		●			●	●		●		SEE SPEC.	
HOT CHANGE	●	●		●		●			●	●		●		SEE SPEC.	
PACKAGING ROOM	●			●		●			●			●		SEE SPEC.	
DECONTAMINATION ROOM			●				●		●			●		SEE SPEC.	
ATTIC PLATFORM			●								●		●	SEE SPEC.	
STORAGE VAULT BUILDING	●					●					●		●	SEE SPEC.	8'-0" HIGH ABS BALANCE

ROOM	FLOOR: CONCRETE	FLOOR: ASPHALT TILE	FLOOR: METAL	FLOOR: TILE, CERAMIC	BASE: CONCRETE	BASE: RUBBER	BASE: METAL	WAINSCOT	WALLS: CEM. PLASTER	WALLS: TILE, CERAMIC	WALLS: EXPOSED	CEILING: CEM. PLASTER	CEILING: EXPOSED	PAINT	REMARKS
READY ROOM		●							●			●		SEE SPEC.	
COLD LAB		●							●			●		SEE SPEC.	
HOT LAB		●			●				●			●		SEE SPEC.	
TOILET AREA		●		●	●		●		●	●		●		SEE SPEC.	

APPROVED:
U. S. ATOMIC ENERGY COMMISSION
9-25-58

William J. Lemmer Jr. Mgr.

DANIEL, MANN, JOHNSON, & MENDENHALL
ARCHITECTS & ENGINEERS
3325 WILSHIRE BOULEVARD - LOS ANGELES 5, CALIFORNIA - TELEPHONE DUNKIRK 1-3663

U.S. ATOMIC ENERGY COMMISSION
CHICAGO OPERATIONS OFFICE

R/A WASTE AND FUEL STORAGE
SANTA SUSANA, CALIFORNIA
SECTIONS & FINISH SCHEDULE

⚠1	9-26-58	REVISED AS NOTED PER W.J.L. 9-25-58	MB
		AS BUILT - NO CHANGES	DRJM

DRAWN BY T.T. OLIVER
CHECKED BY DRAWLANTER
DESIGNED BY
DATE SEPT. 25, 1958
JOB NO. 204-1-1
SHEET NO.
303-022-A4

HALF SIZE PRINT