REVISIONS			
SYM	DESCRIPTION	DATE	SIGNATURE
1	INDICATED 8" GAS LINE - ADDED SPECIAL NOTE	5/16/62	PENCE
2	FLOOR ELEV. CHANGED TO "AS BUILT"	7/6/62	RIVERS
3	ADDED BLDG 044 + SEWER LINE EXTENDED WATER LINE + GAS LINE T.W.R. 22648	4/19/64	BLARASTA

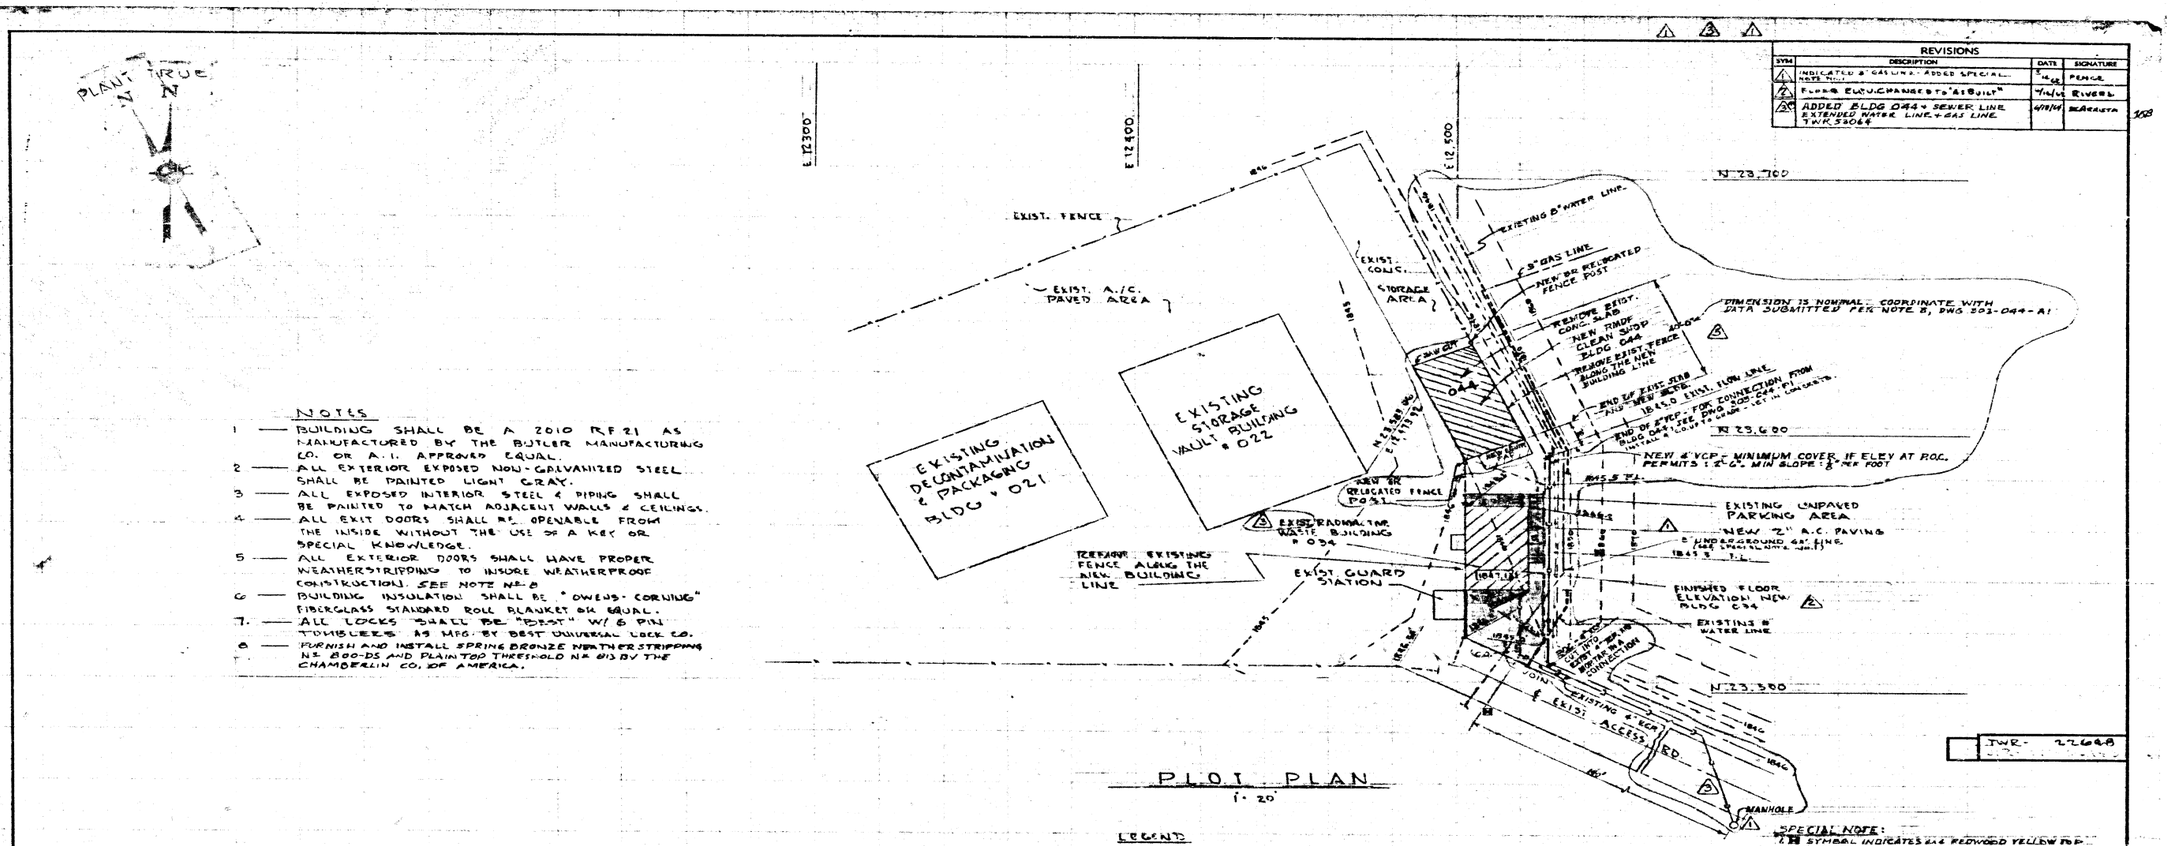

NOTES

1 — BUILDING SHALL BE A 2010 RF 21 AS MANUFACTURED BY THE BUTLER MANUFACTURING CO. OR A.I. APPROVED EQUAL.
2 — ALL EXTERIOR EXPOSED NON-GALVANIZED STEEL SHALL BE PAINTED LIGHT GRAY.
3 — ALL EXPOSED INTERIOR STEEL & PIPING SHALL BE PAINTED TO MATCH ADJACENT WALLS & CEILINGS.
4 — ALL EXIT DOORS SHALL BE OPENABLE FROM THE INSIDE WITHOUT THE USE OF A KEY OR SPECIAL KNOWLEDGE.
5 — ALL EXTERIOR DOORS SHALL HAVE PROPER WEATHERSTRIPPING TO INSURE WEATHERPROOF CONSTRUCTION. SEE NOTE No. 8
6 — BUILDING INSULATION SHALL BE "OWENS-CORNING" FIBERGLASS STANDARD ROLL BLANKET OR EQUAL.
7. — ALL LOCKS SHALL BE "BEST" W/ 6 PIN TUMBLERS AS MFG. BY BEST UNIVERSAL LOCK CO.
8 — FURNISH AND INSTALL SPRING BRONZE WEATHERSTRIPPING No. 800-DS AND PLAIN TOP THRESHOLD No. 613 BY THE CHAMBERLIN CO. OF AMERICA.

PLOT PLAN
1" = 20'

LEGEND

- EXISTING CONDITIONS
- 1846.50 — NEW ELEVATION
- 1846 — EXISTING ELEVATION
- NEW 2" A.C. PAVING
- NEW BUILDING CONSTRUCTION
- EXISTING 8" WATER LINE
- 4" KCP
- 8" GAS LINE

T.W.R. - 22648

NOTICE

THIS DRAWING INVOLVES CONFIDENTIAL PROPRIETARY DESIGN INFORMATION OF ATOMICS INTERNATIONAL, A DIVISION OF NORTH AMERICAN AVIATION, INC. AND AS SUCH IS EXCLUSIVELY ENTRUSTED TO THE RECEIVING PERSONS. IT IS SUBMITTED UNDER A TRUST RELATIONSHIP FOR LIMITED PURPOSE. IT IS ASSUMED THAT IT WILL NOT BE USED FOR ANY OTHER PURPOSE, NOR BE DISCLOSED OR REVEALED TO ANYONE EXCEPT FOR THAT PURPOSE, NOR COPIED IN WHOLE OR IN PART. NOR ITS SUBJECT PURPOSES USED IN OTHER REGARDS, IF THIS IS RETURNED TO ATOMICS INTERNATIONAL WHEN NO LONGER REQUIRED OR UPON REQUEST.

ATOMICS INTERNATIONAL
A DIVISION OF NORTH AMERICAN AVIATION, INC.
8900 DESOTO AVENUE, CANOGA PARK, CALIF.

RADIOACTIVE WASTE FACILITY OFFICE BLDG — S.S. — PLOT PLAN

DRAWN				SIZE D	303-034-A1
CHECKED				SCALE	
ENGINEER					
APPROVED					

REDUCED DRAWING